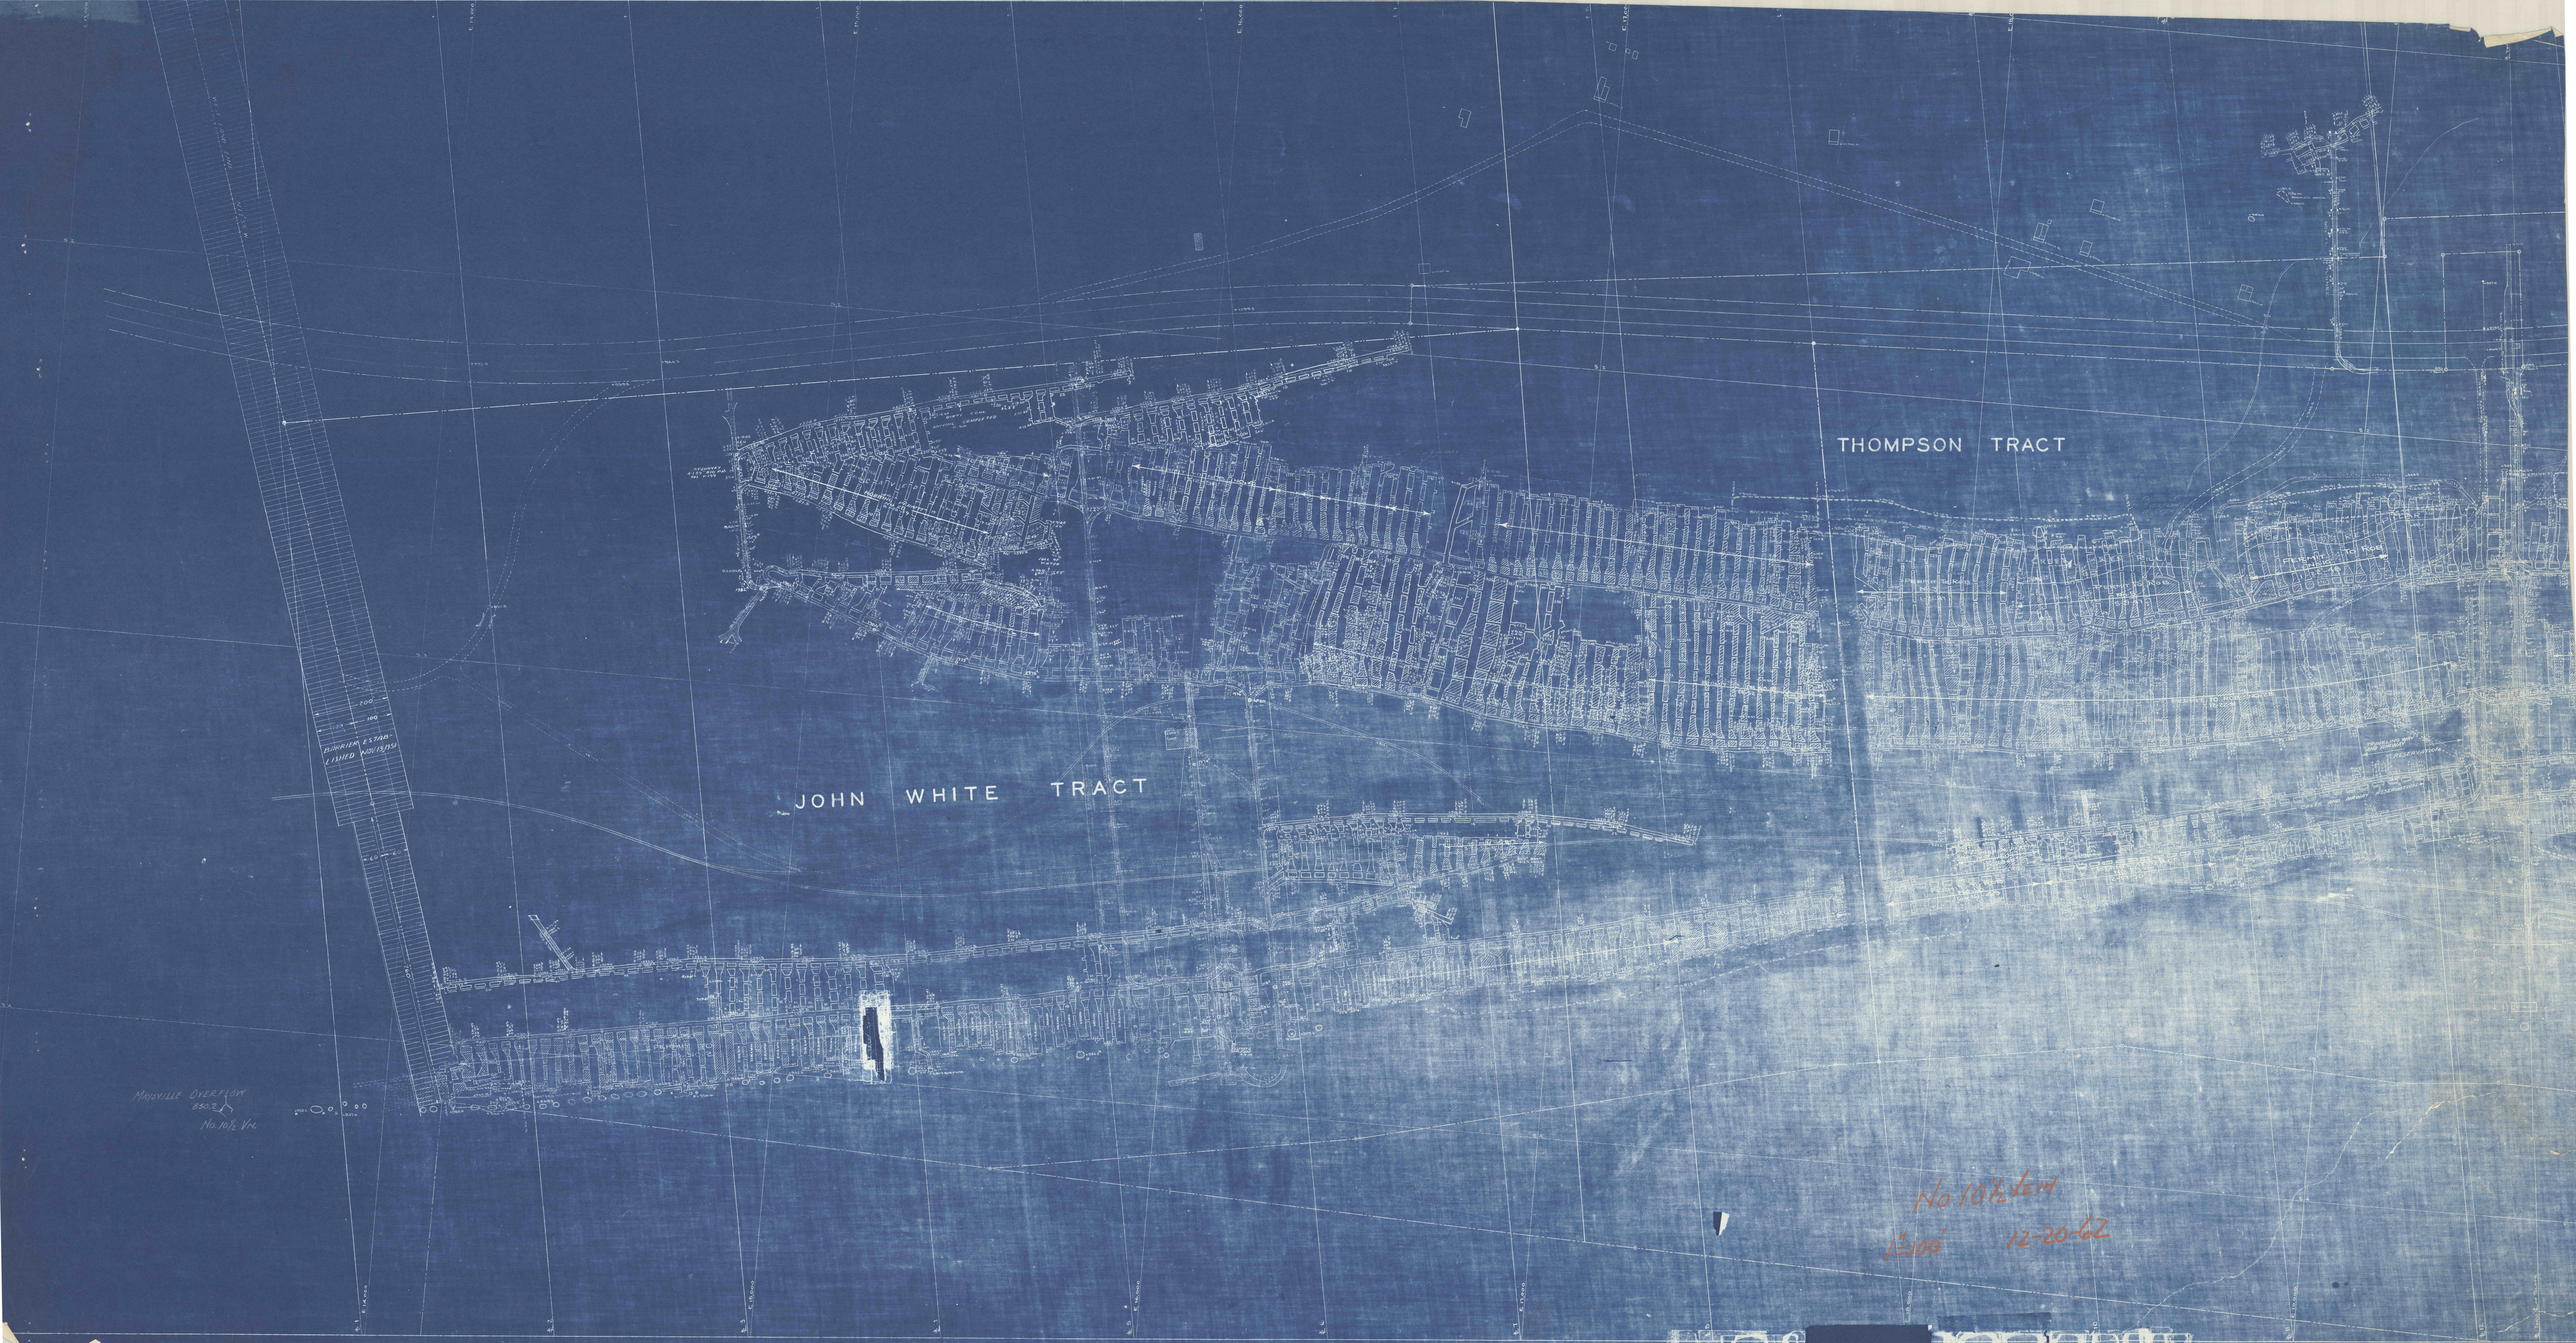
THOMPSON TRACT
JOHN WHITE TRACT
BARRIER ESTABLISHED NOV 15,1951
MAYVILLE OVERFLOW
No 10½ V4
No 10½ V4
15,00'
12-20-62