


SECTION
THRU
OLD LAWRENCE TUNNEL
LAWRENCE COLLIERY
SCALE 1" = 100'

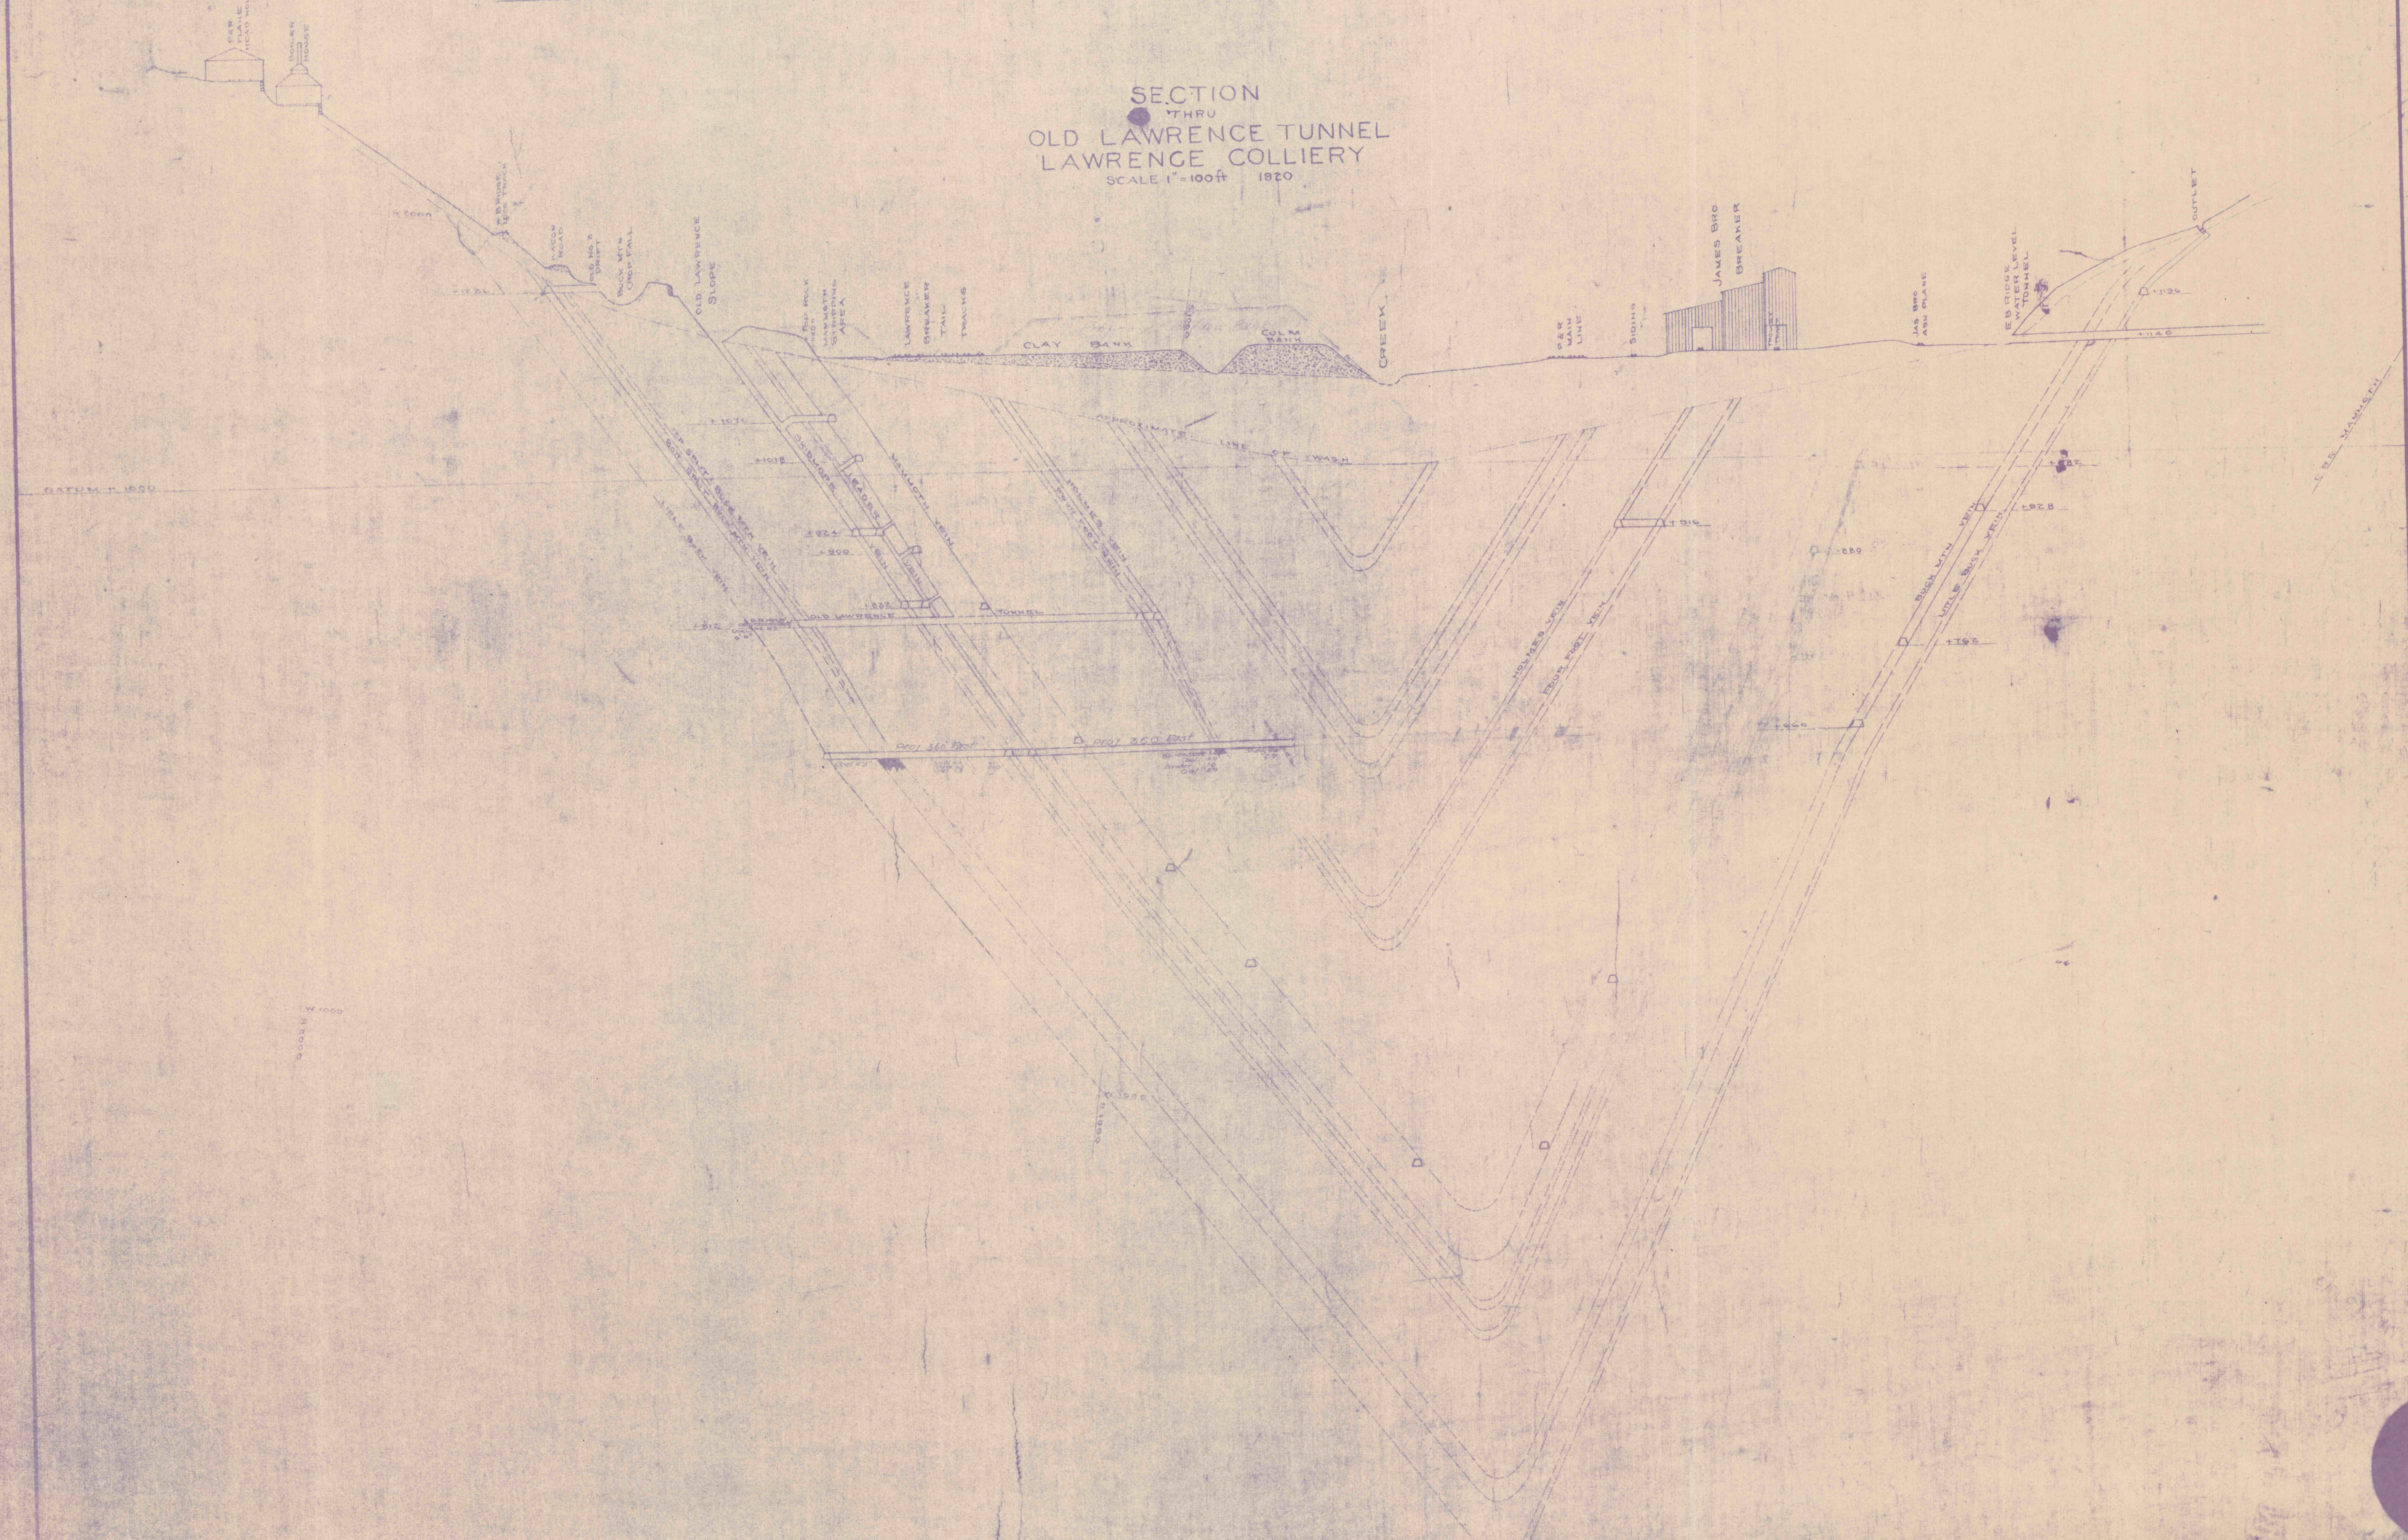

Lawrence Colliery