


STANTON COLLIERY
SECTION THROUGH LITHUANIAN CHURCH
AT MAIZEVILLE, PENN.

SCALE 1" = 100'
HARLEIGH-BROOKWOOD COAL CO.
MINRANO PLANE, PA.

POTTSVILLE, PA.

MARIL 8-1916

LOOKING EAST

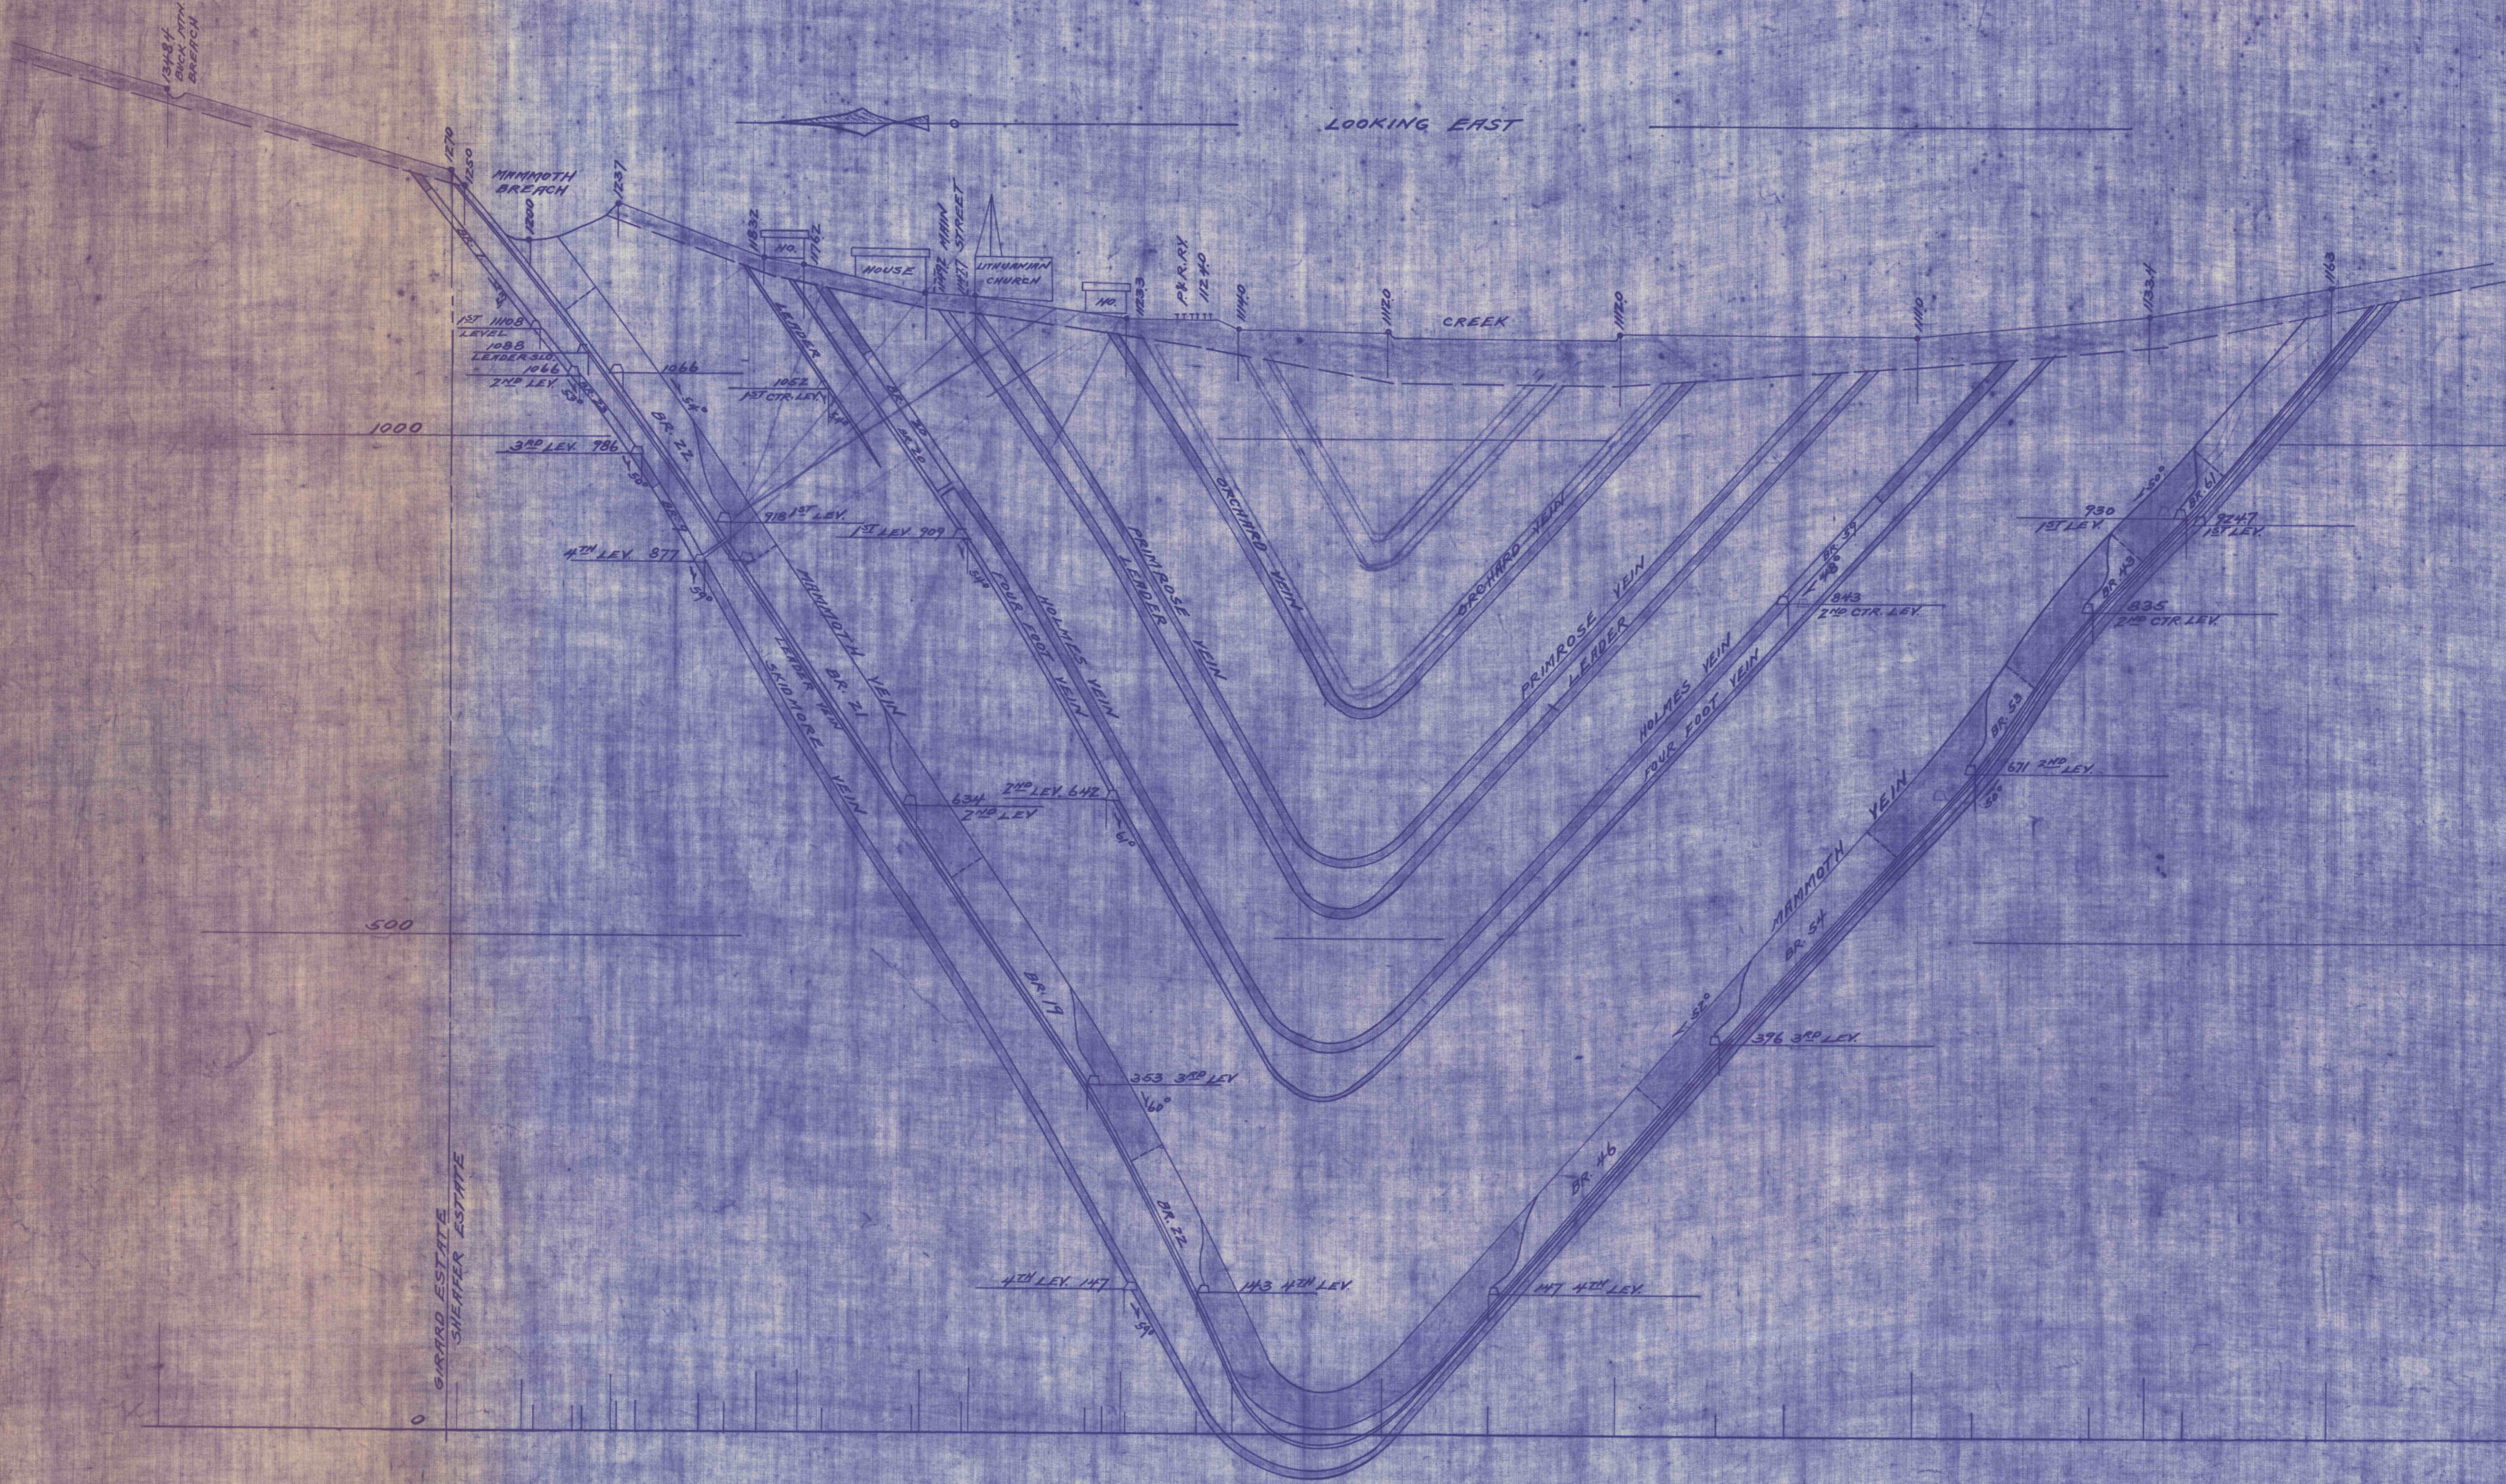

MAR 13 1916 MF

P. 218

MF
MAR 18 1916

P. 318