Western Middle Field

STANTON & LAWRENCE COLLIERIES

MAP OF FOUR FOOT & LEADER VEIN UNDER FOUR FOOT.

SCALE 1"=100'

HARLEIGH-BROOKWOOD COAL CO.
MAHANOY PLANE, PA.
WEST MAH. TWP. SCHUYLKILL COUNTY.
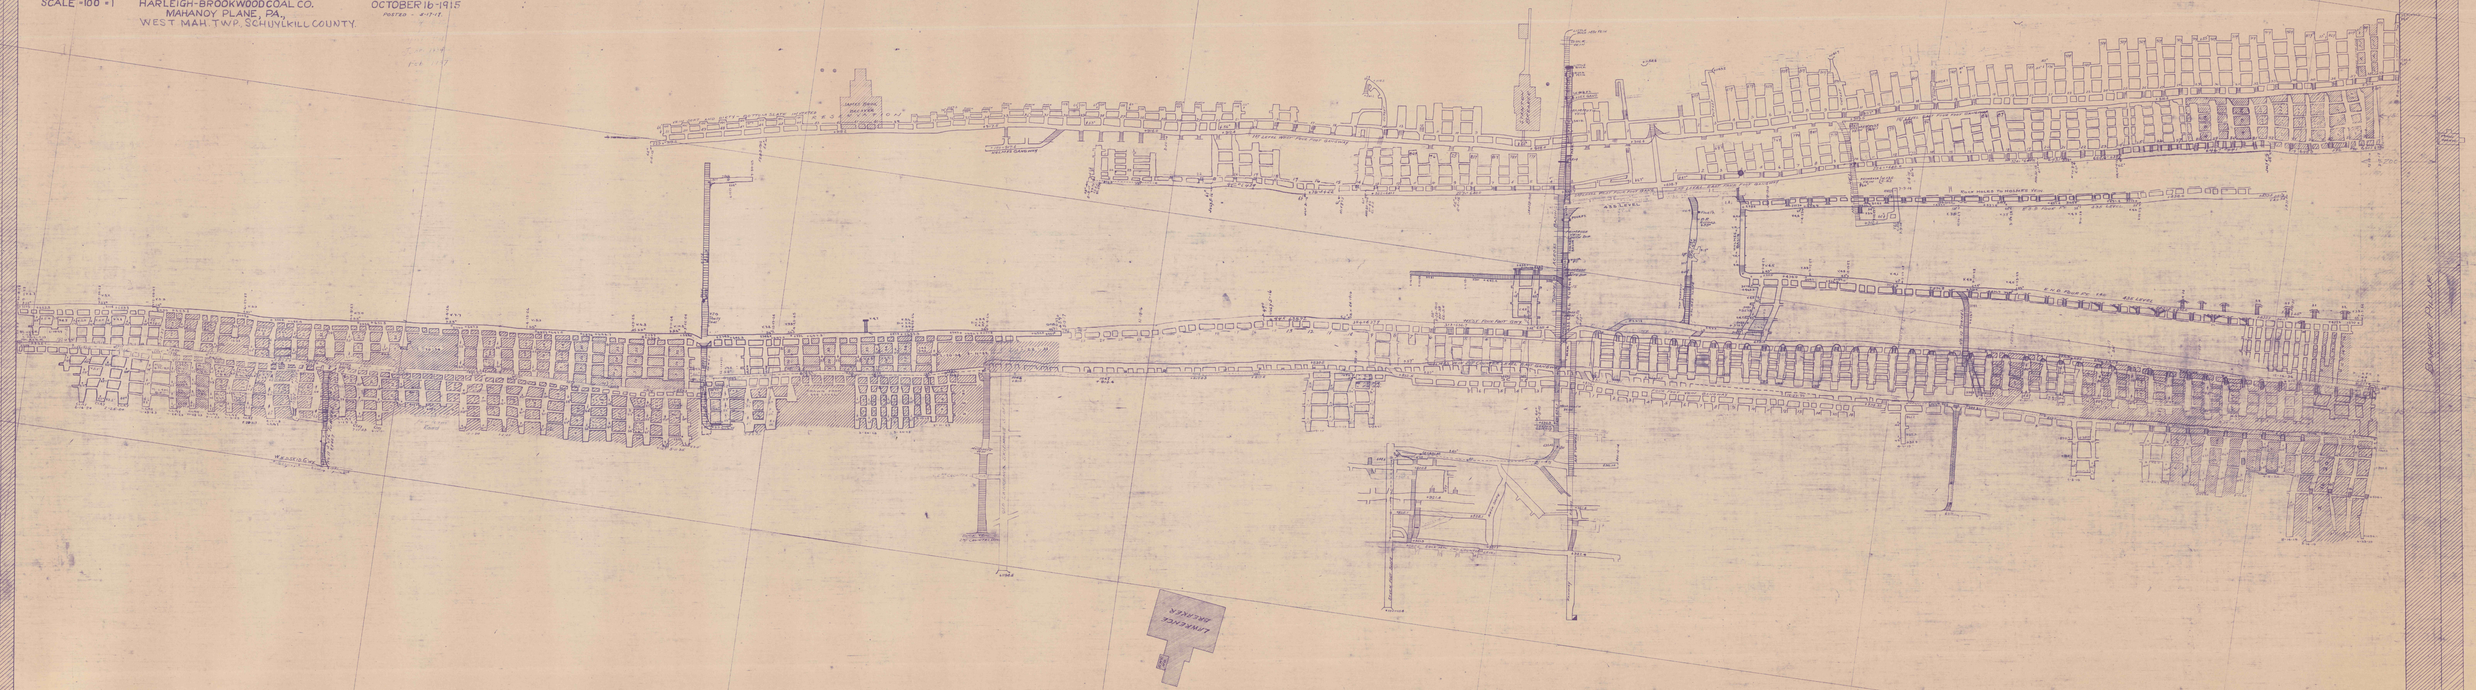
OCTOBER 16-1915
PASTED - 4-17-17