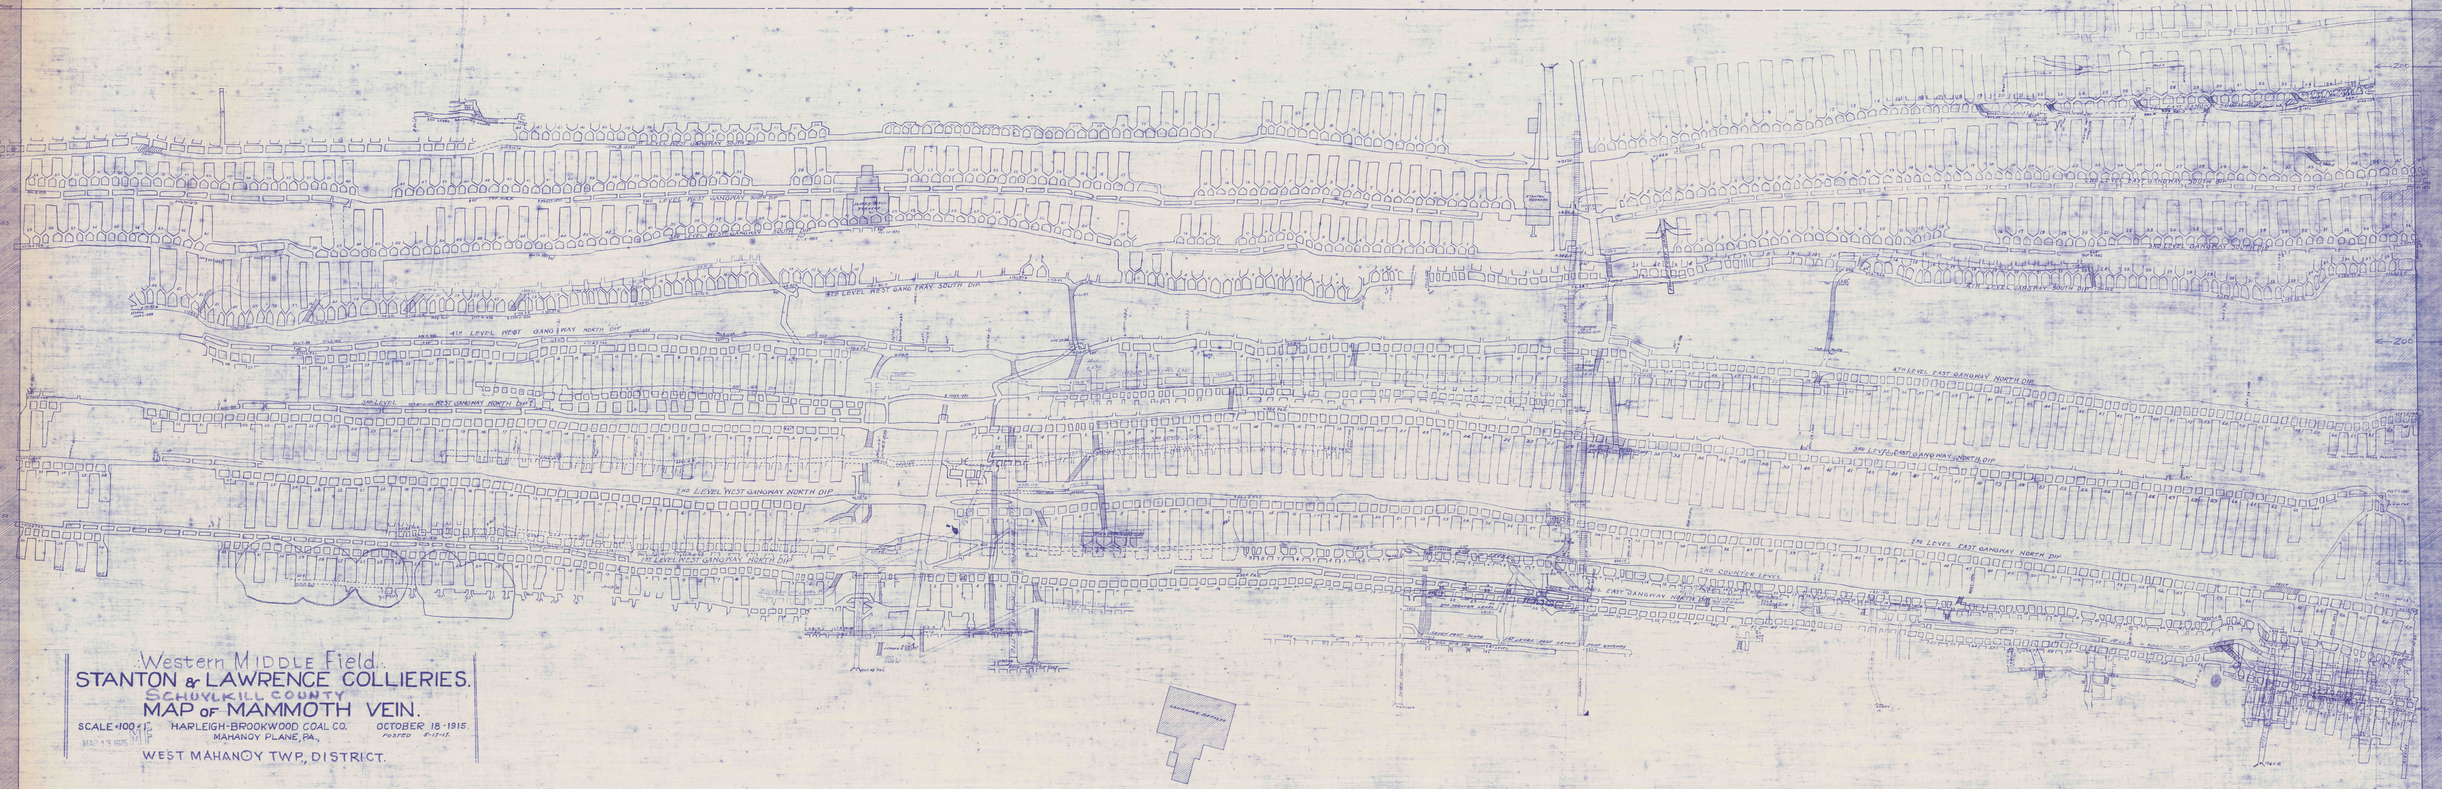
Western MIDDLE Field.
STANTON & LAWRENCE COLLIERIES.
SCHUYLKILL COUNTY
MAP OF MAMMOTH VEIN.
SCALE 1"=100'
HARLEIGH-BROOKWOOD COAL CO.
MAHANOY PLANE, PA.
OCTOBER 18-1915.
WEST MAHANOY TWP. DISTRICT.
4TH LEVEL WEST GANGWAY NORTH DIP
2ND LEVEL WEST GANGWAY NORTH DIP
2ND LEVEL EAST GANGWAY NORTH DIP
2ND COUSTER LEVEL