| B.H.# | ELEV. | EAST | NORTH | RED ASH | CLAY | SILT | SOFT | REFUSE | TOTAL | REMARKS |
|---|---|---|---|---|---|---|---|---|---|---|
| 1 | 1151.37 | 2+37.84 | 14+99.47 | 12' | - | | | | 12' | CLOSED |
| 2 | 1154.1 | 1+76.30 | 15+02.77 | 30' | 5' | | | | 35' | CLOSED AT 27' |
| 3 | 1149.77 | 2+91.74 | 14+93.63 | 25' | | | | | 25' | " " 16' |
| 4 | 1146.97 | 3+18.87 | 14+33.58 | 18' | | | | | 18' | " AT SURFACE |
| 5 | 1147.97 | 2+46.87 | 14+42.78 | 15' | | | | | 15' | " " " |
| 6 | 1149.97 | 1+76.00 | 14+42.55 | 52' | | 10' | 8' | | 70' | " " 53' |
| 7 | 1149.57 | 1+15.77 | 14+36.77 | 35' | | | | | 35' | CLOSED AT 11' |
| 8 | 1150.47 | 0+63.80 | 14+32.50 | 25' | | | | | 25' | " " 8' |
| 9 | 1150.2 | 1+82.11 | 13+83.90 | 50' | | | | | 50' | " " 30' |
| 10 | 1147.37 | 2+55.84 | 13+79.02 | 62' | | 18' | | | 80' | " " 63' |
| 11 | 1147.37 | 1+99.81 | 13+39.99 | 70' | | 17' | | | 87' | " " 72' |
| 12 | 1148.07 | 1+34.79 | 13+42.49 | 55' | | 20' | 5' | | 80' | " " 56' |
| 13 | 1135.97 | 2+07.51 | 12+91.39 | 65' | | 10' | | | 75' | " " 61' |
| 14 | 1140.57 | 2+72.11 | 13+35.79 | 50' | | 25' | | | 75' | " " 54' |
| 15 | 1129.8 | 4+14.37 | 14+09.13 | 30' | | | 20' | | 50' | " " 31' |
| 16 | 1141.64 | 5+45.27 | 15+46.36 | | | | | 45' | 45' | " " 41' |

ALL ABOVE ADDED TO SECTIONS 12·5·75

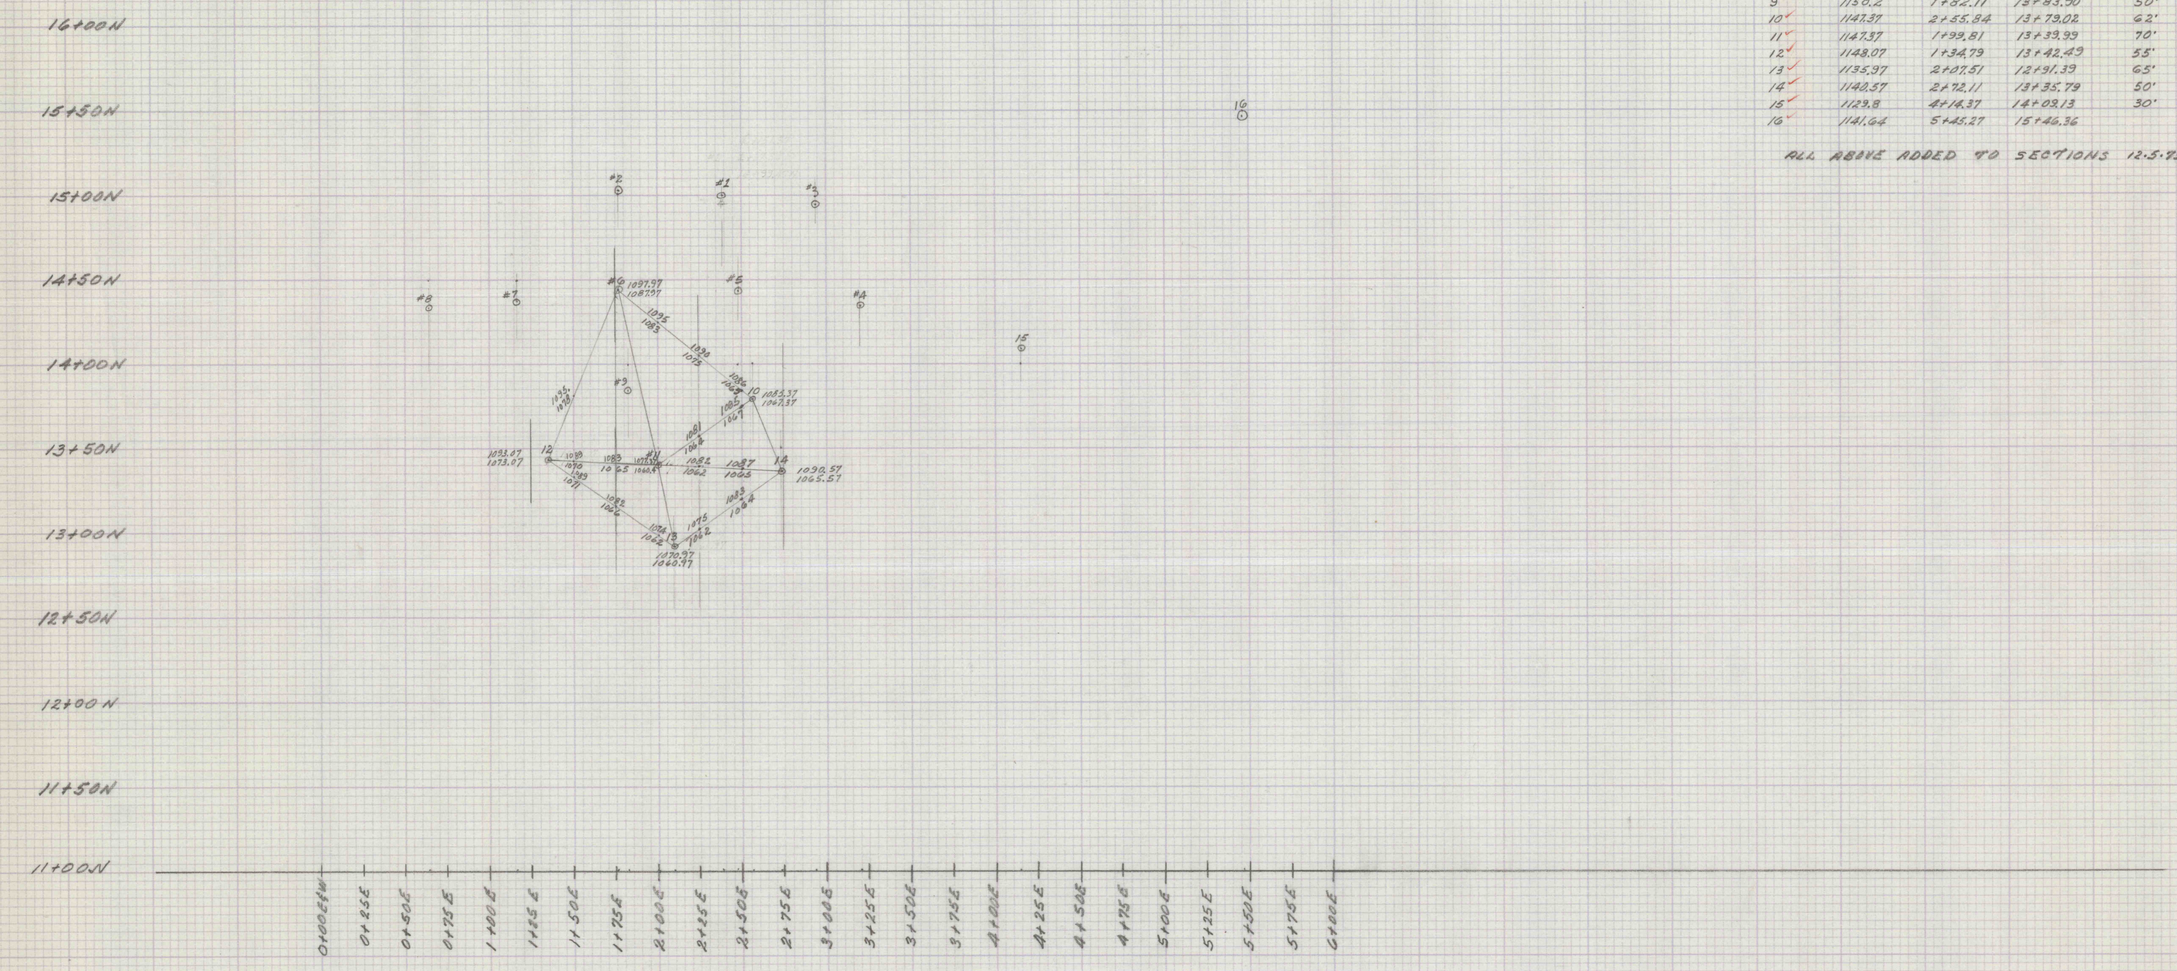


DAILY ACCOMPLISHMENT REPORTS
JUNE 2, 1975 INDICATES BOREHOLES #14, 15 & 16

WILLIAMSTOWN SL-211A
LOCATION OF BOREHOLES
LIMIT OF SILT
BOOK #3, PAGE 77, DATED 8·26·75

SCALE 1" = 50'
12·5·75 MMZ

NOTE: SEE OTHER DRILL HOLE LOCATIONS IN BOOK 6A, PAGE 75, DATED 6·30·75