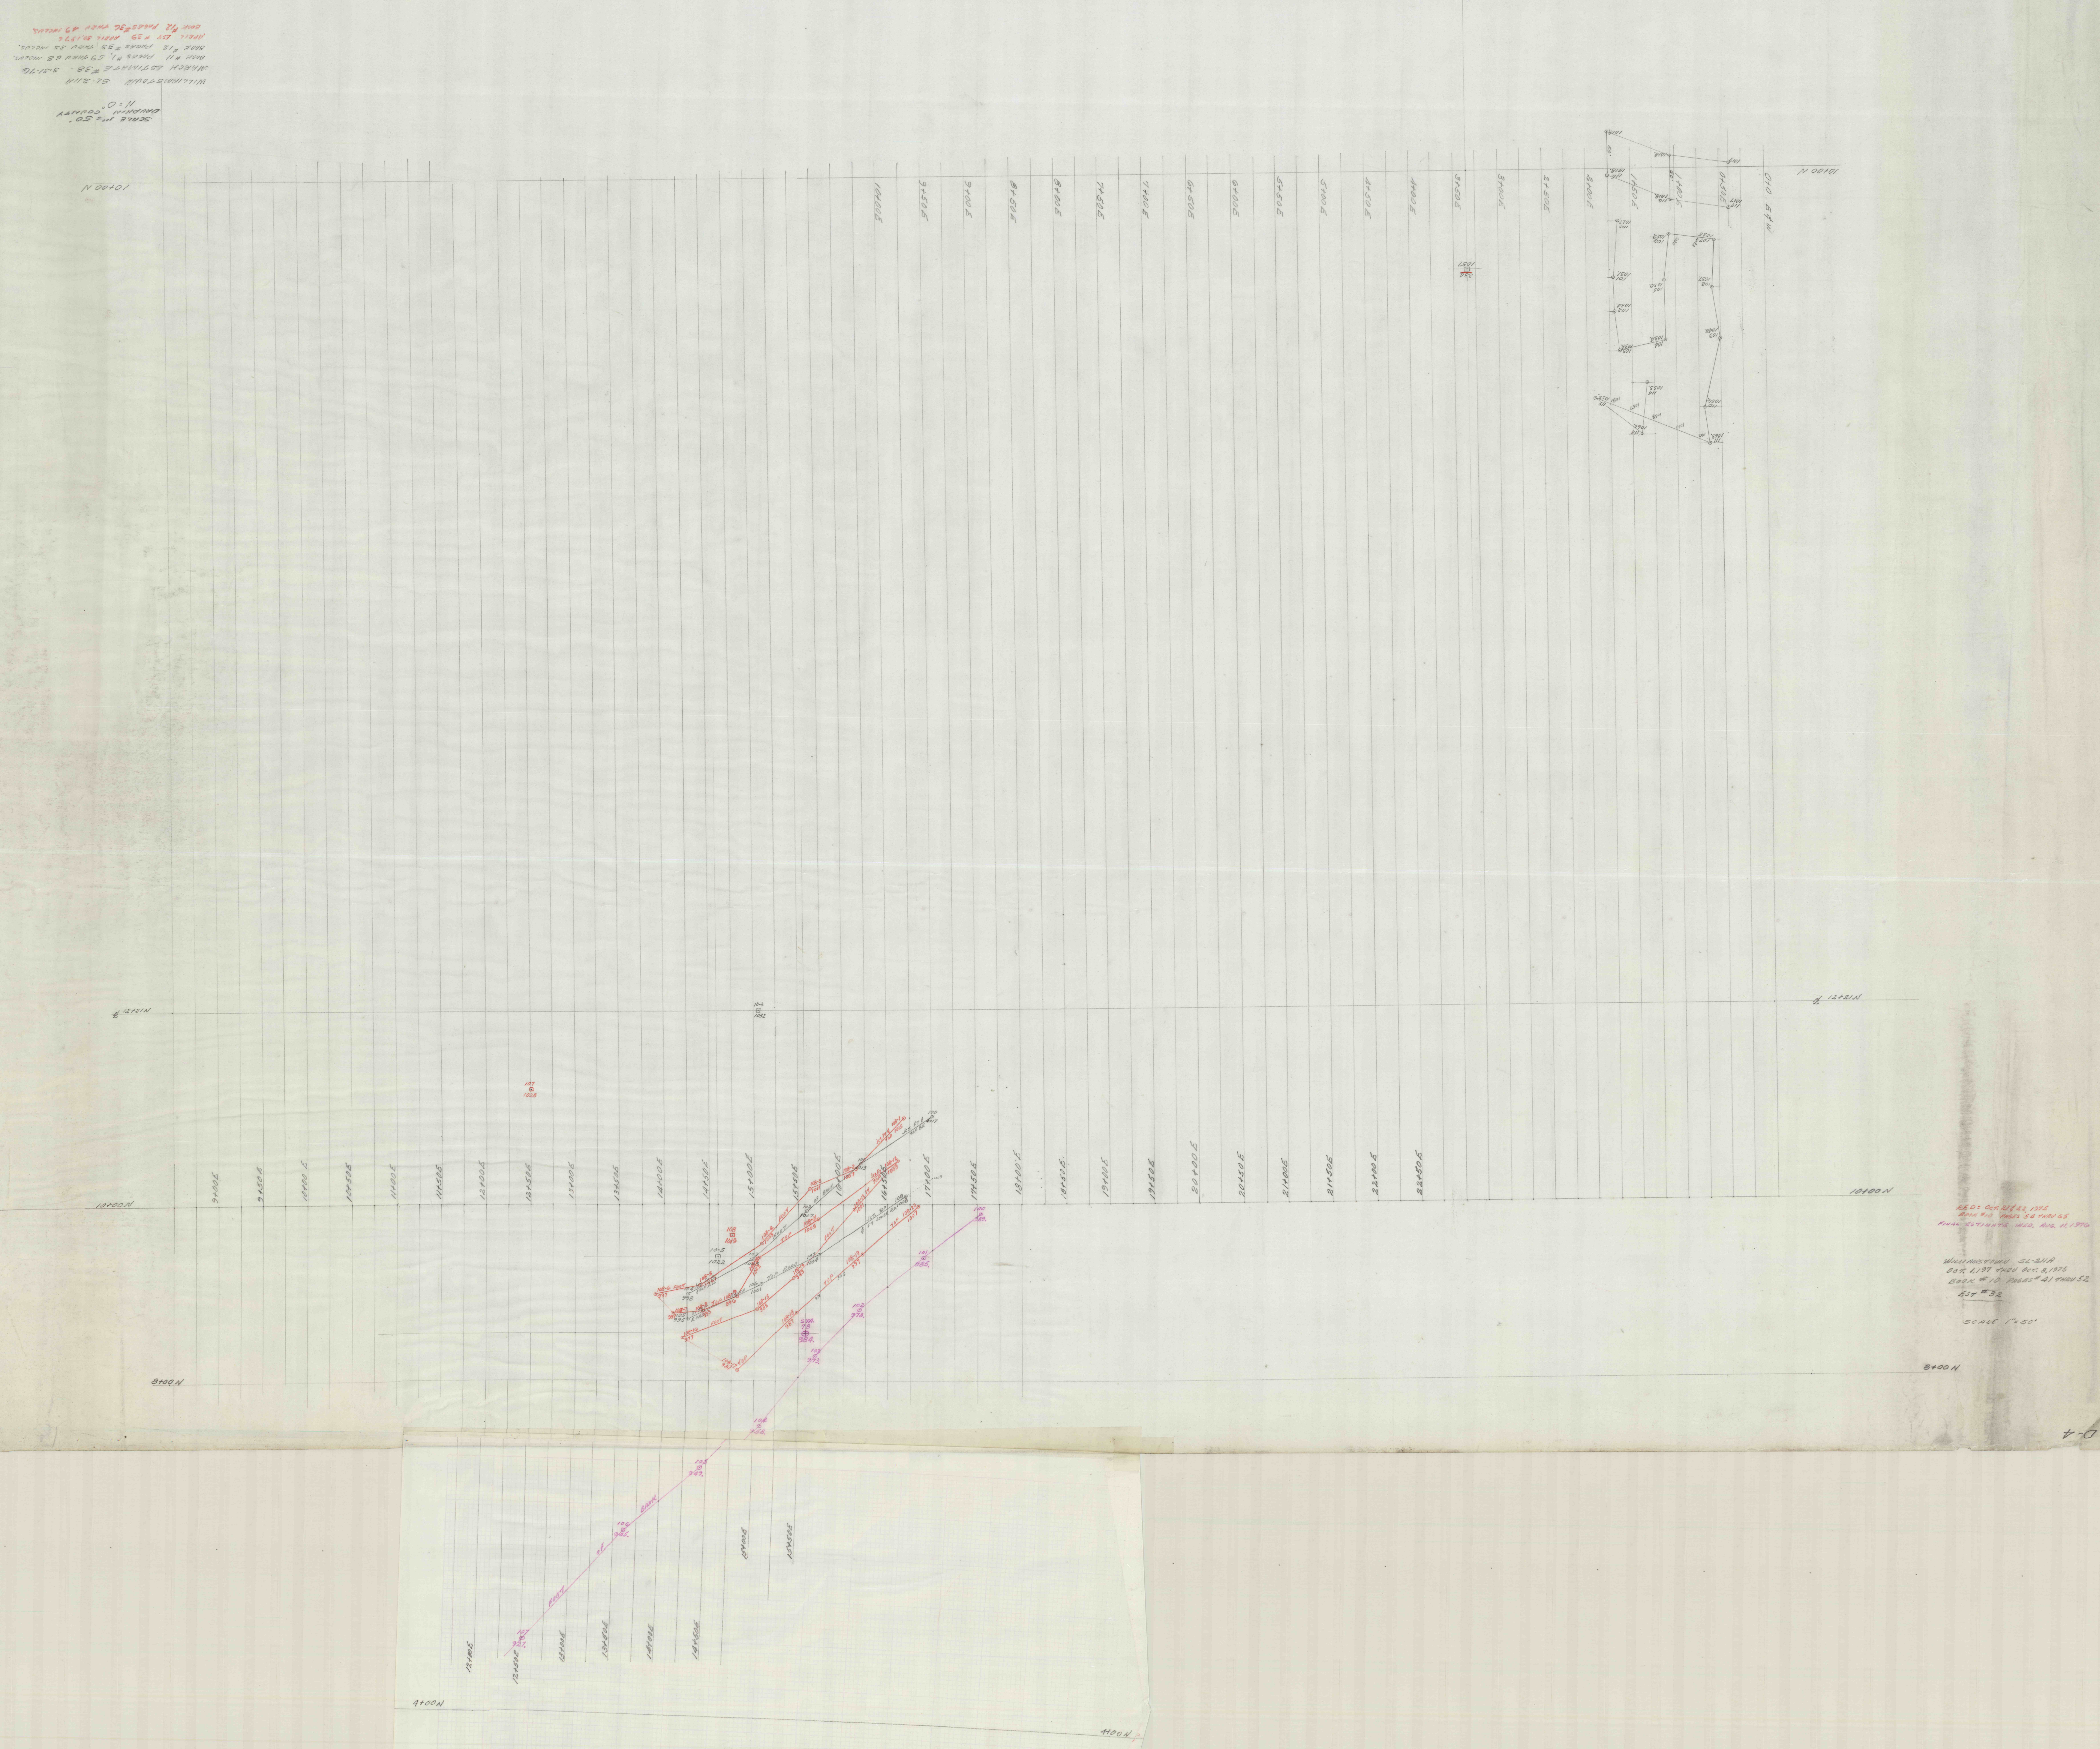
WILLIAMSTOWN SL-211A
MARCH ESTIMATE #38 - 3.31.76
BOOK #11 PAGES #1, 59 THRU 68 INCLUS.
BOOK #12 PAGES #33 THRU 35 INCLUS.
APRIL EST #39 APRIL 30,1976
BOOK #12 PAGES #36 THRU 49 INCLUS.
SCALE 1"=50'
DAUPHIN COUNTY
N=0°
10+00 N
12+21 N
10+00 N
8+00 N
4+00 N
RED: OCT. 21 & 22, 1975
BOOK #10 PAGES 54 THRU 65
FINAL ESTIMATE INFO. AUG. 11, 1976
WILLIAMSTOWN SL-211A
OCT. 1,1975 THRU OCT. 8,1975
BOOK #10 PAGES #41 THRU 52
EST #32
SCALE 1"=50'
D-4