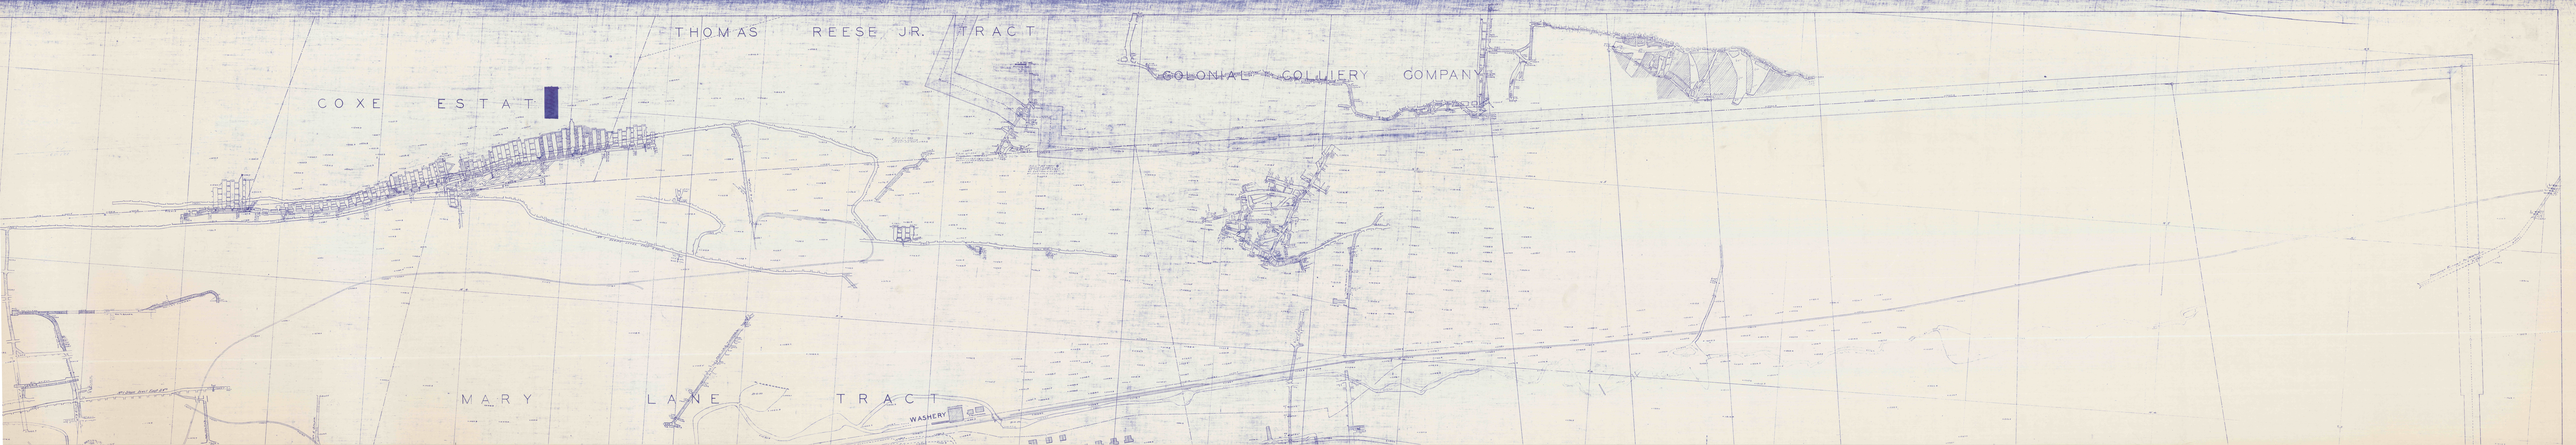
THOMAS REESE JR. TRACT
COXE ESTAT
COLONIAL COLLIERY COMPANY
MARY LANE TRACT
WASHERY