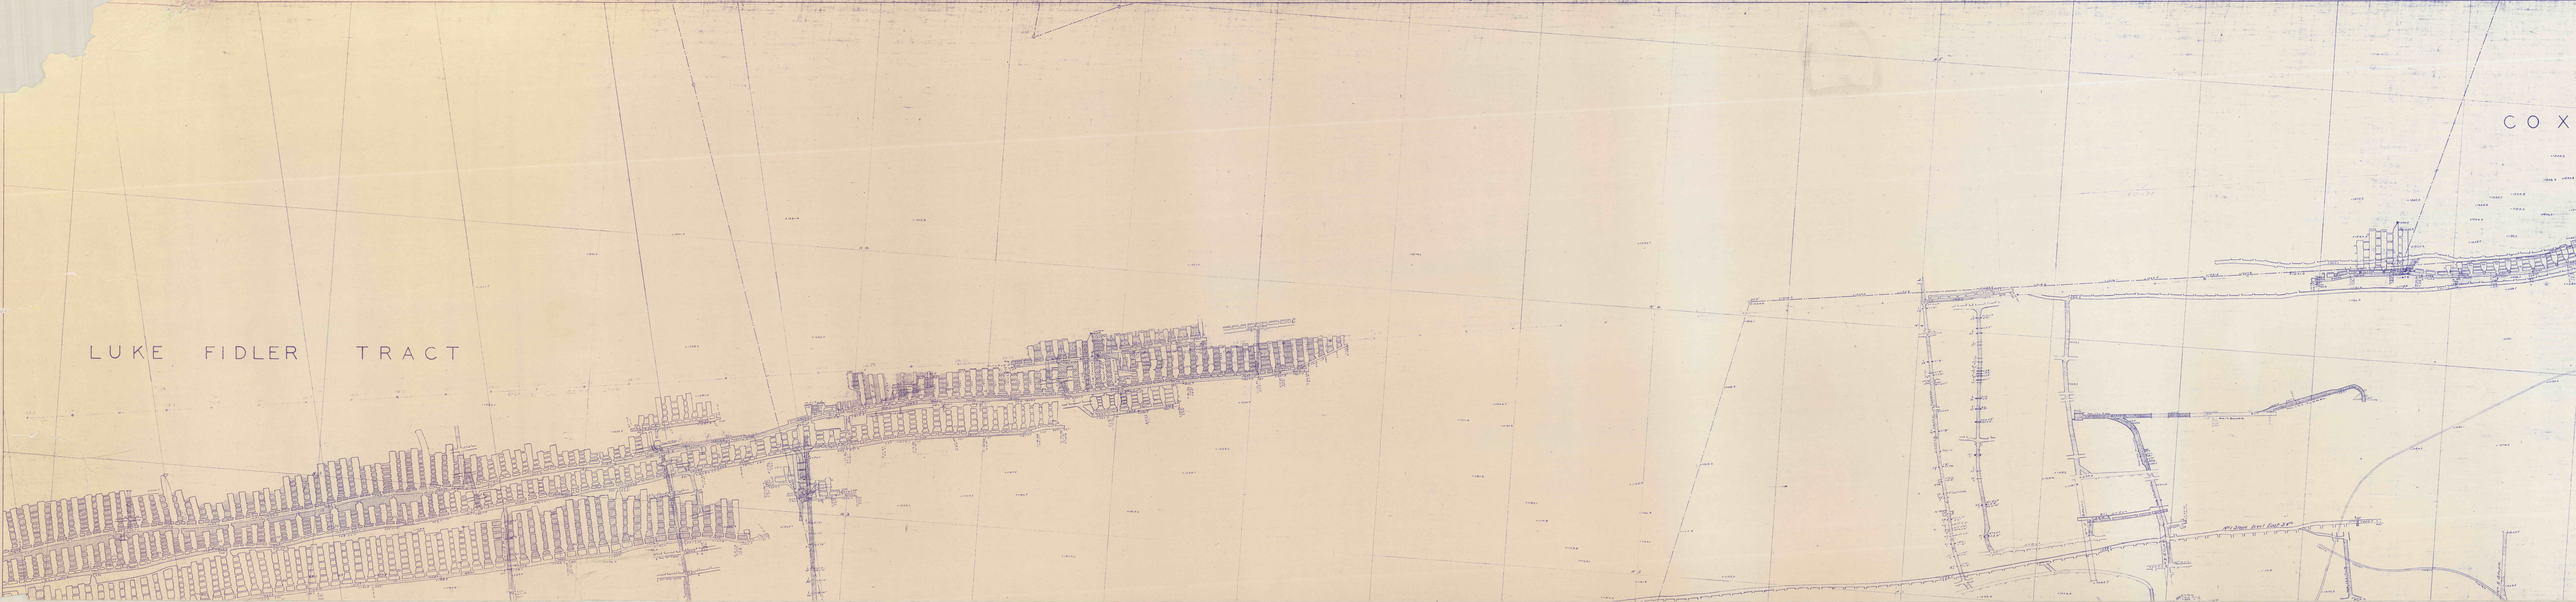
LUKE FIDLER TRACT
COX