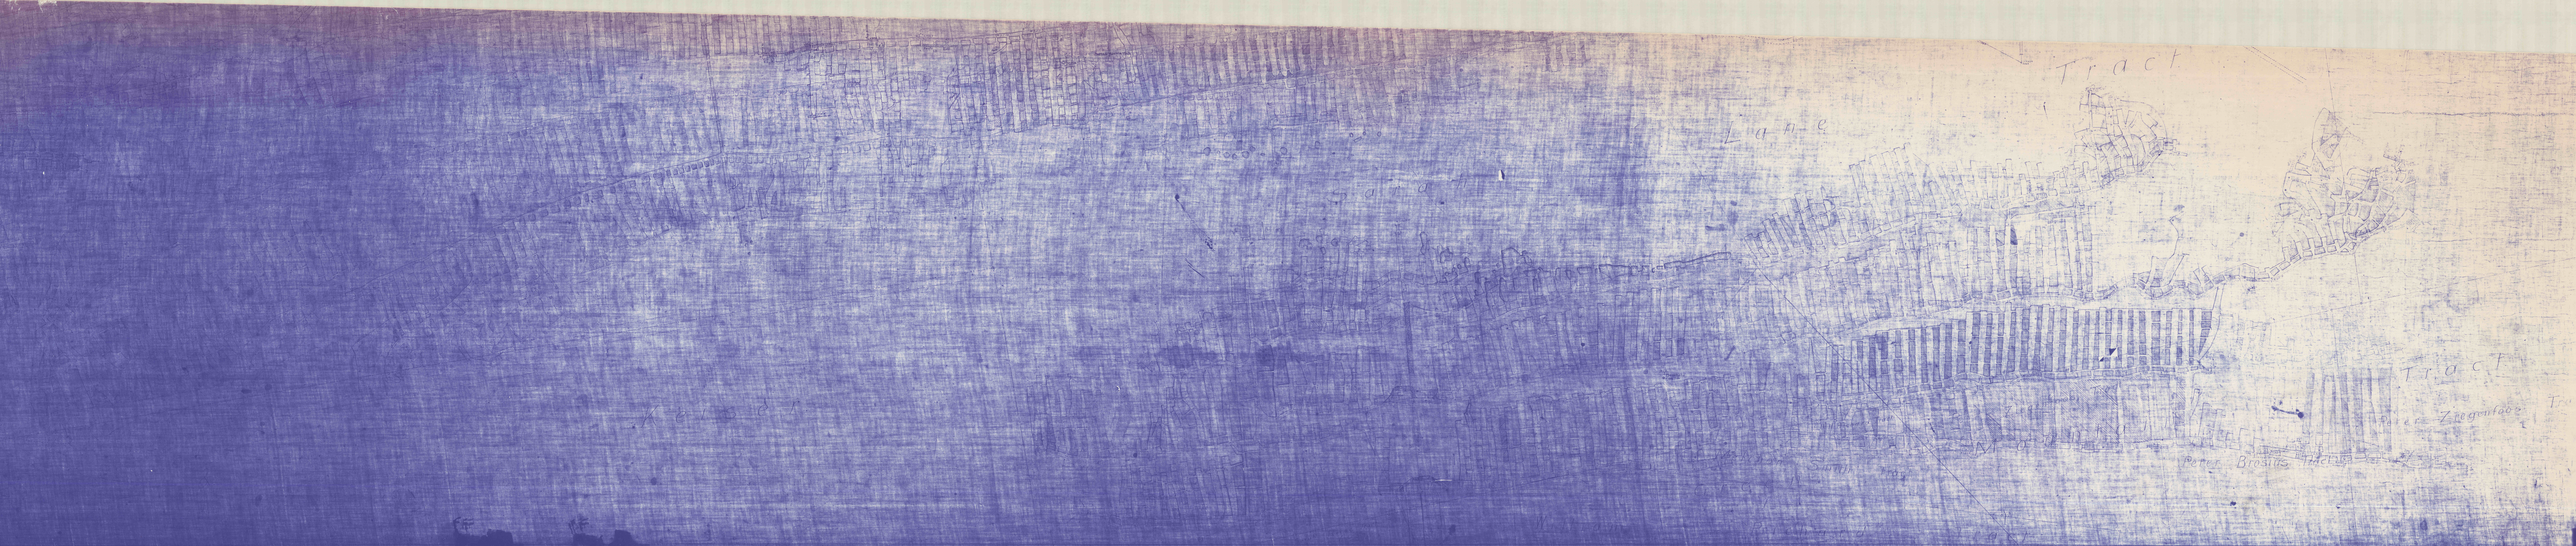
Tract
Lane
Tract