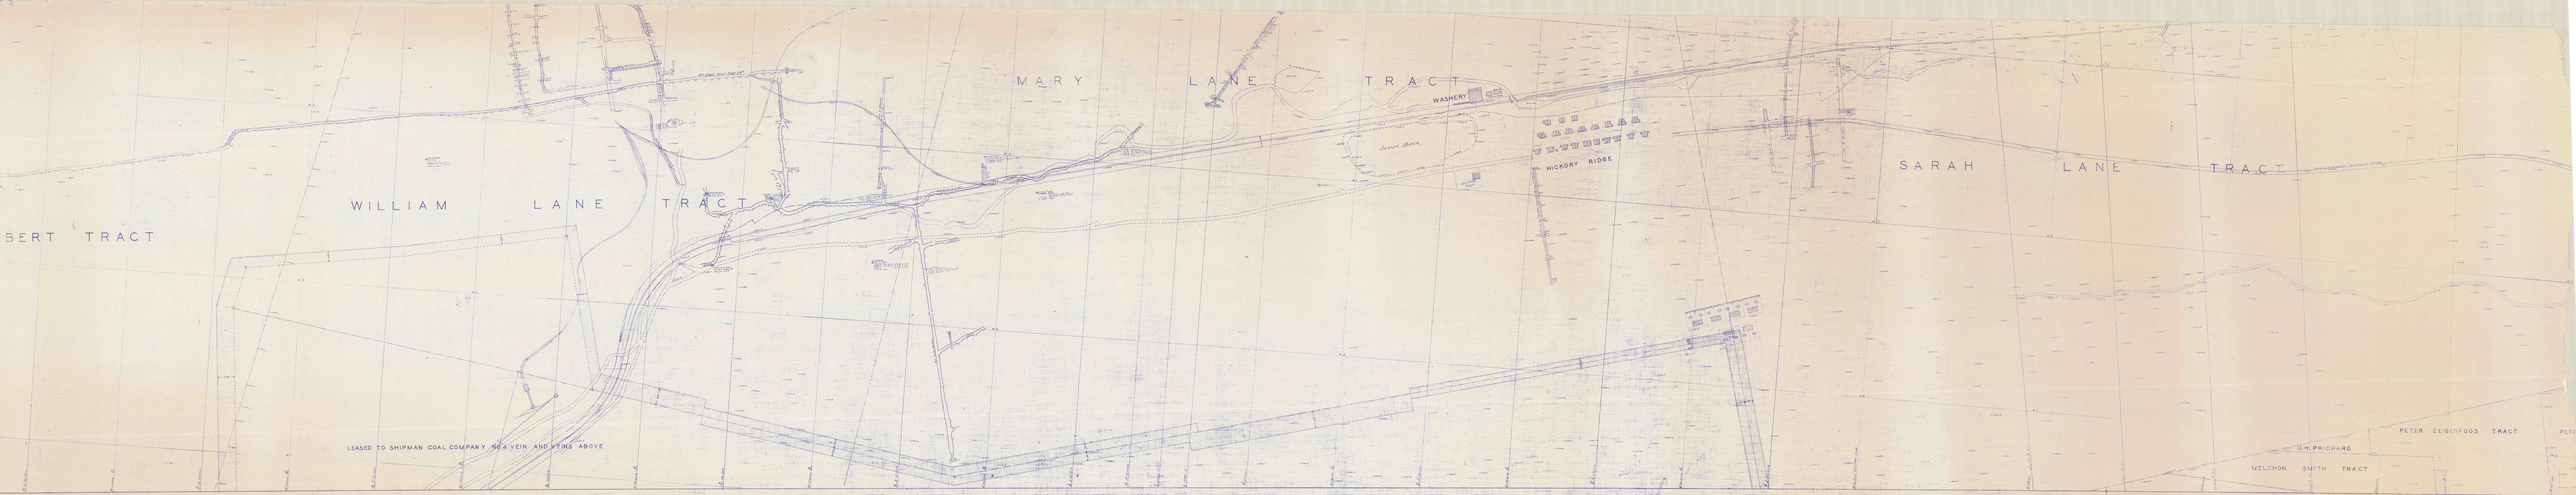
BERT TRACT
WILLIAM LANE TRACT
MARY LANE TRACT
WASHERY
HICKORY RIDGE
SARAH LANE TRACT
LEASED TO SHIPMAN COAL COMPANY NO 4 VEIN AND VEINS ABOVE
PETER ZEIGENFOOS TRACT
U.H. PRICHARD
MELCHON SMITH TRACT