


POSTED	
February	1917
January	1916
August	1920
July	1927
January	1926
June	1932
May	1933
March	1939
December	1944
February	1946
October	1947
April	1948
October	1949
January	1950

Eastern Middle Field
 • GAMMA VEIN: 1"=100'
 KLEIN-BANK Twp. LUZERNE COUNTY, PA.
 MIDDLE SHAFT BASINS
 BEAVER MEADOW DISTRICT NO. 9
 AUDENRIED NO. 4 COLLIERY
 HONEY BROOK MINES, INC.

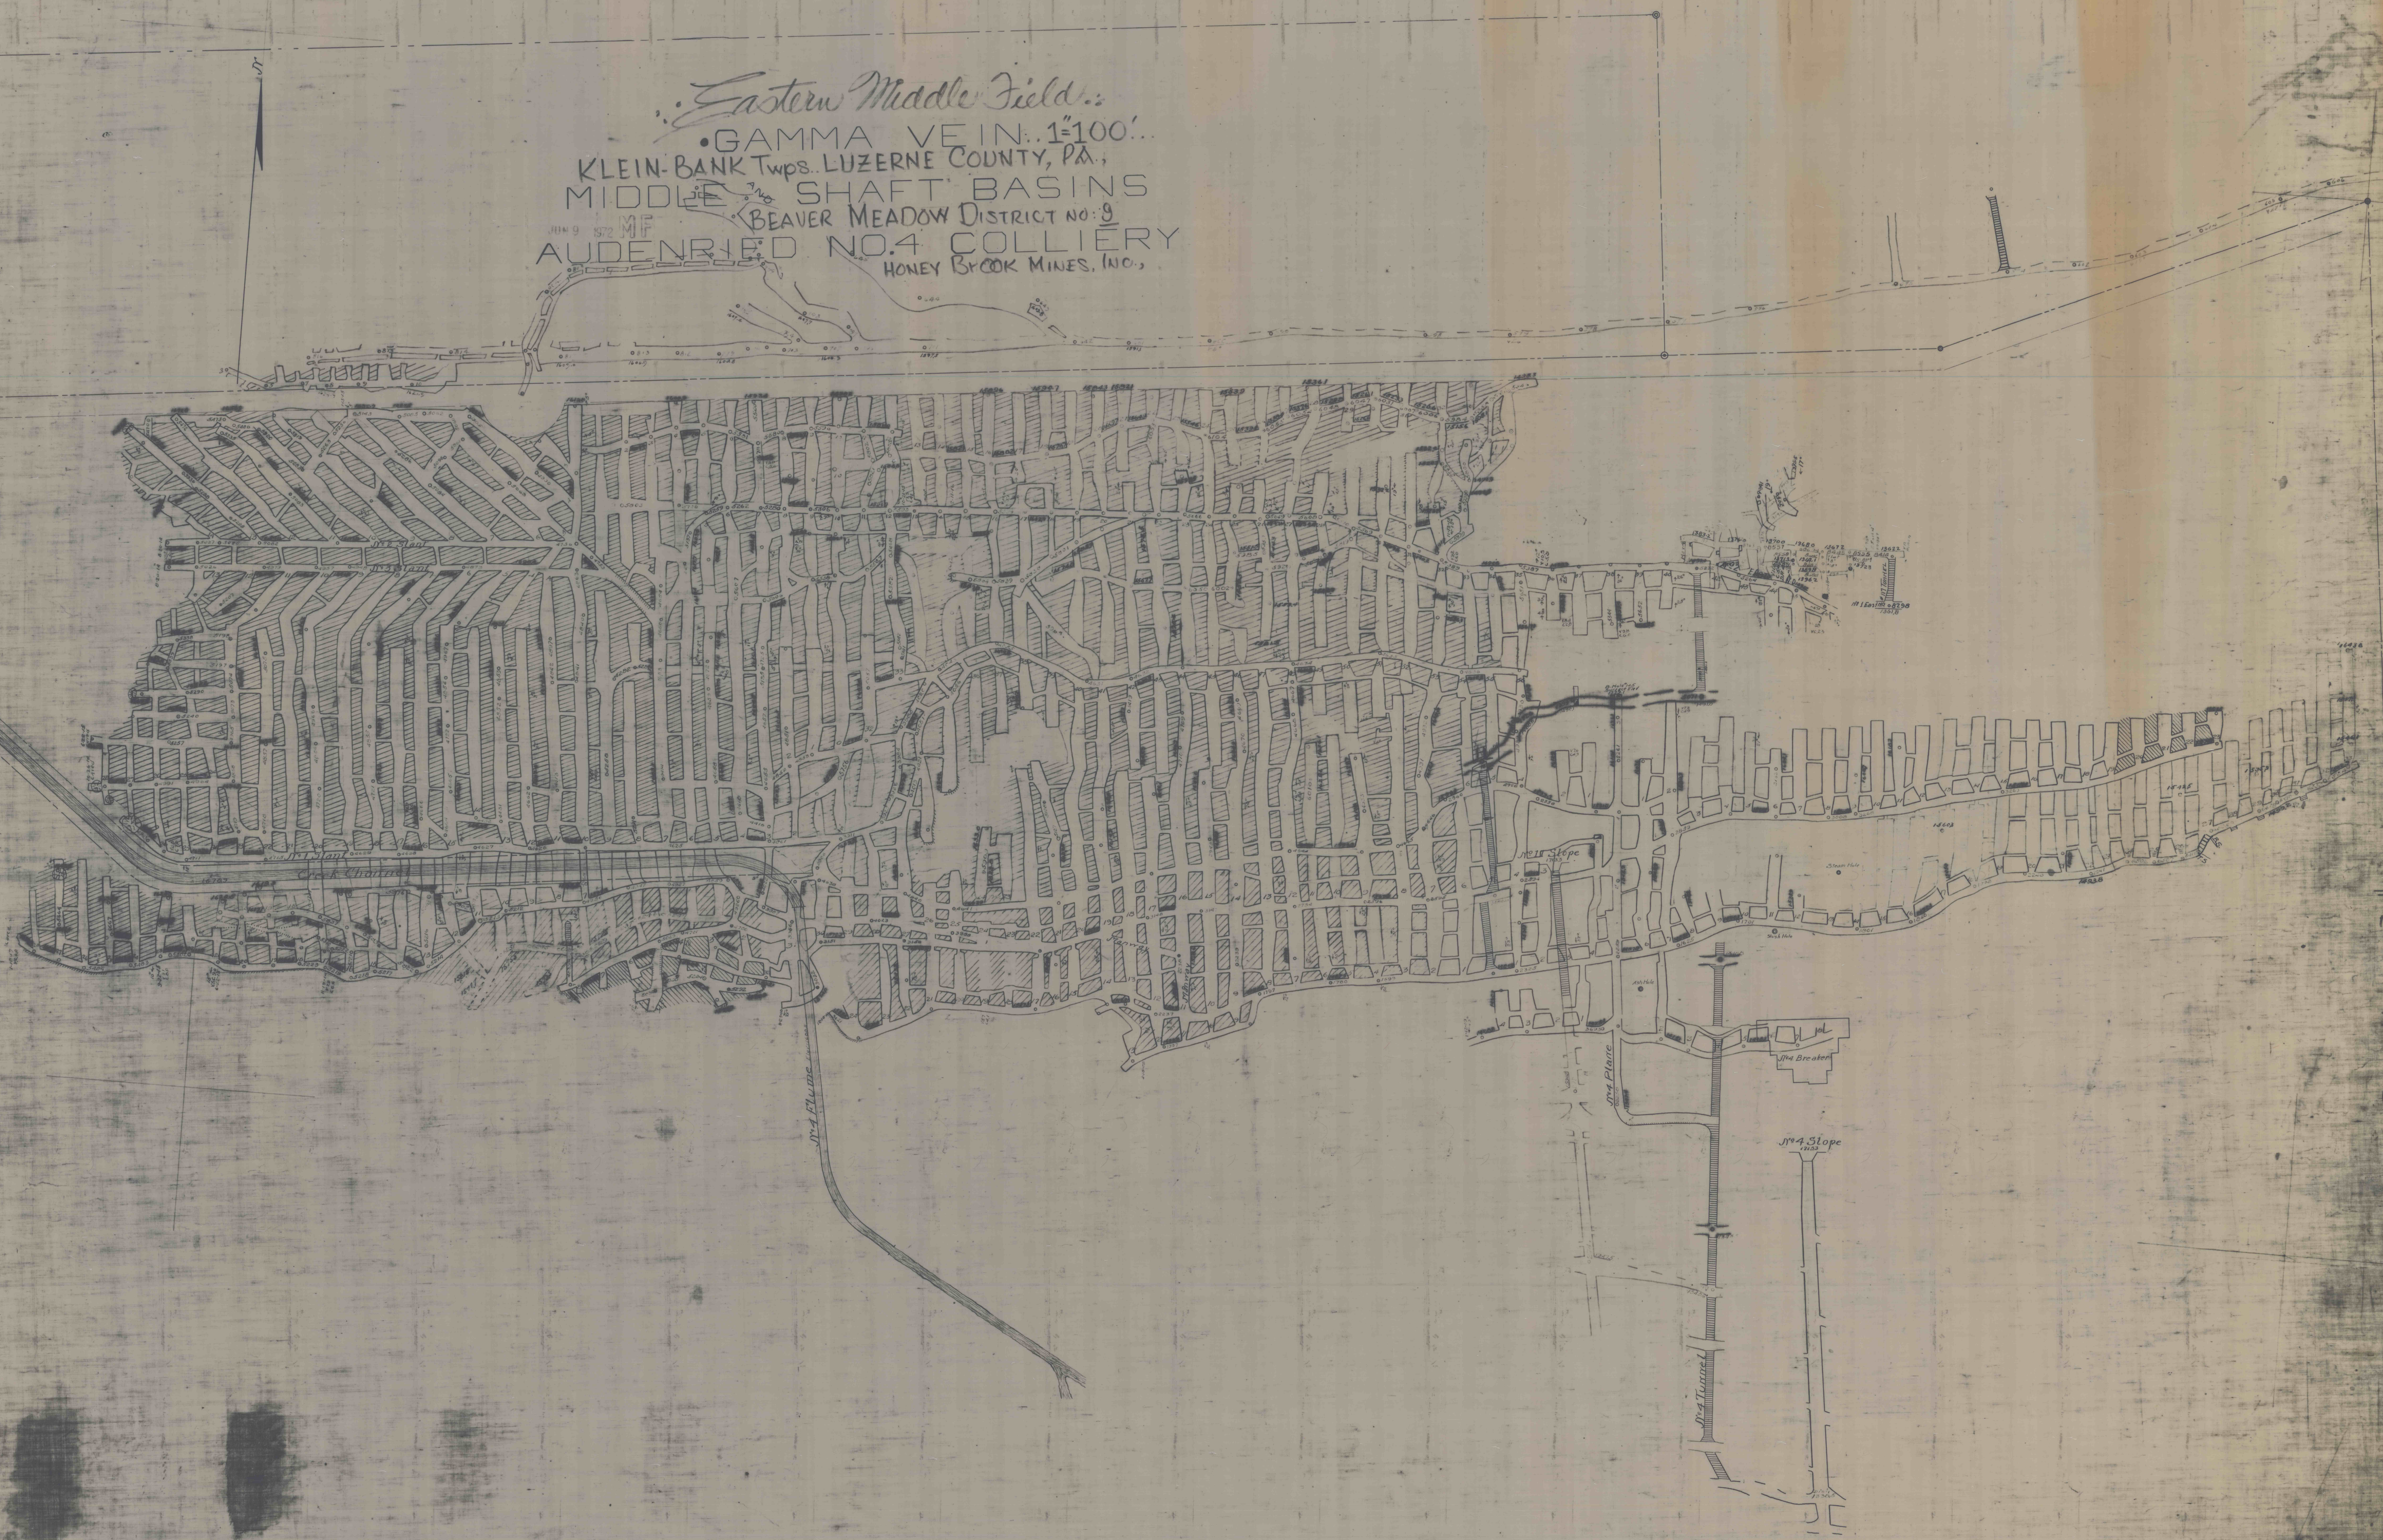

BEAVER MEADOW DISTRICT NO. 9 HONEY BROOK MINES, INC.
 MIDDLE SHAFT BASINS

D-6-1