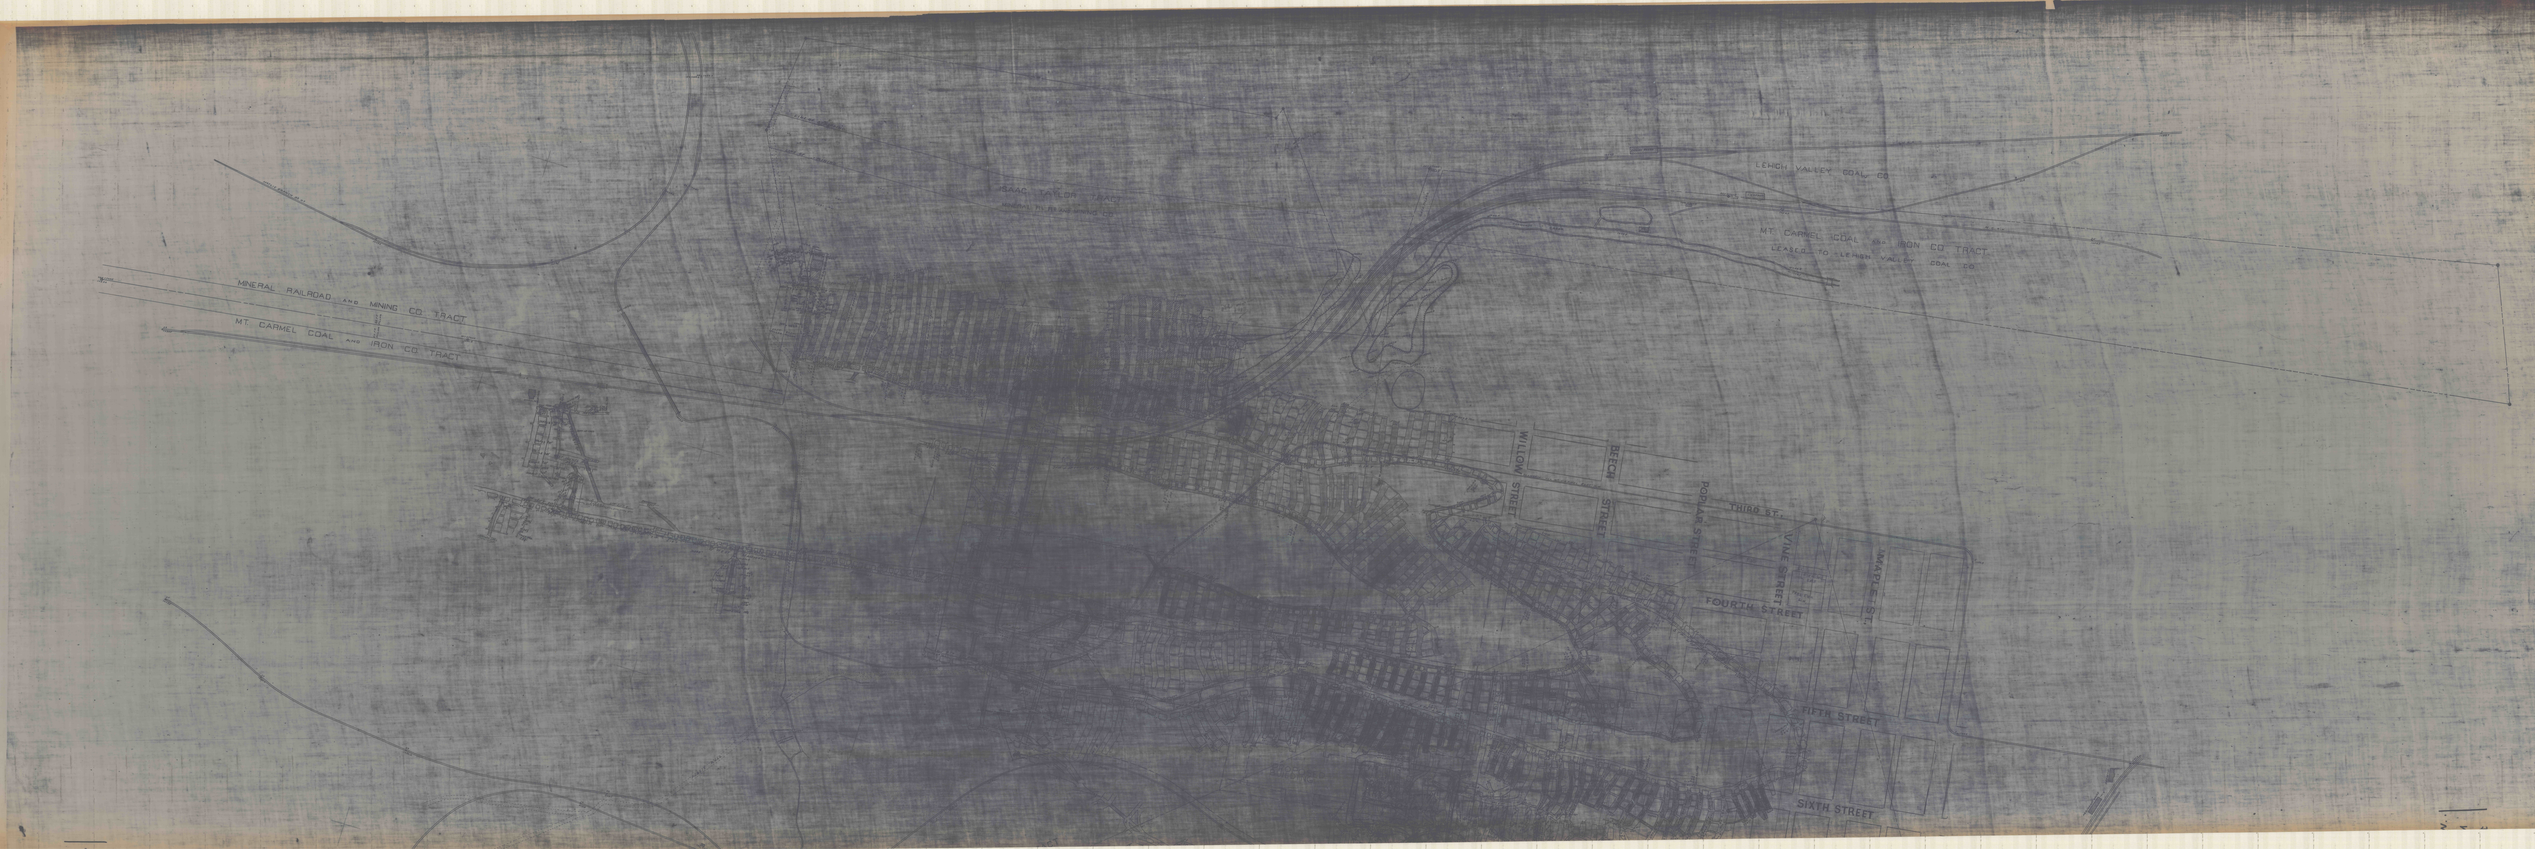
MINERAL RAILROAD AND MINING CO. TRACT
MT. CARMEL COAL AND IRON CO. TRACT
LEHIGH VALLEY COAL CO.
MT. CARMEL COAL & IRON CO. TRACT
LEASED TO LEHIGH VALLEY COAL CO.
WILLOW STREET
BEECH STREET
POPLAR STREET
THIRD ST.
VINE STREET
MAPLE ST.
FOURTH STREET
FIFTH STREET
SIXTH STREET