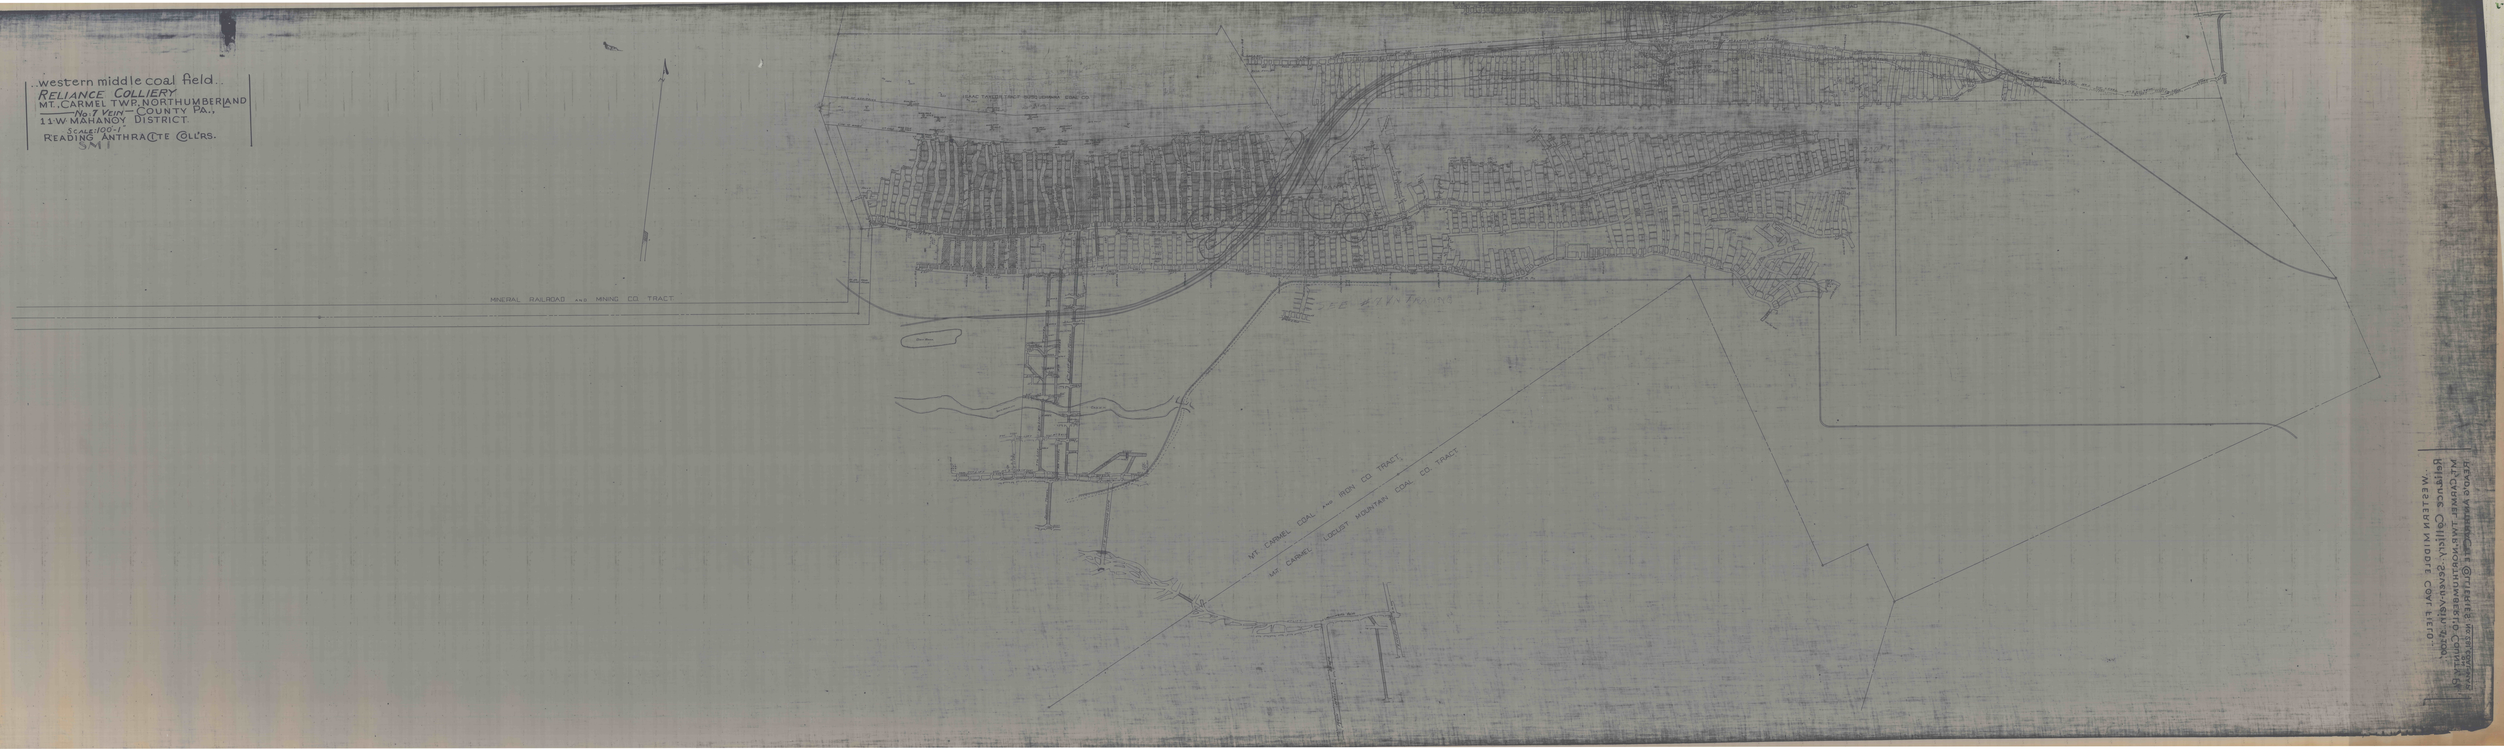
western middle coal field
RELIANCE COLLIERY
MT. CARMEL TWP. NORTHUMBERLAND
NO. 1 VEIN — COUNTY PA.,
11 W. MAHANOY DISTRICT.
SCALE 100'=1"
READING ANTHRACITE COL'RS.
MINERAL RAILROAD AND MINING CO. TRACT
MT. CARMEL COAL AND IRON CO. TRACT
MT. CARMEL LOCUST MOUNTAIN COAL CO. TRACT
WESTERN MIDDLE COAL FIELD