RELIANCE COLLIERY

Nos 8 and 9 Veins

Scale 100'-1" South Dip

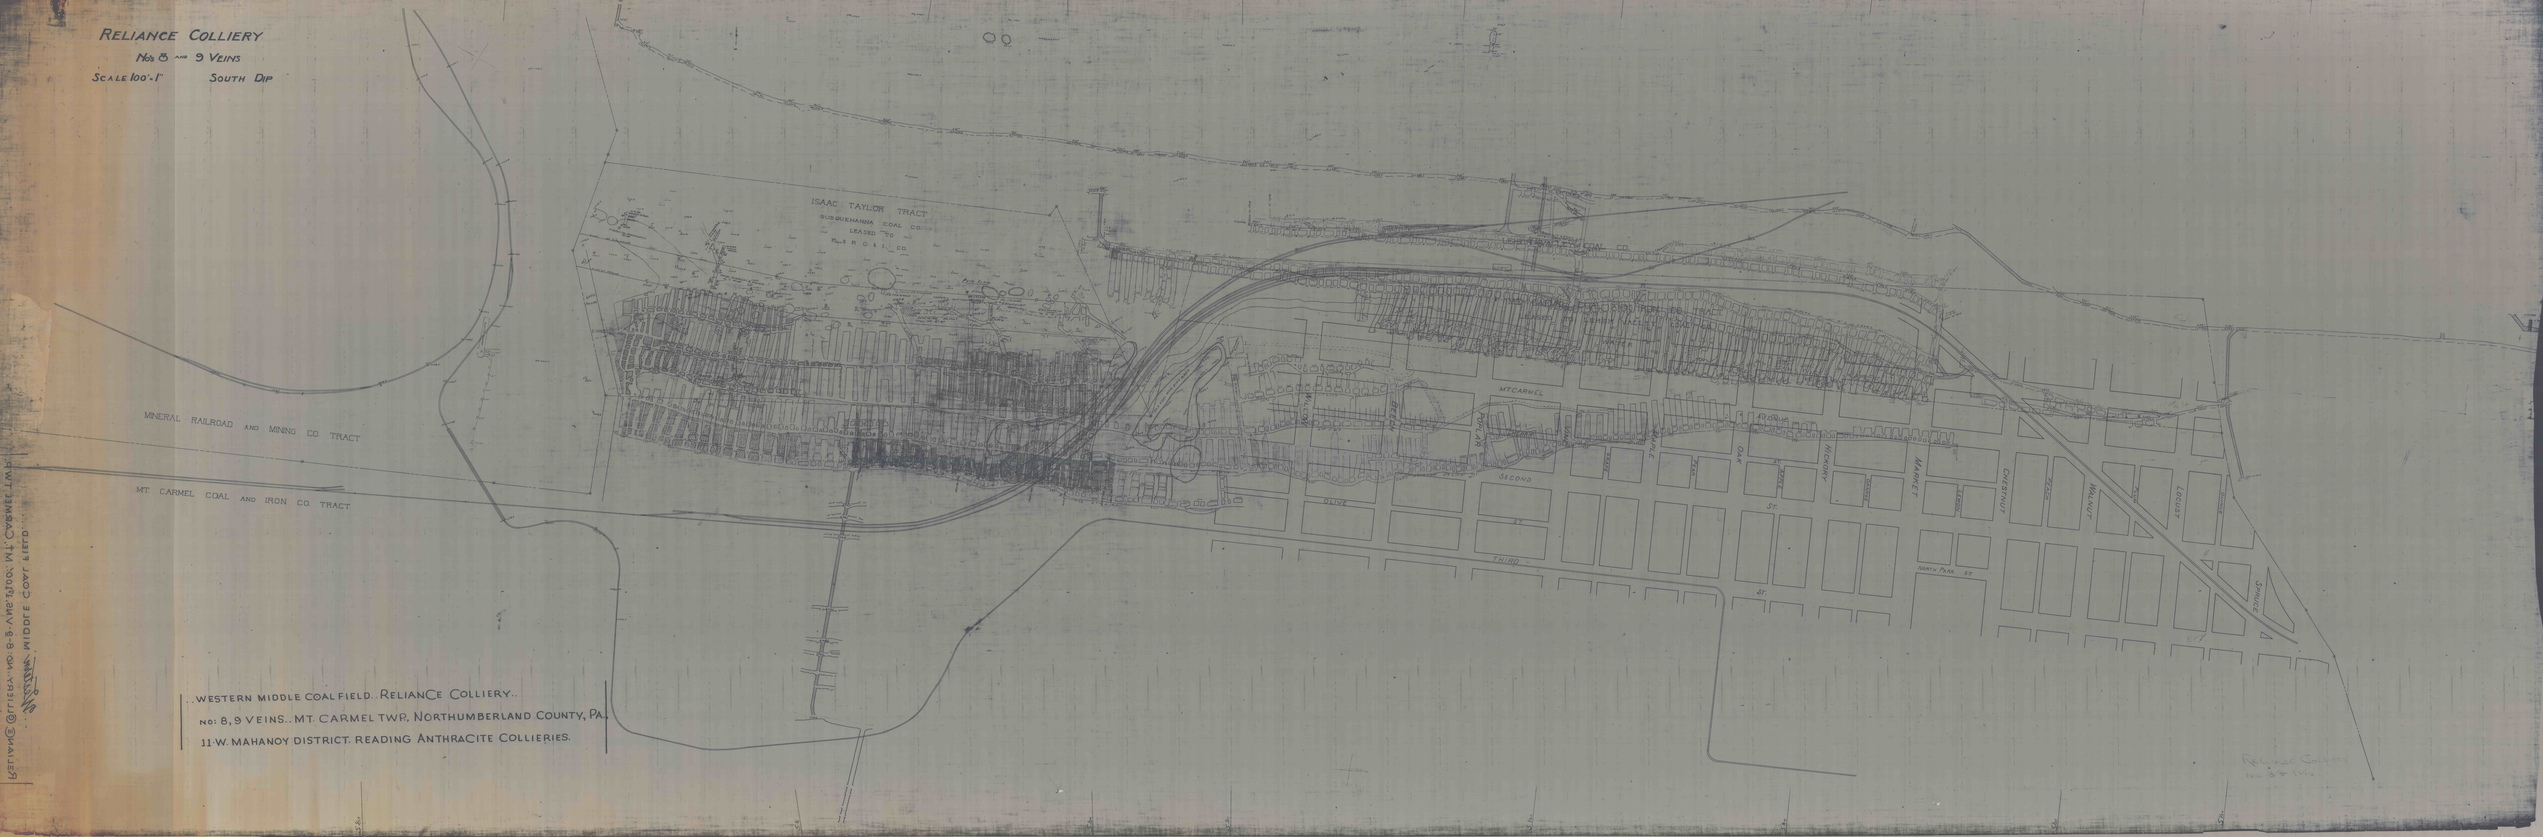

WESTERN MIDDLE COAL FIELD. RELIANCE COLLIERY.
Nos: 8, 9 VEINS. MT. CARMEL TWP. NORTHUMBERLAND COUNTY, PA.
11-W. MAHANOY DISTRICT. READING ANTHRACITE COLLIERIES.

WESTERN MIDDLE COAL FIELD
NORTHUMBERLAND COUNTY, PA.
11-W. MAHANOY DISTRICT
READING ANTHRACITE COMPANIES