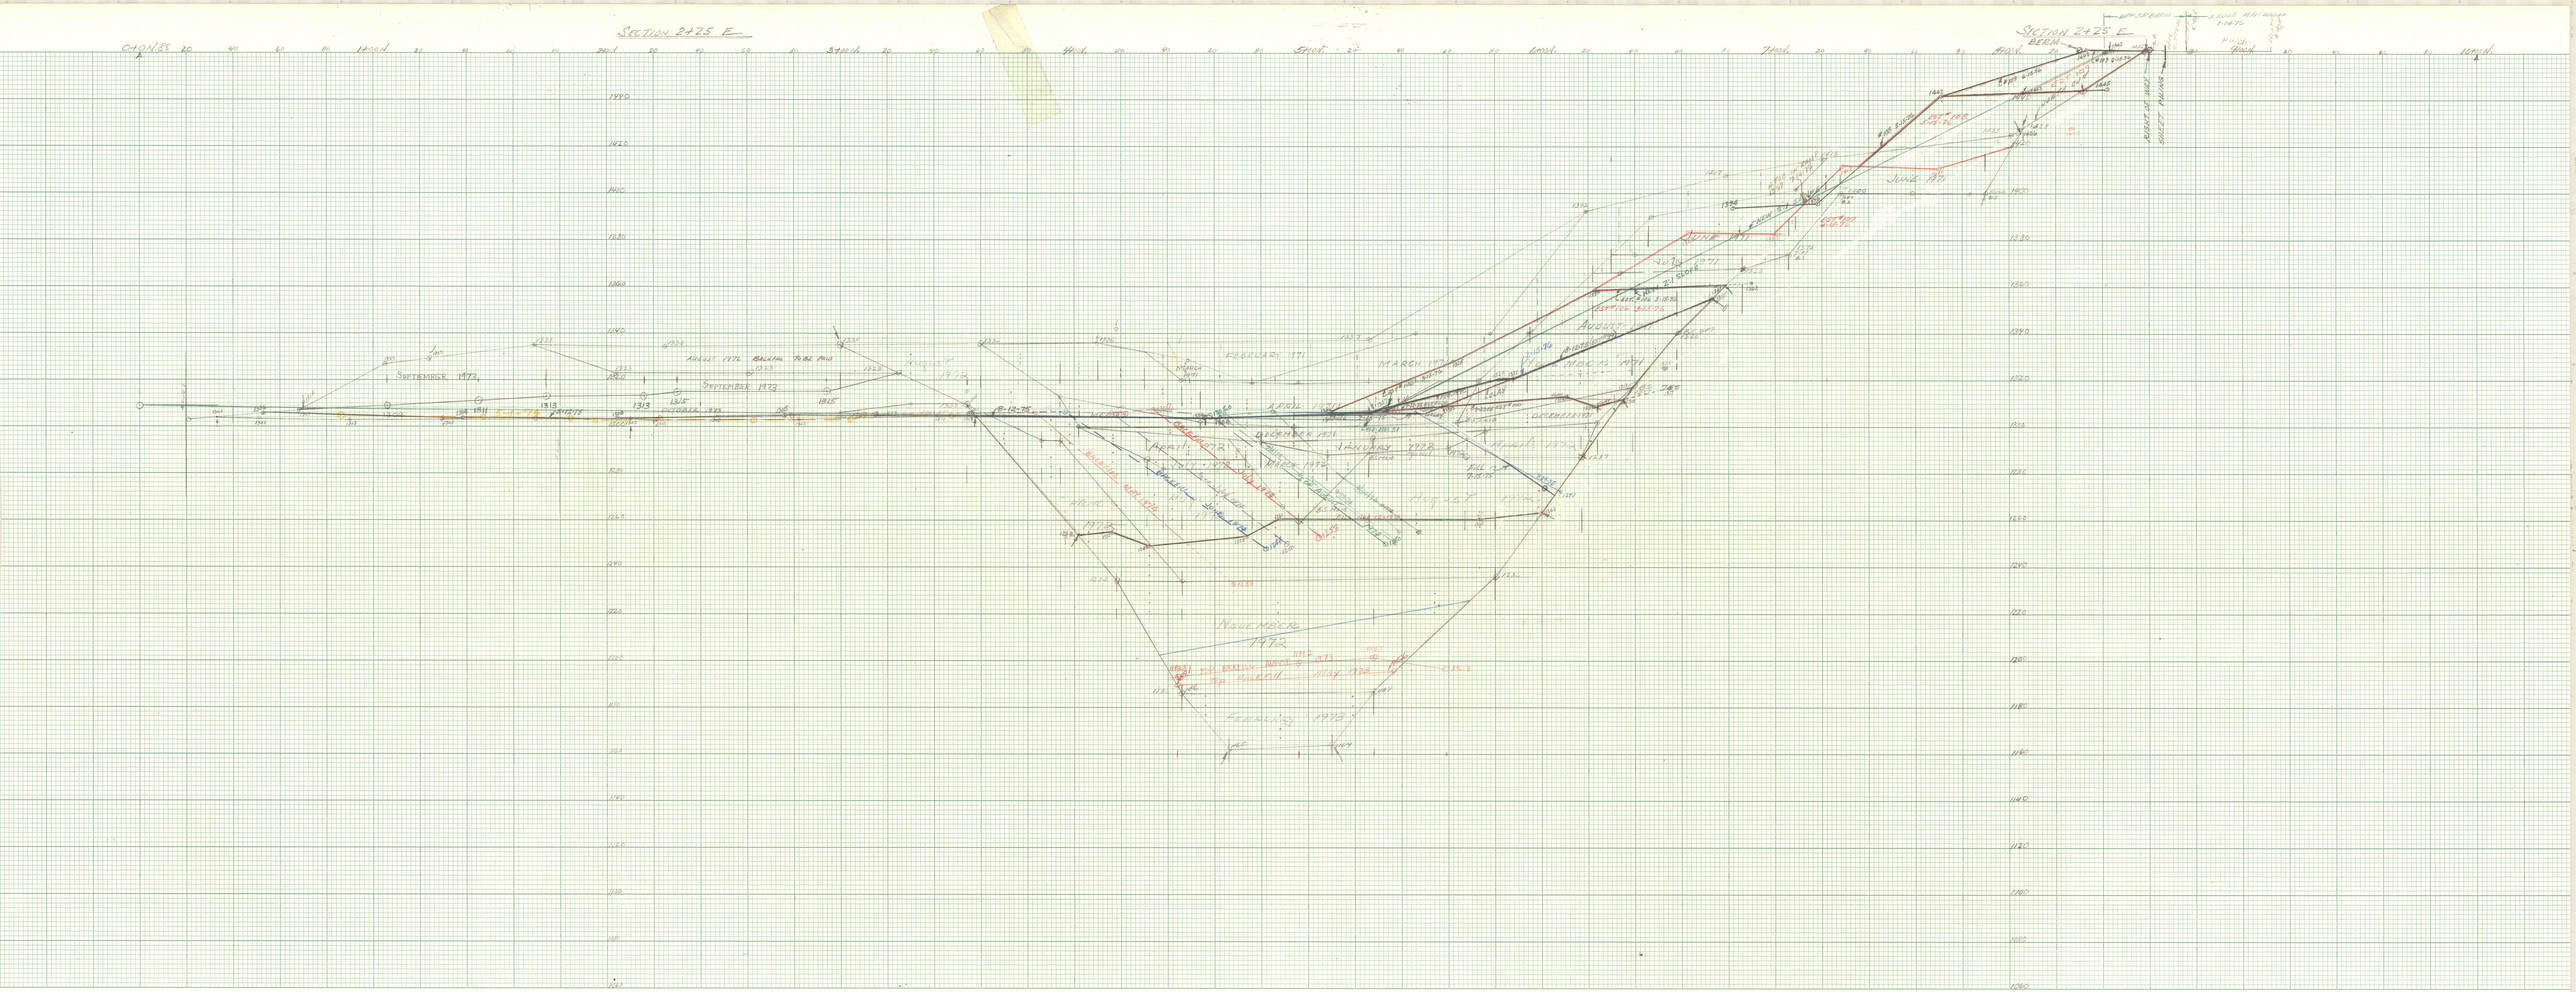
SECTION 2425 E
SECTION 2425 E
BERM
CANNES
MARCH
SEPTEMBER 1973
AUGUST 1971. BALANCE TO BE PAID
SEPTEMBER 1973
OCTOBER 1973
FEBRUARY 1971
MARCH 1971
APRIL 1971
DECEMBER 1971
JANUARY 1972
MARCH 1972
NOVEMBER 1972
FEBRUARY 1973
JUNE 1971
AUGUST 1971
JULY 1971
SEPTEMBER 1971
OCTOBER 1971
DECEMBER 1971
JANUARY 1972
MARCH 1972
