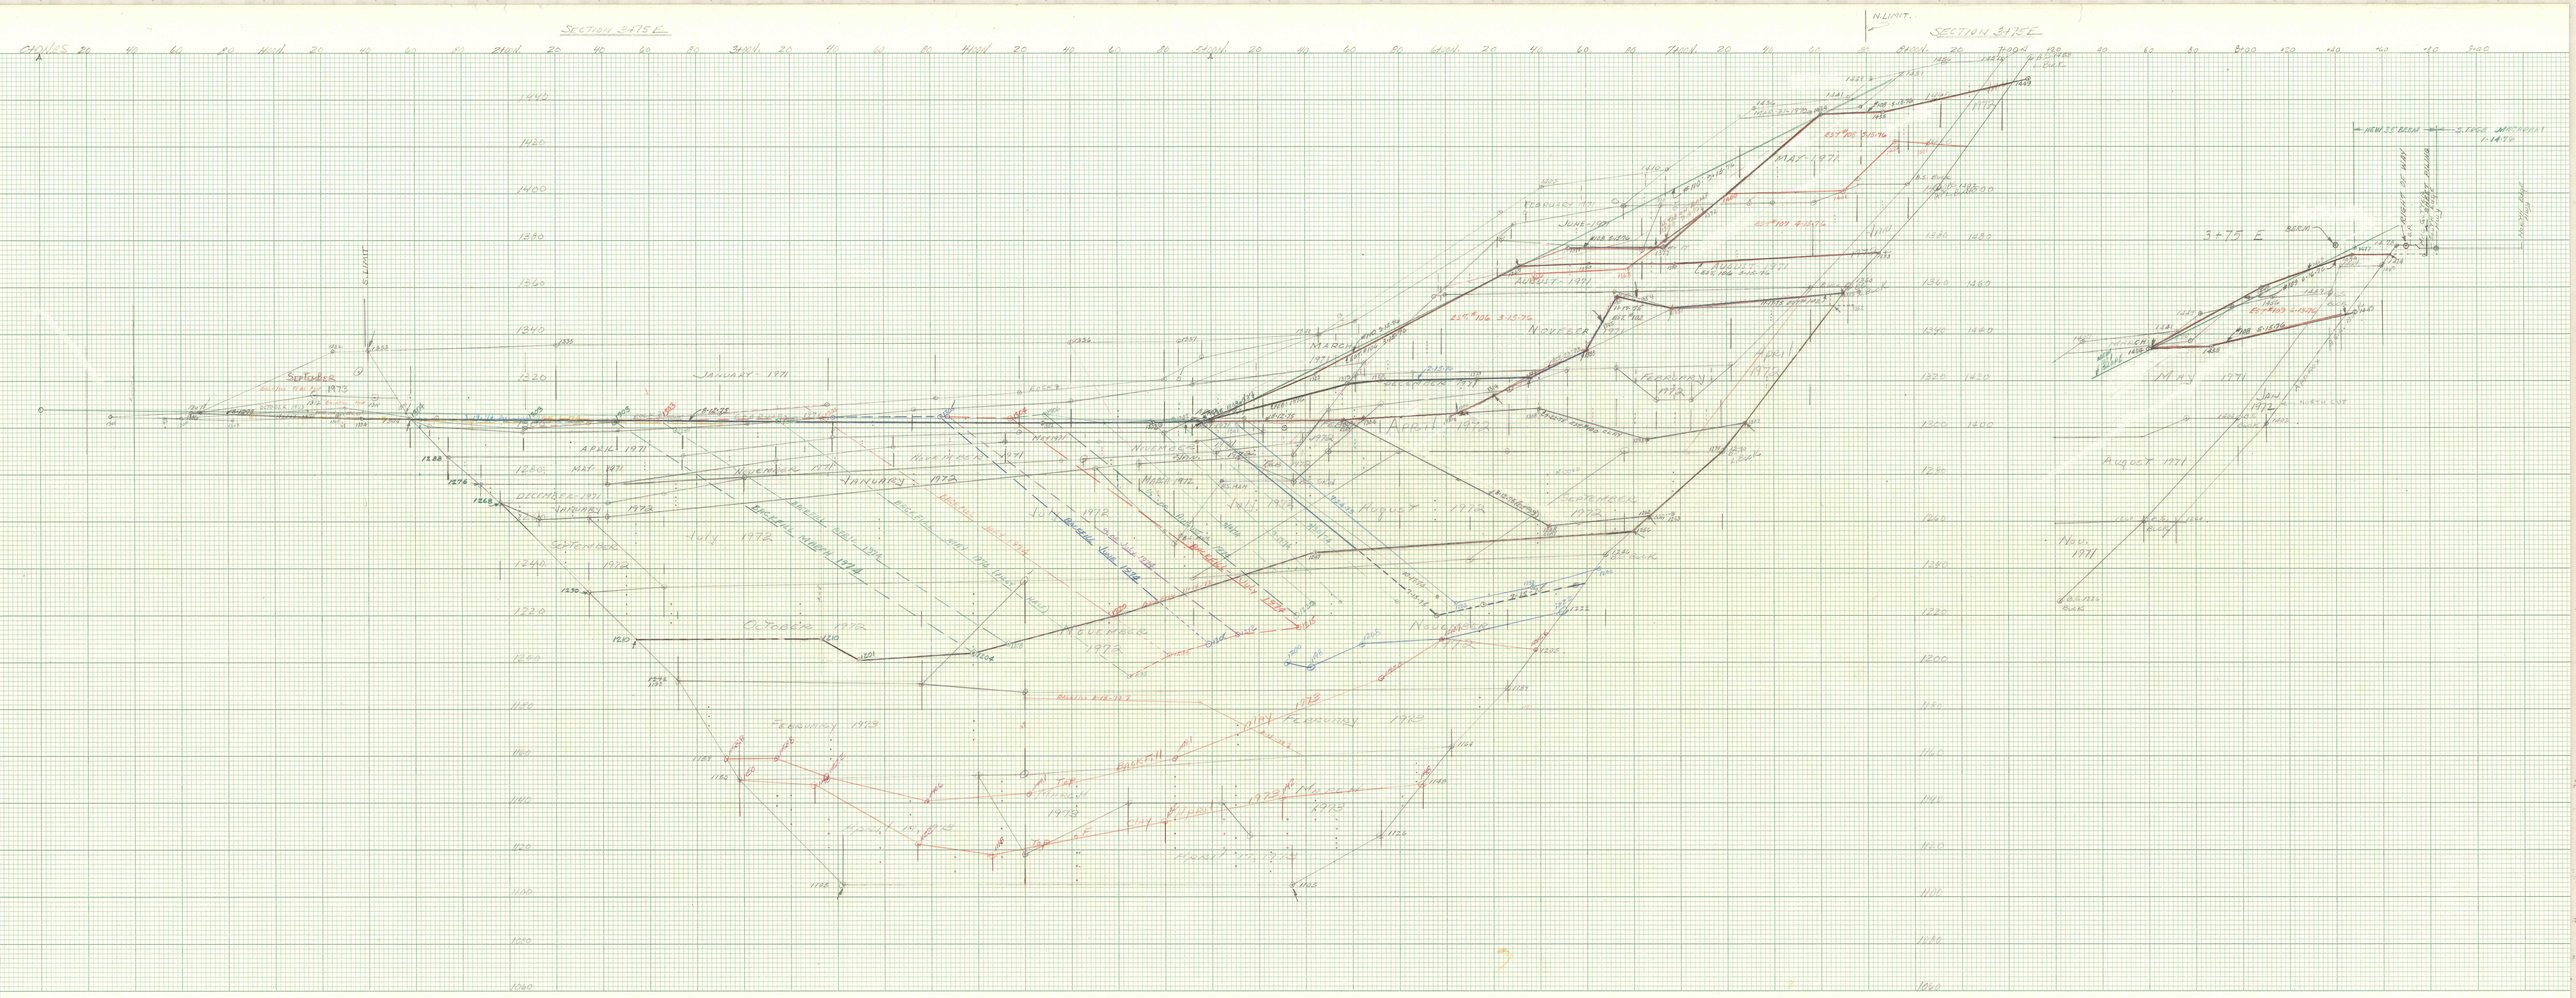
SECTION 3+75 E
SECTION 3+75 E
N. LIMIT
S. LIMIT
3+75 E
CHAINS
JANUARY 1971
MARCH 1971
APRIL 1971
MAY 1971
JUNE 1971
AUGUST 1971
SEPTEMBER 1971
DECEMBER 1971
NOVEMBER 1971
OCTOBER 1971
FEBRUARY 1972
JULY 1972
AUGUST 1972
SEPTEMBER 1972
NOVEMBER 1972
DECEMBER 1972
JANUARY 1973
FEBRUARY 1973
MARCH 1973
MAY 1973
JULY 1973
AUGUST 1973
SEPTEMBER 1973
NOVEMBER 1973
DECEMBER 1973
JANUARY 1974
FEBRUARY 1974
MARCH 1974
APRIL 1974
MAY 1974
JUNE 1974
JULY 1974
AUGUST 1974
SEPTEMBER 1974
OCTOBER 1974
NOVEMBER 1974
DECEMBER 1974
JANUARY 1975
FEBRUARY 1975
MARCH 1975
APRIL 1975
MAY 1975
JUNE 1975
JULY 1975
AUGUST 1975
SEPTEMBER 1975
OCTOBER 1975
NOVEMBER 1975
DECEMBER 1975
JANUARY 1976
FEBRUARY 1976
MARCH 1976
APRIL 1976
MAY 1976
JUNE 1976
JULY 1976
AUGUST 1976
SEPTEMBER 1976
OCTOBER