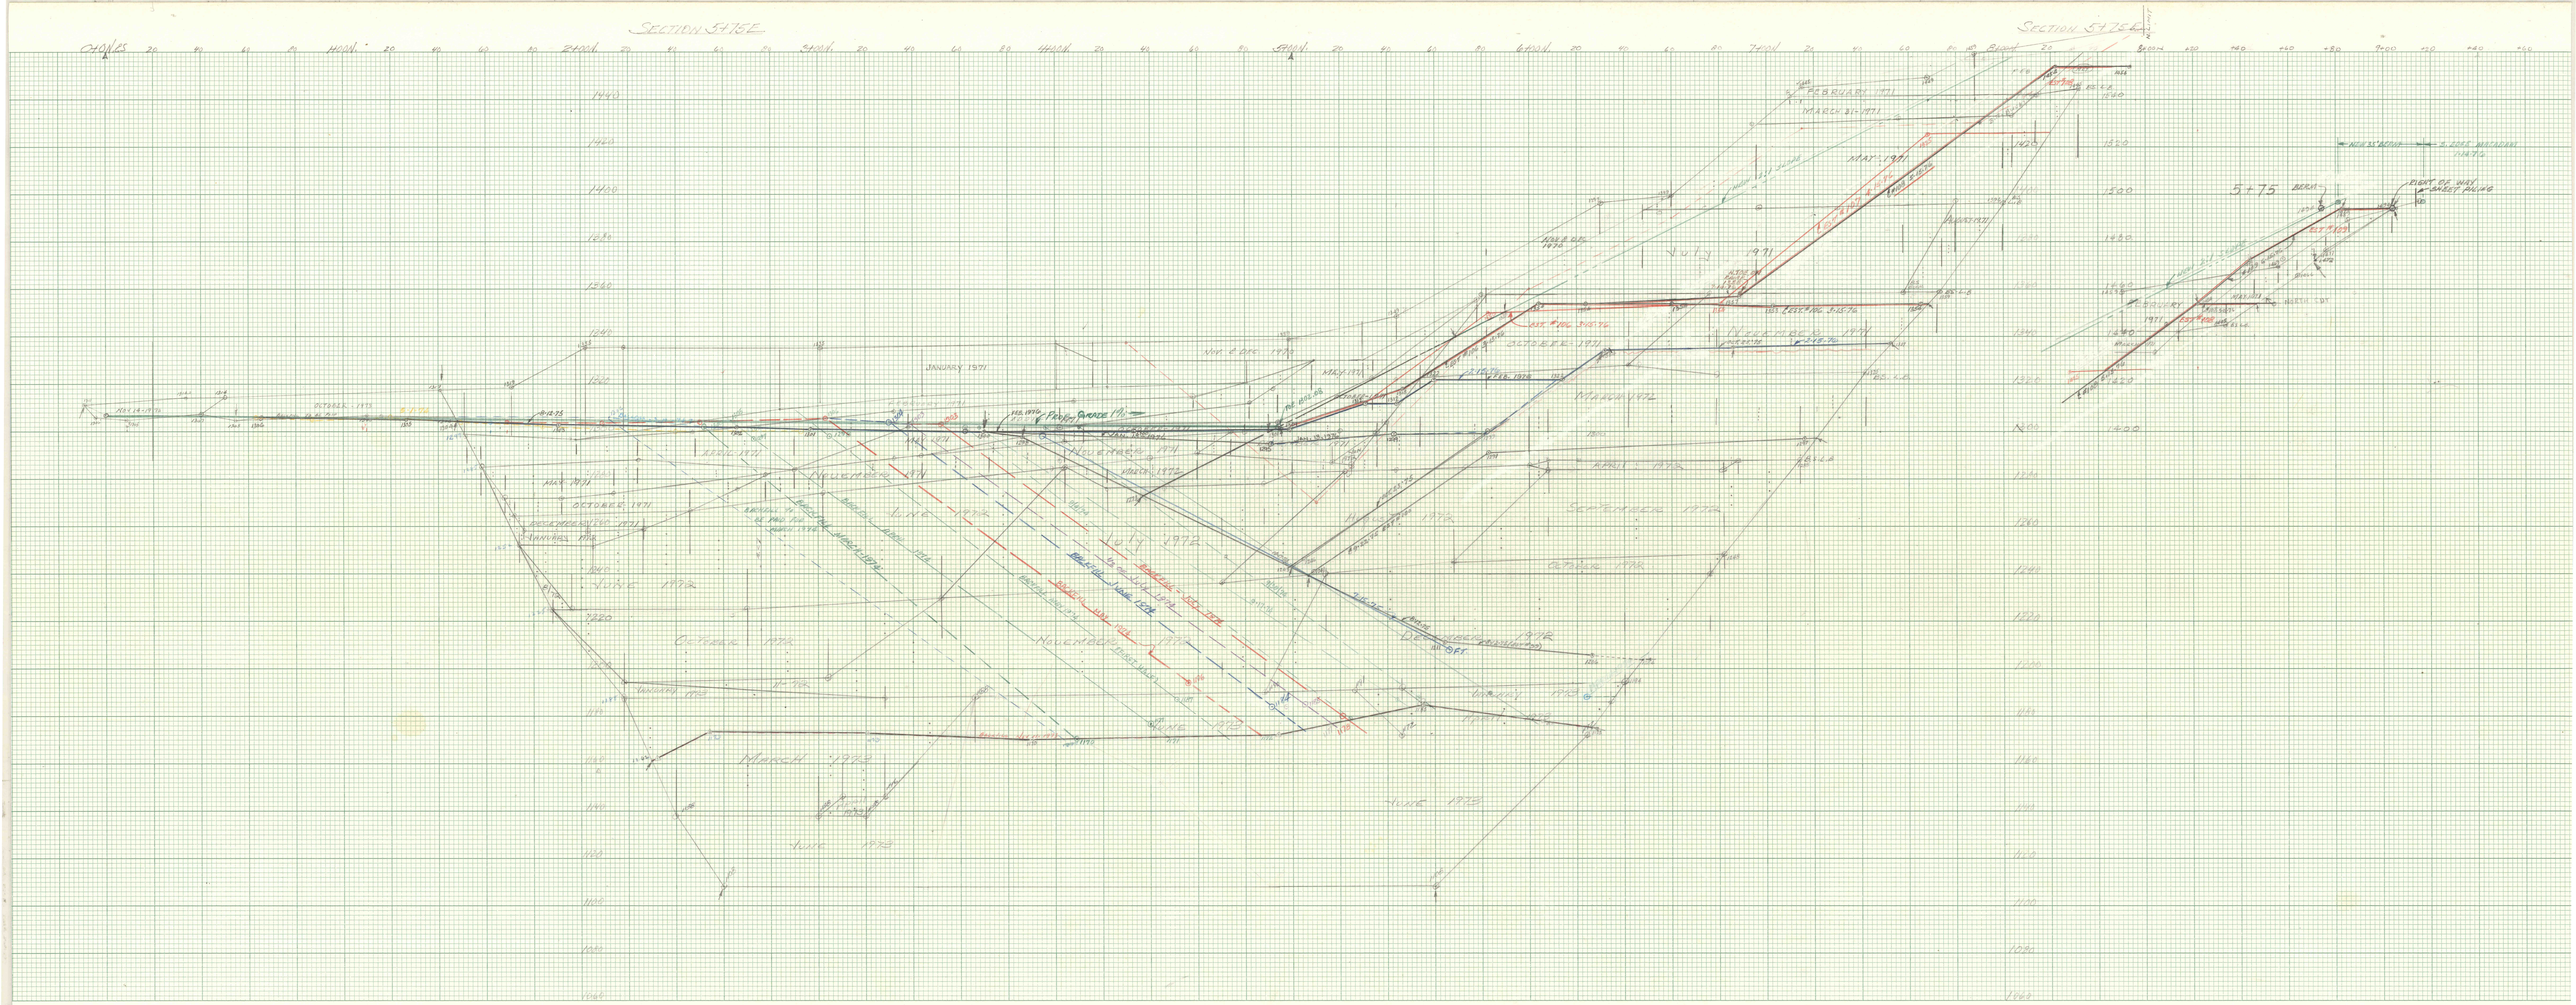
SECTION 5+75E
SECTION 5+75E
5+75
JANUARY 1971
FEBRUARY 1971
MARCH 1971
APRIL 1971
MAY 1971
JUNE 1971
JULY 1971
AUGUST 1971
SEPTEMBER 1971
OCTOBER 1971
NOVEMBER 1971
DECEMBER 1971
JANUARY 1972
FEBRUARY 1972
MARCH 1972
APRIL 1972
MAY 1972
JUNE 1972
JULY 1972
AUGUST 1972
SEPTEMBER 1972
OCTOBER 1972
NOVEMBER 1972
DECEMBER 1972
CHARLES BRUNING COMPANY
CROSS SECTION 10 x 10
PRINTED IN U.S.A.