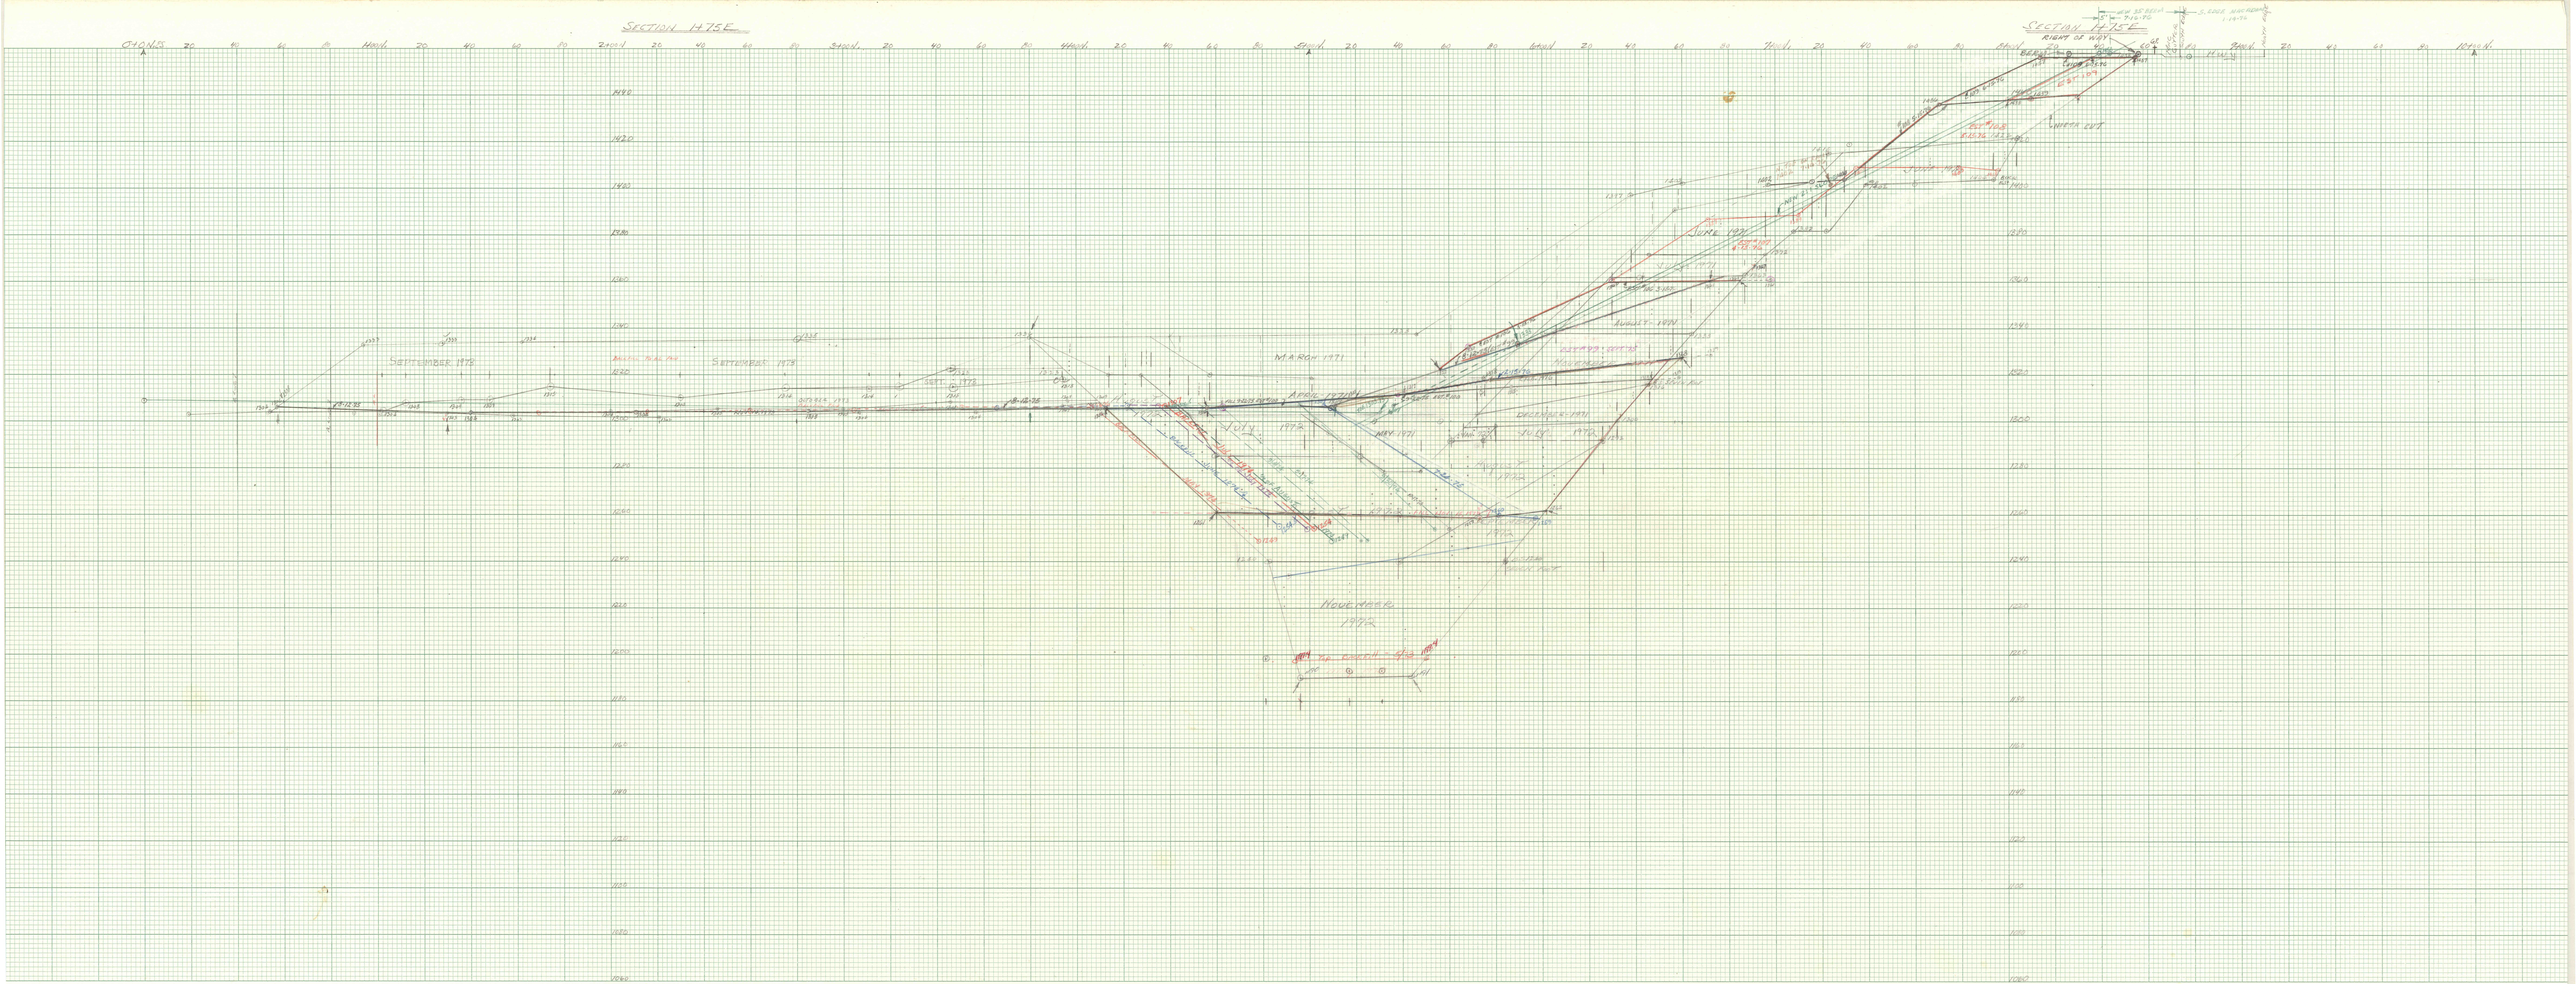
SECTION 1475E
SECTION 1475E
RIGHT OF WAY
SEPTEMBER 1972
SEPTEMBER 1973
MARCH 1971
APRIL 1971
MAY 1971
JUNE 1971
JULY 1972
AUGUST 1971
NOVEMBER 1972
CONCRETE 1971
CREEK FACE
CHARLES BRUNING COMPANY
CROSS SECTION 10 x 10
PRINTED IN U.S.A.