SECTION - 10+75 E

SECTION 10+75 E

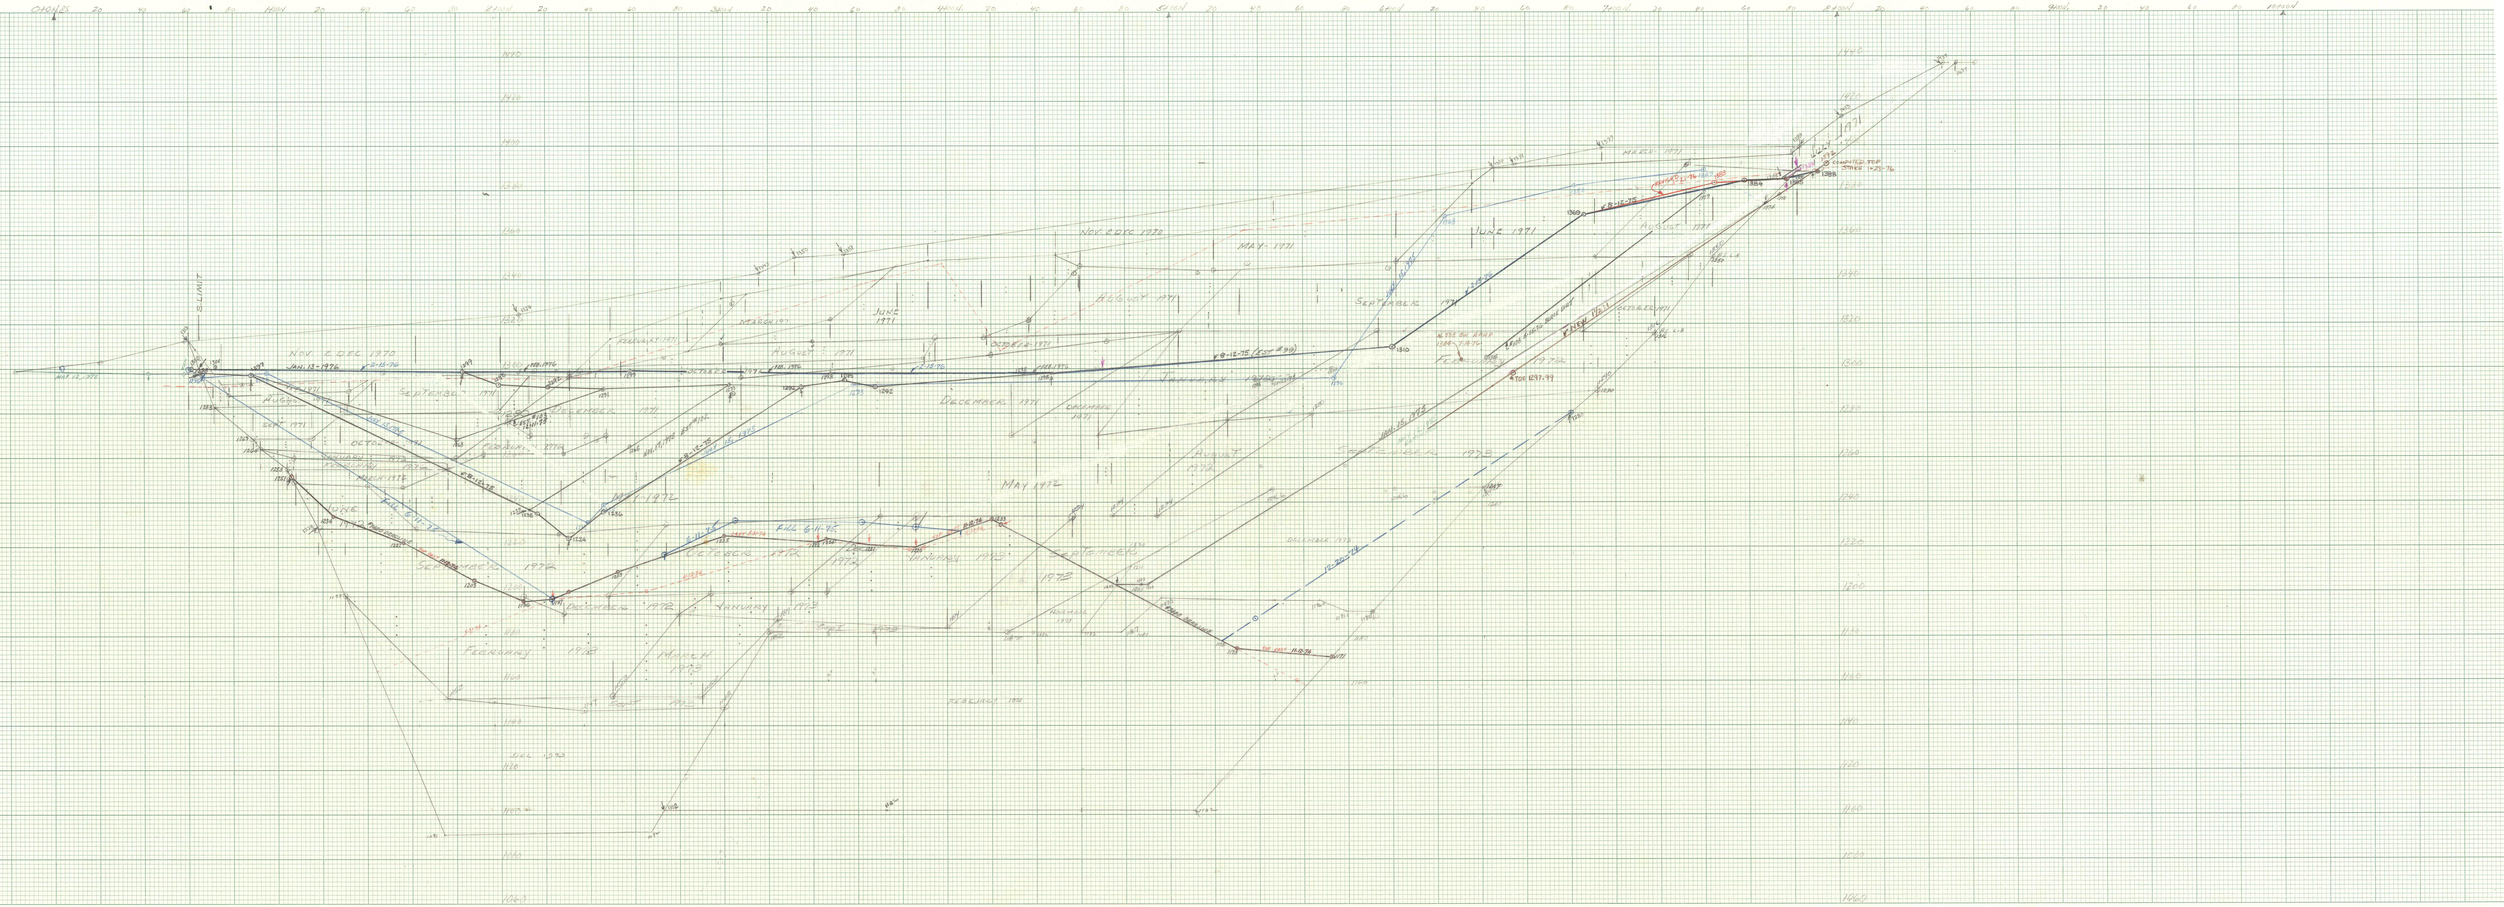
0+00 N
20
40
60
80
1+00 N
2+00 N
3+00 N
4+00 N
5+00 N
6+00 N
7+00 N
8+00 N
9+00 N
10+00 N
1960
1940
1920
1900
1880
1860
1840
1820
1800
1780
1760
1740
1720
1700
1680
1660
1640
1620
1600
1580
1560
1540
1520
1500
1480
1460
1440
1420
1400
1380
1360
1340
1320
1300
1280
1260
1240
1220
1200
1180
1160
1140
1120
1100
1080
1060
1040
1020
1000
980
960
940
920
900
880
860
840
820
800
780
760
740
720
700
680
660
640
620
600
580
560
540
520
500
480
460
440
420
400
380
360
340
320
300
280
260
240
220
200
180
160
140
120
100
80
60
40
20
0
E LIMIT
NOV. & DEC. 1970
JAN. 13 - 1976
FEB. 15 - 1976
SEPTEMBER 1971
AUGUST 1971
JULY 1971
JUNE 1971
MAY 1971
MARCH 1971
FEBRUARY 1971
JANUARY 1971
DECEMBER 1971
NOVEMBER 1971
OCTOBER 1971
SEPT. 1971
MAY 1972
JUNE 1972
JULY 1972
AUGUST 1972
SEPTEMBER 1972
OCTOBER 1972
NOVEMBER 1972
DECEMBER 1972
JANUARY 1973
FEBRUARY 1973
MARCH 1973
APRIL 1973
MAY 1973
JUNE 1973
JULY 1973
AUGUST 1973
SEPTEMBER 1973
OCTOBER 1973
NOVEMBER 1973
DECEMBER 1973
JANUARY 1974
FEBRUARY 1974
MARCH 1974
APRIL 1974
MAY 1974
JUNE 1974
JULY 1974
AUGUST 1974
SEPTEMBER 1974
OCTOBER 1974
NOVEMBER 1974
DECEMBER 1974
JANUARY 1975
FEBRUARY 1975
MARCH 1975
APRIL 1975
MAY