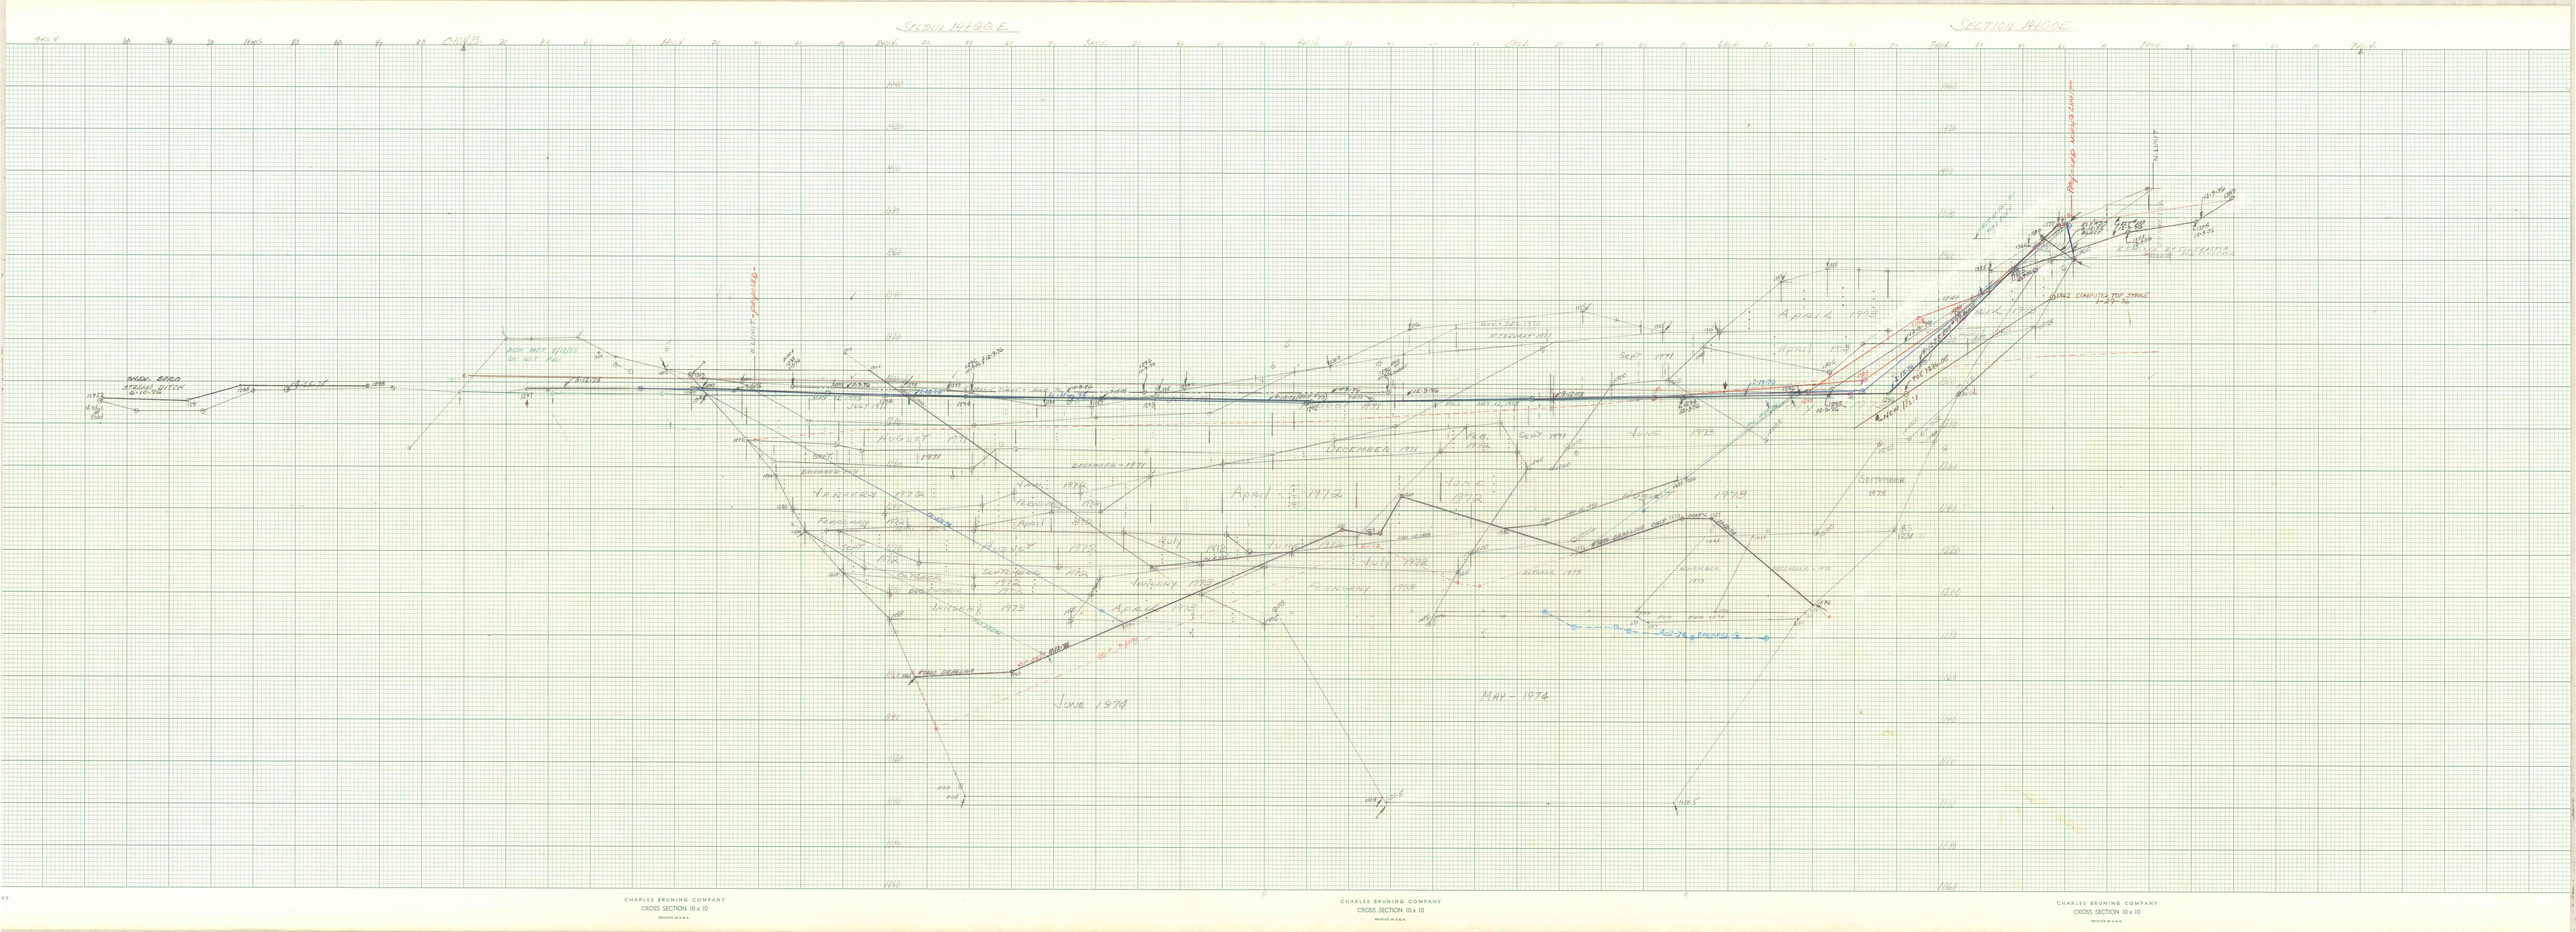
SECTION 14400 E
SECTION 14400 E
CHAINS
HIGH BOCO
STREAM DITCH
6-10-76
HIGH WATER ELEVATION
DO NOT FILL
BUILDING
N. LIGHT
PROPOSED MINING LIMIT
N. LIGHT
EXISTING GROUND
DRILL HOLE
COMPUTED TOP STRIKE
TOP ITEM
ELEVATION
DRILL HOLE
ELEVATION
HOLE DELETED
DECEMBER 1971
SEPT 1971
JUNE 1972
DECEMBER 1971
JANUARY 1972
APRIL 1972
JUNE 1972
JANUARY 1973
APRIL 1973
JUNE 1973
SEPTEMBER 1973
DECEMBER 1973
JANUARY 1974
APRIL 1974
JUNE 1974
SEPTEMBER 1974
DECEMBER 1974
JANUARY 1975
APRIL 1975
JUNE 1975
SEPTEMBER 1975
DECEMBER 1975
JANUARY 1976
APRIL 1976
JUNE 1976
MAY - 1976
EXISTING GROUND
PROPOSED
BENCH 5 - 6
CHARLES BRUNING COMPANY
CROSS SECTION 10 x 10
PRINTED IN U.S.A.
CHARLES BRUNING COMPANY
CROSS SECTION 10 x 10
PRINTED IN U.S.A.
CHARLES BRUNING COMPANY
CROSS SECTION 10 x 10
PRINTED IN U.S.A.