SECTION 14+50E.

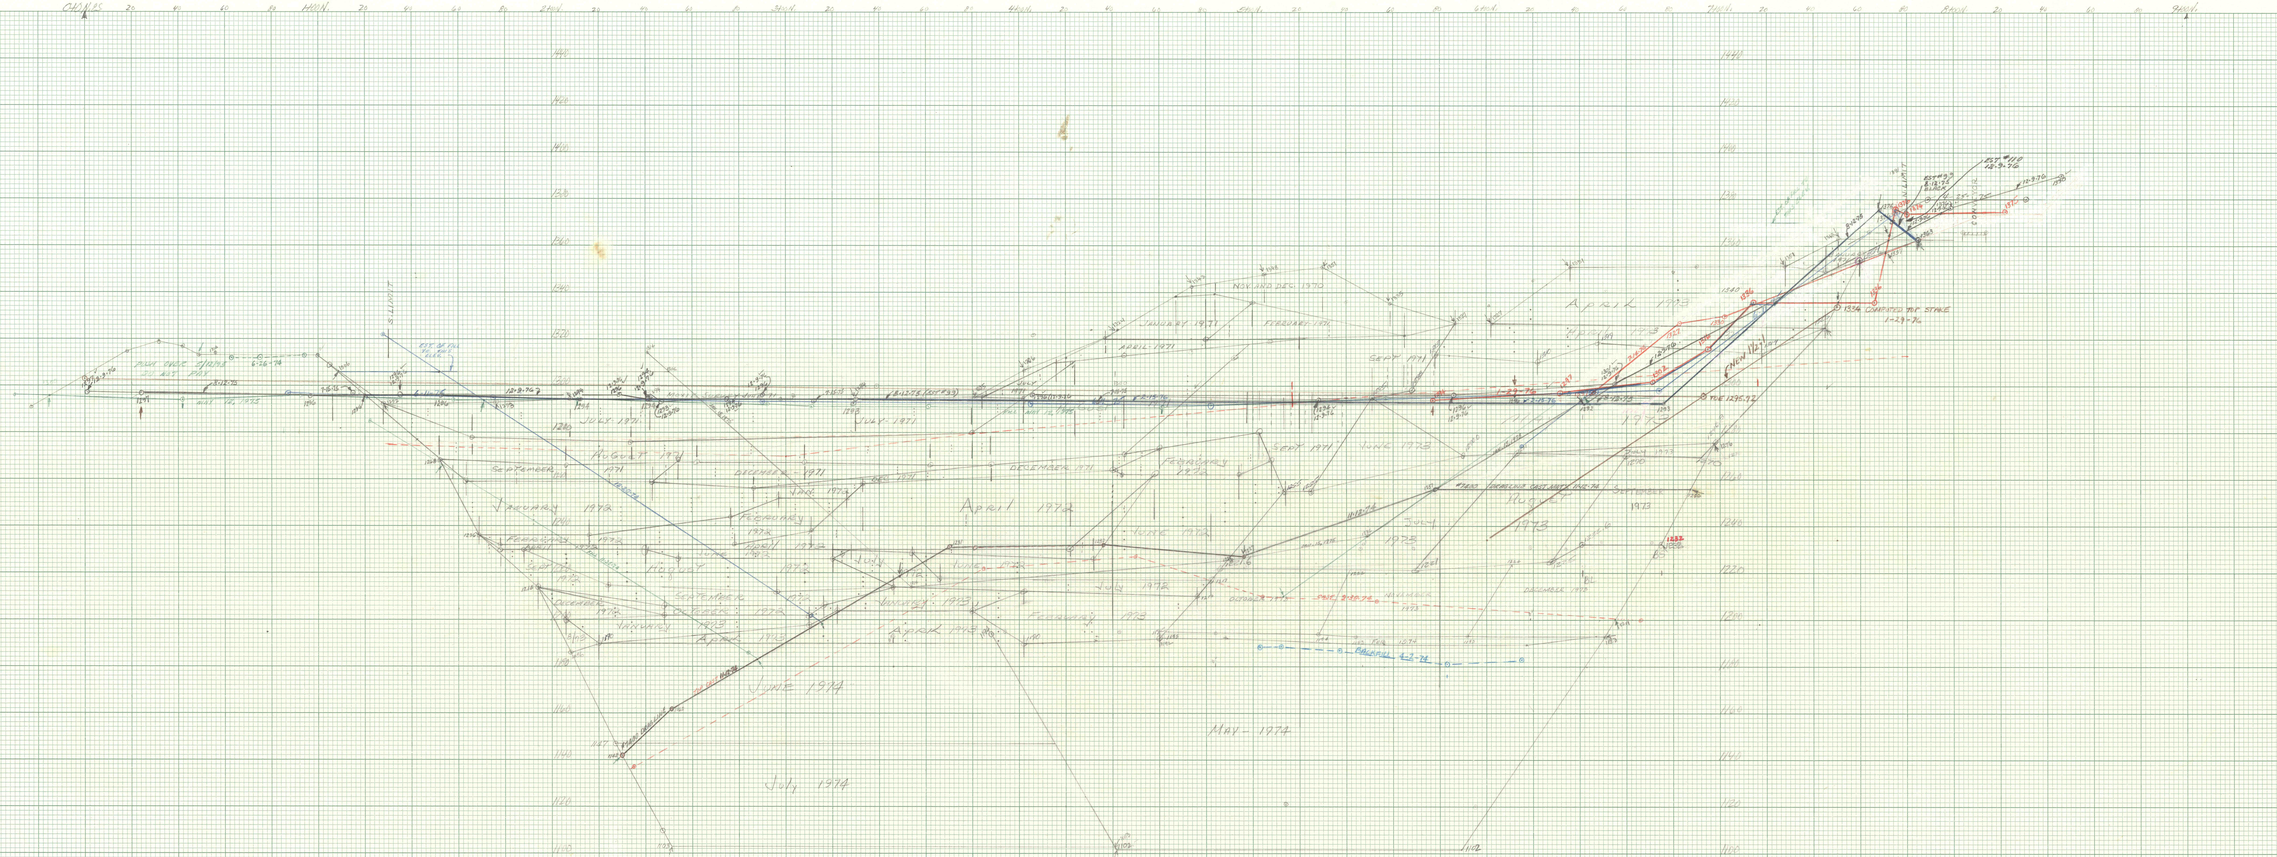

CHARLES BRUNING COMPANY
CROSS SECTION 10 x 10
PRINTED IN U.S.A.
CHARLES BRUNING COMPANY
CROSS SECTION 10 x 10
PRINTED IN U.S.A.
CHARLES BRUNING COMPANY
CROSS SECTION 10 x 10
PRINTED IN U.S.A.
CHARLES BRUNING COMPANY
CROSS SECTION 10 x 10
PRINTED IN U.S.A.