


SECTIONS ALONG DITCH - 4/25/75


40 60 80 17+00E 20 40 60 80

16+00E 20 40 60 80 17+00E 20 40 60 80


16+00E 20 40 60 80 17+00E 20 40 60 80 18+00E

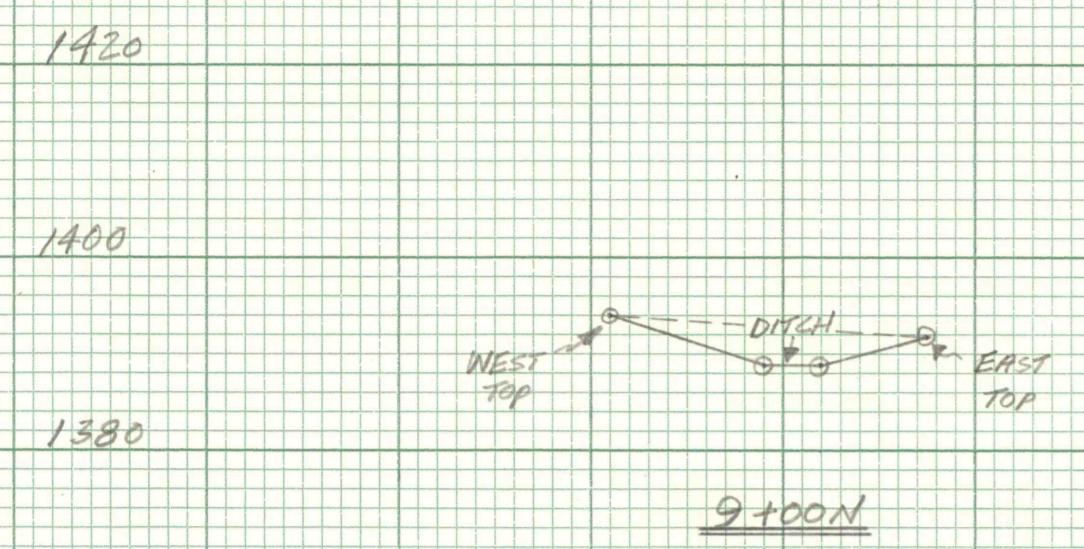


9+00N

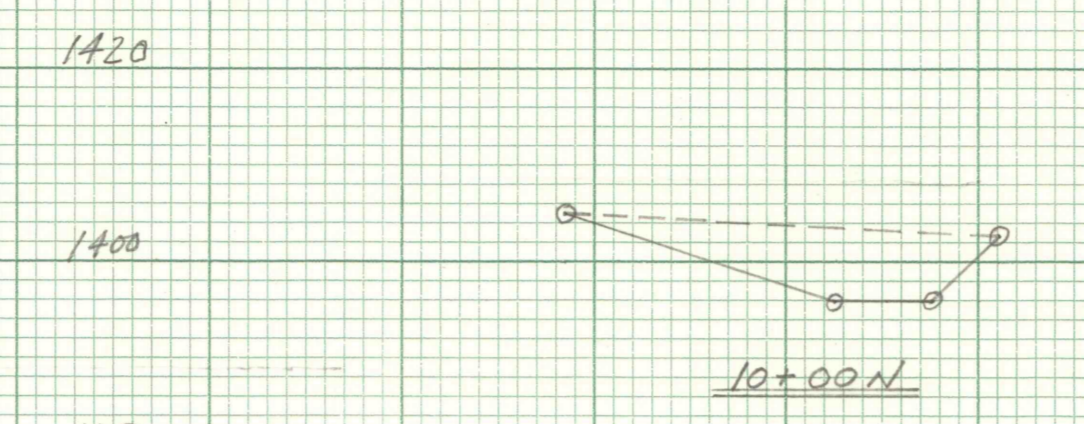


10+00N

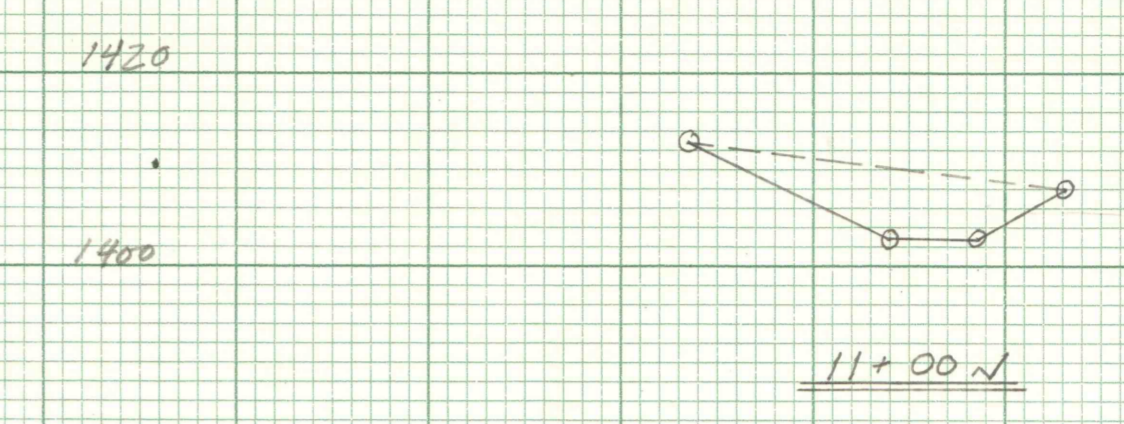


11+00N

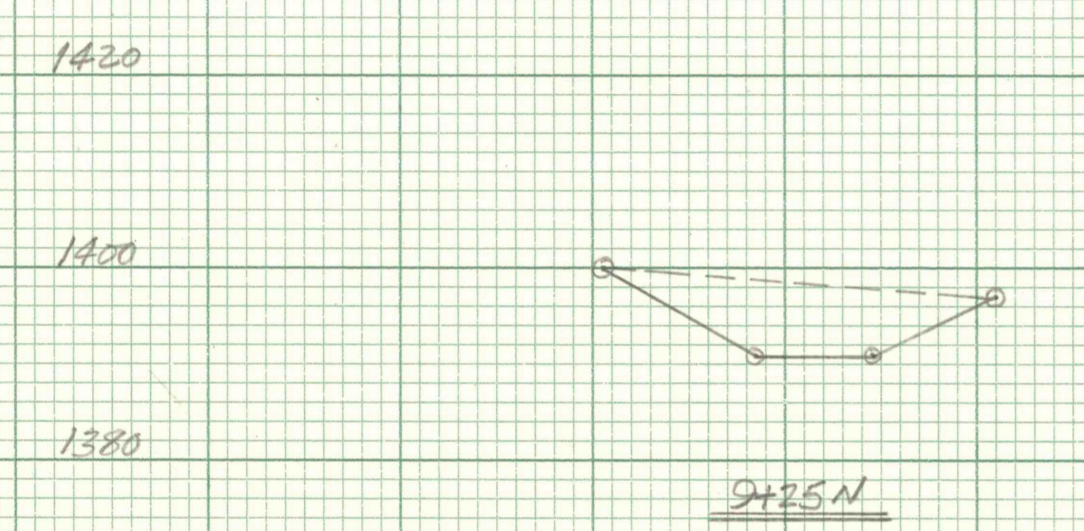


9+25N

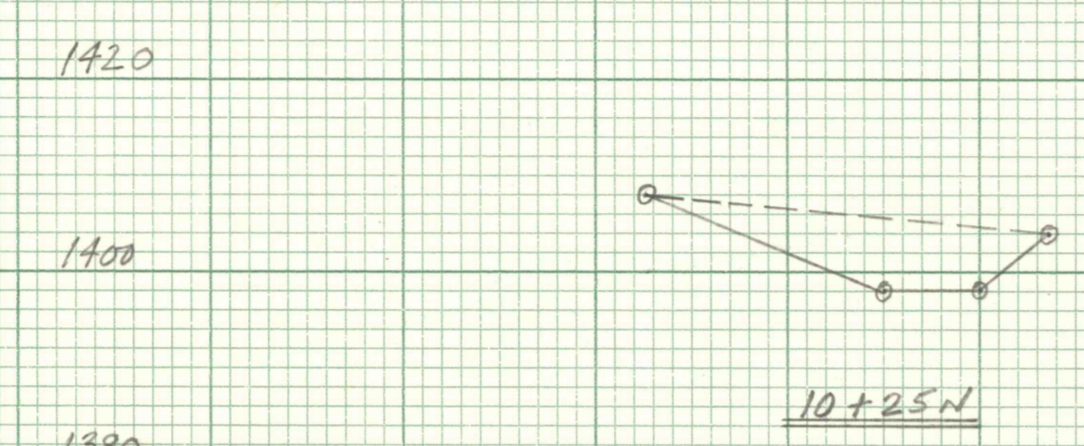


10+25N

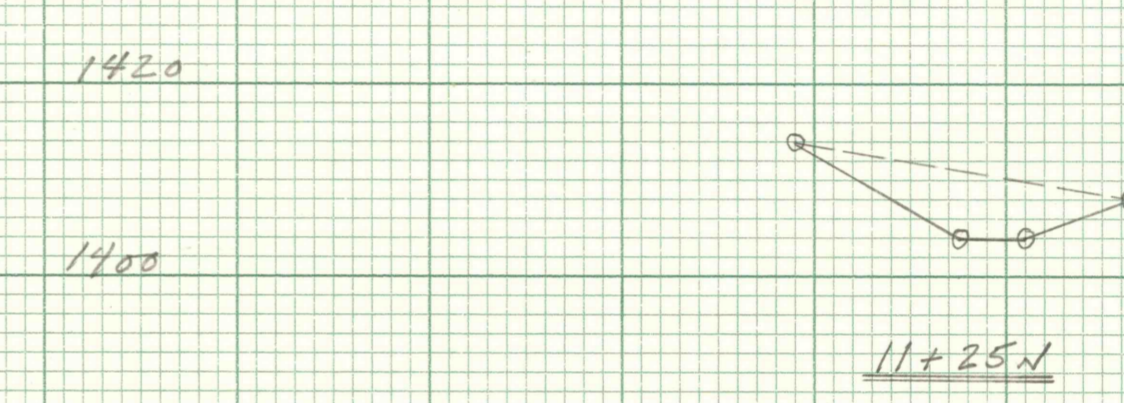


11+25N

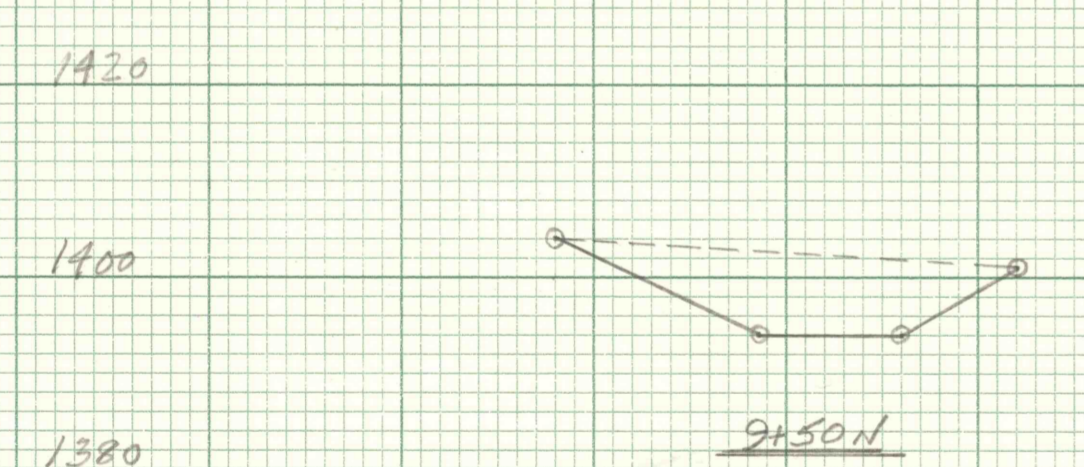


9+50N

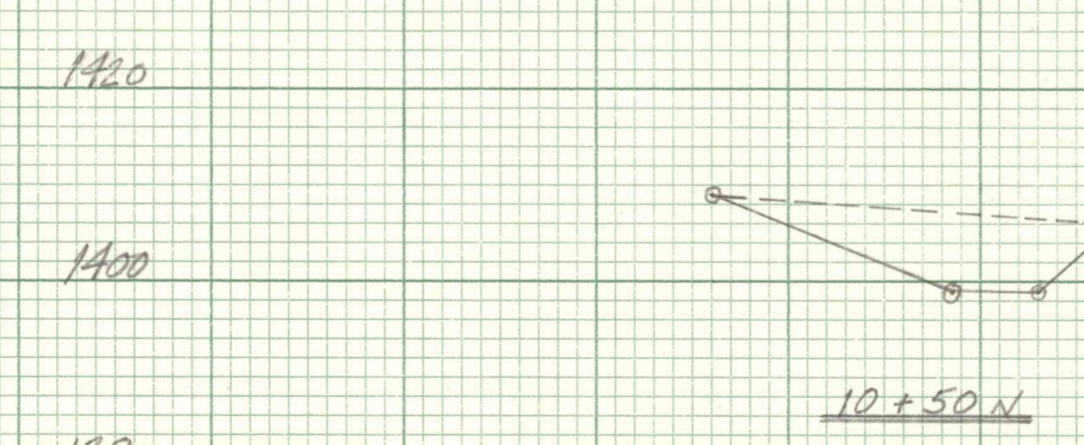

10+50N

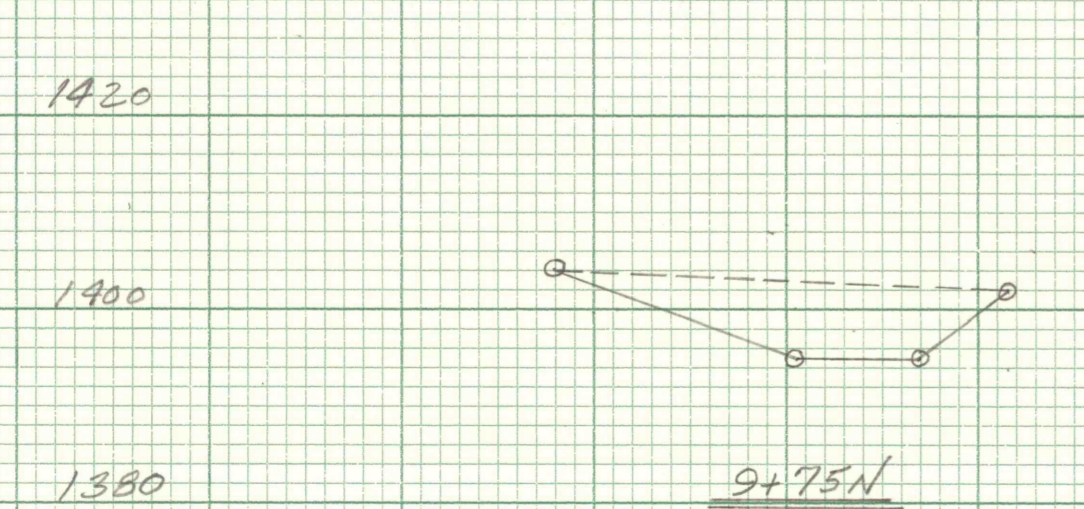

9+75N

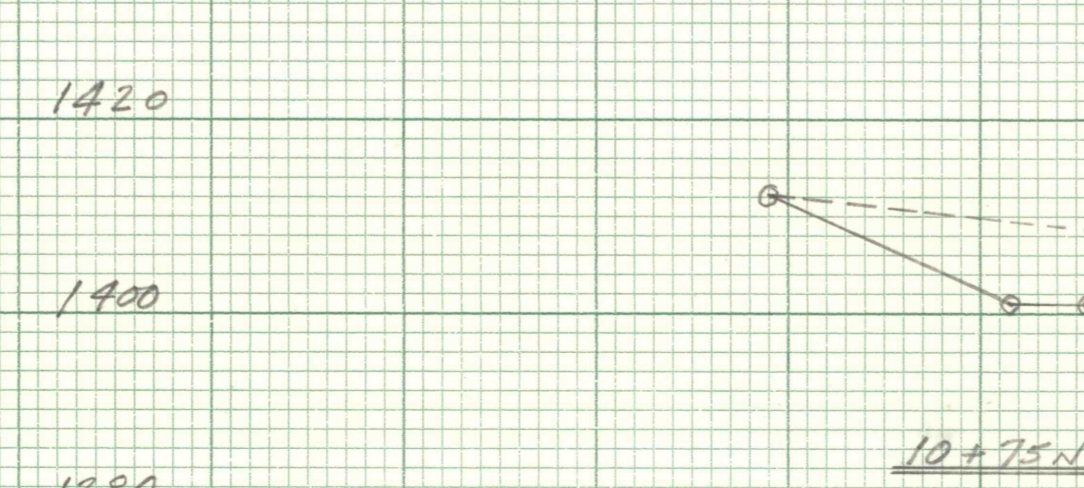

10+75N