SECTION 14+15 E

SECTION 14+15 E.

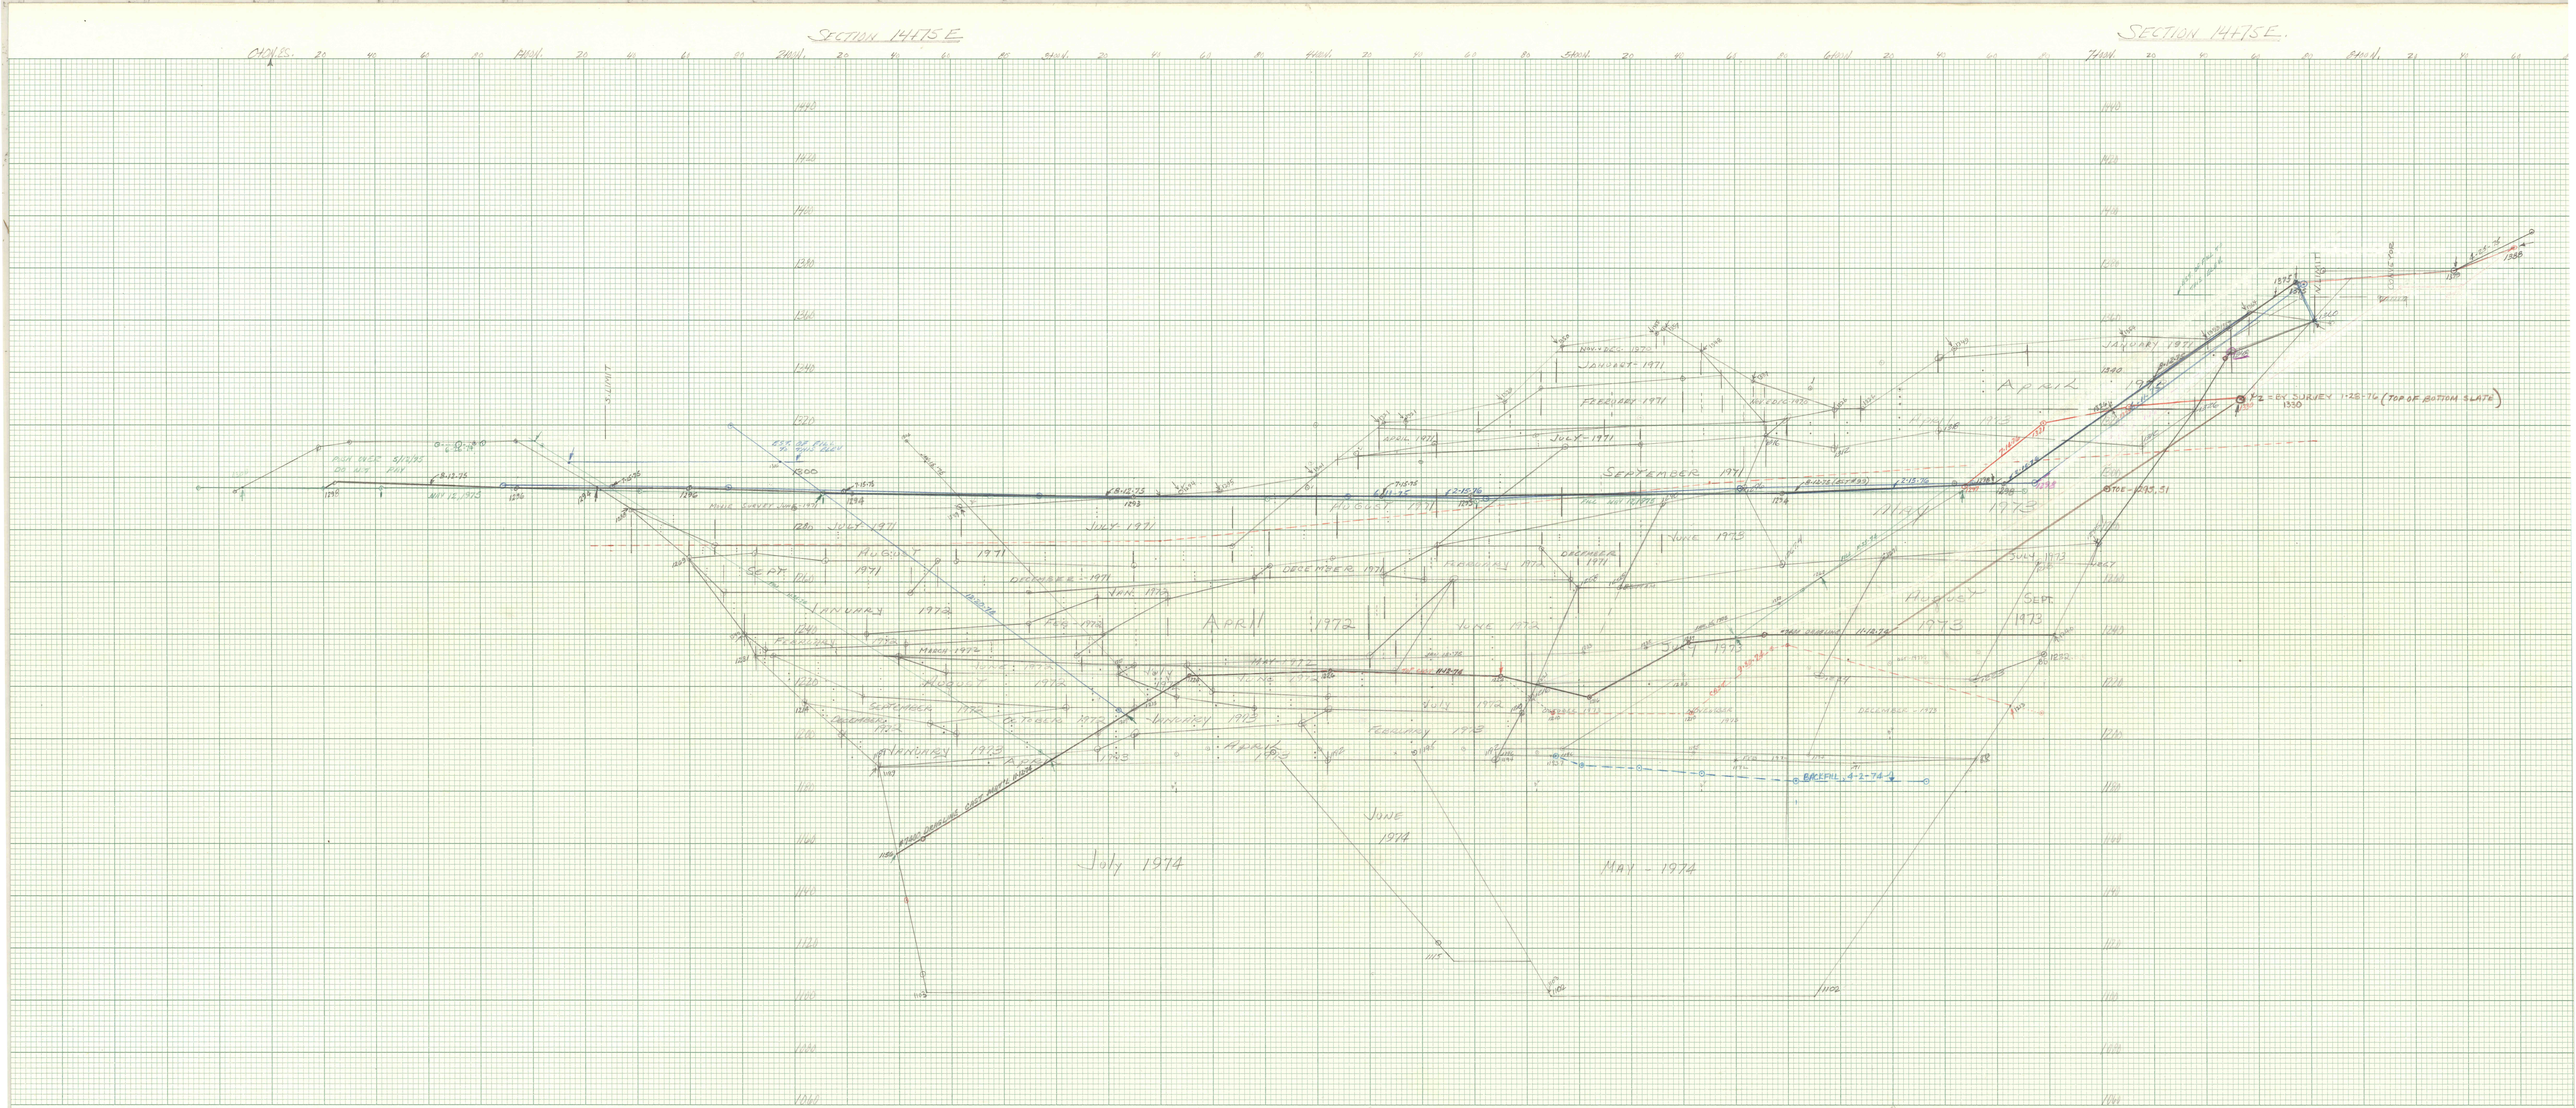
CHAINS
SURVEY JULY 1971
