SECTION 18+25 E.

SECTION 18+25 E.

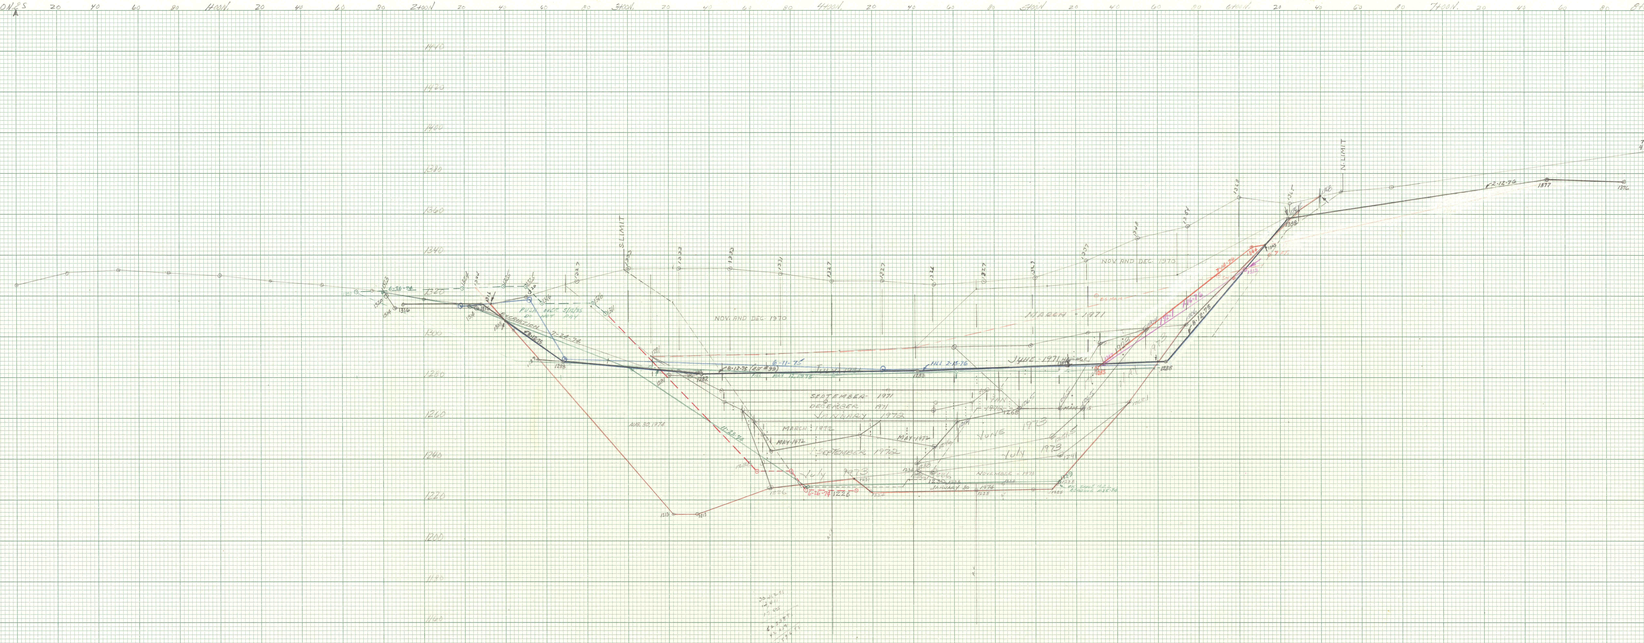
NOV. RNG DEC. 1970
NOV. RNG DEC. 1970
SEPTEMBER 1971
OCTOBER 1971
MARCH 1972
MARCH 1972
JUNE 1973
JUNE 1973
JUNE 1973