SECTION 18+00 E.

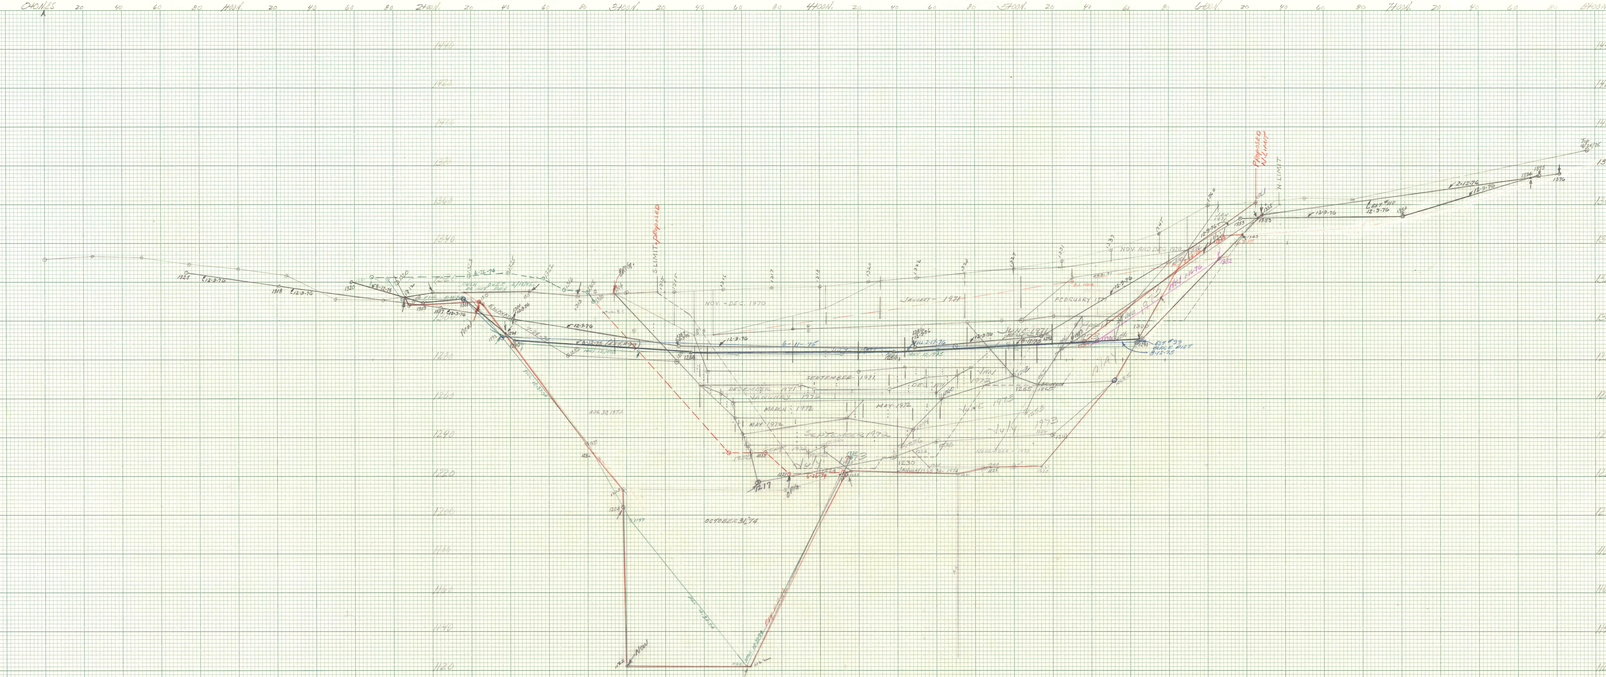

SECTION 18+00 E.

CHARLES BRUNING COMPANY
CROSS SECTION 10 x 10
PRINTED IN U.S.A.
CHARLES BRUNING COMPANY
CROSS SECTION 10 x 10
PRINTED IN U.S.A.
CHARLES BRUNING COMPANY
CROSS SECTION 10 x 10
PRINTED IN U.S.A.
CHARLES BRUNING COMPANY
CROSS SECTION 10 x 10
PRINTED IN U.S.A.