SECTION 20+00E.

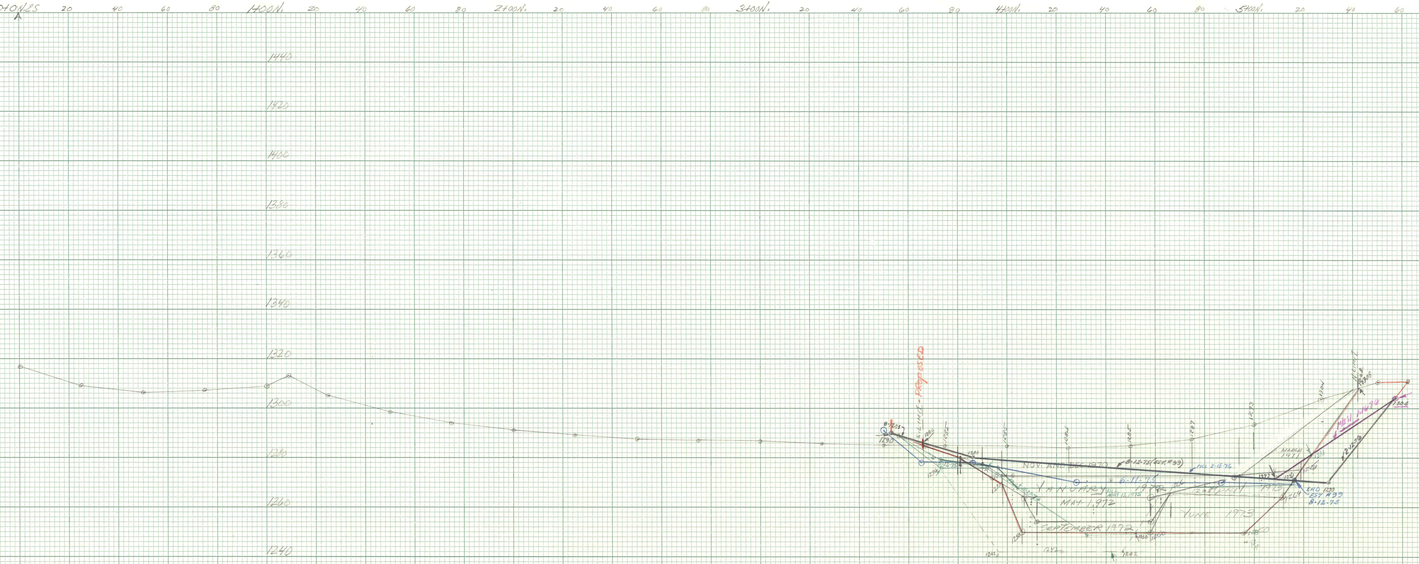
PROPOSED
EXISTING
1324
1344
1342
-2
-4
