SECTION 15+50E
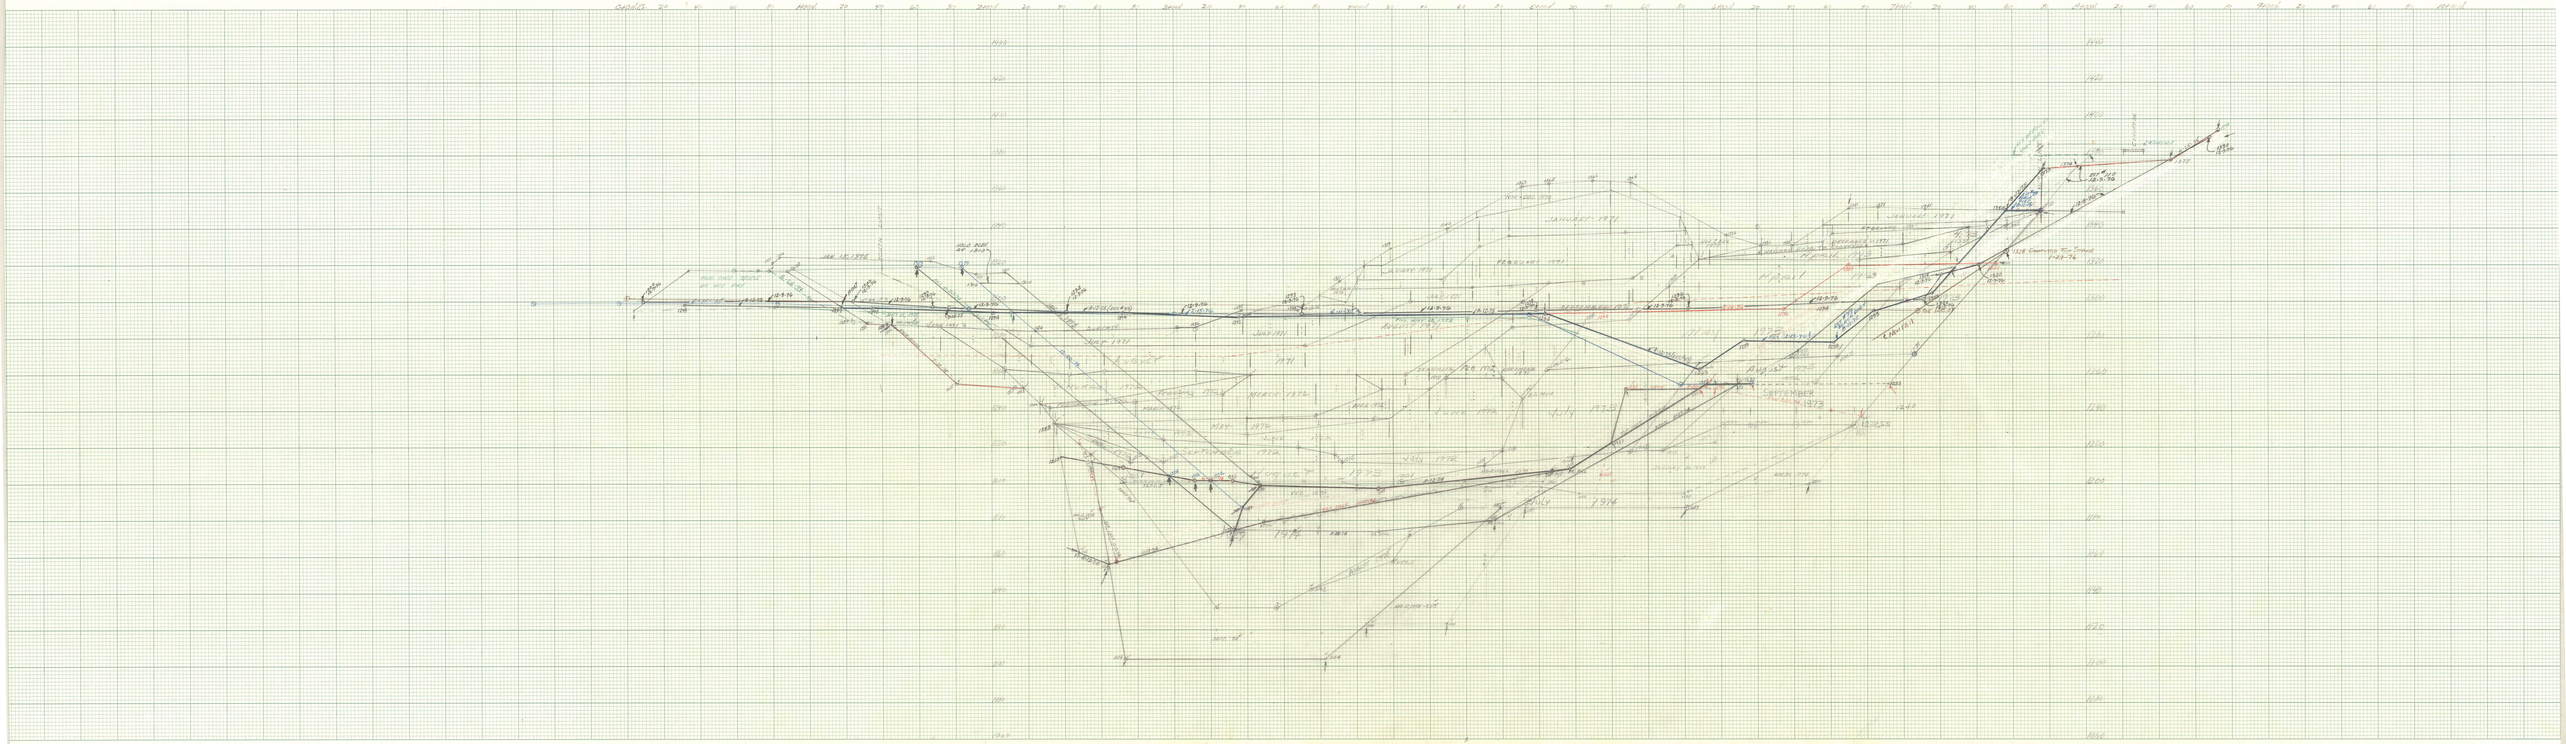
SECTION 16+50E