SECTION 17N25E

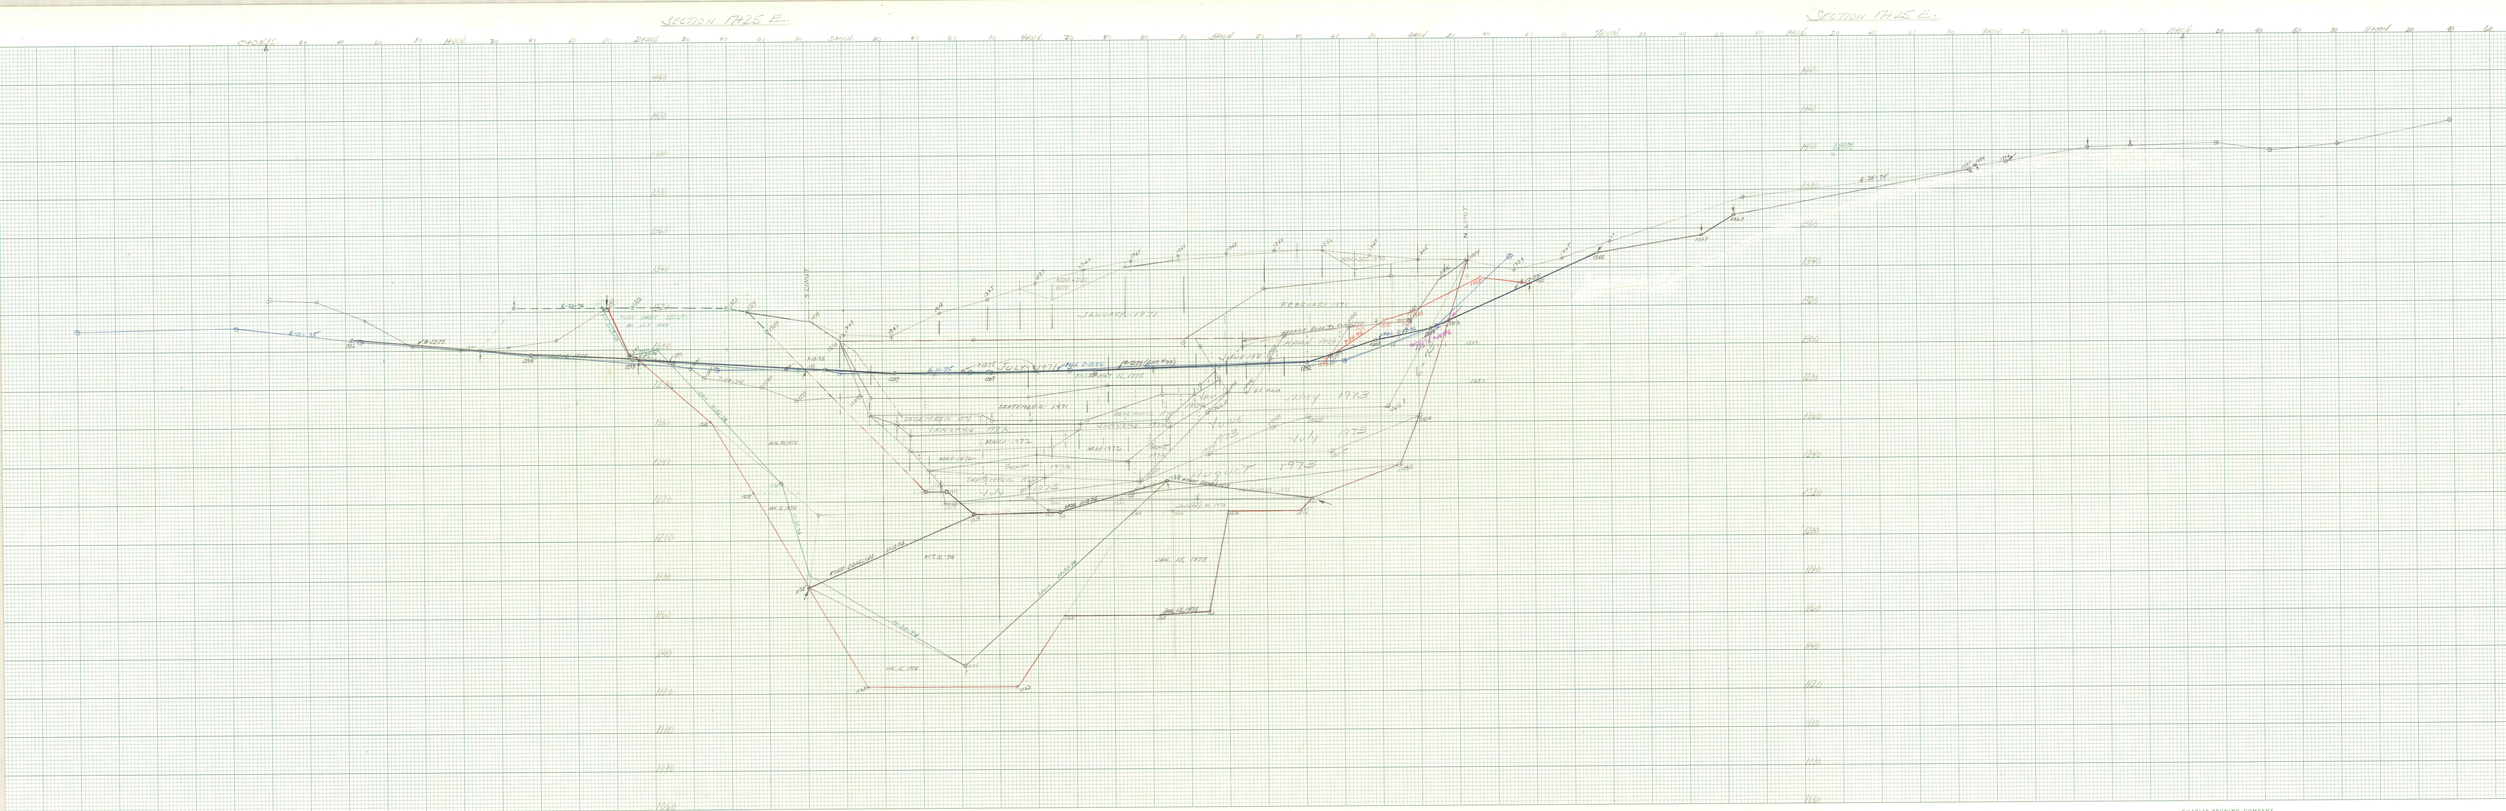

SECTION 17N25E

CHARLES BRUNING COMPANY
CROSS SECTION 10 x 10
PRINTED IN U.S.A.



