SECTION 16+25 E.

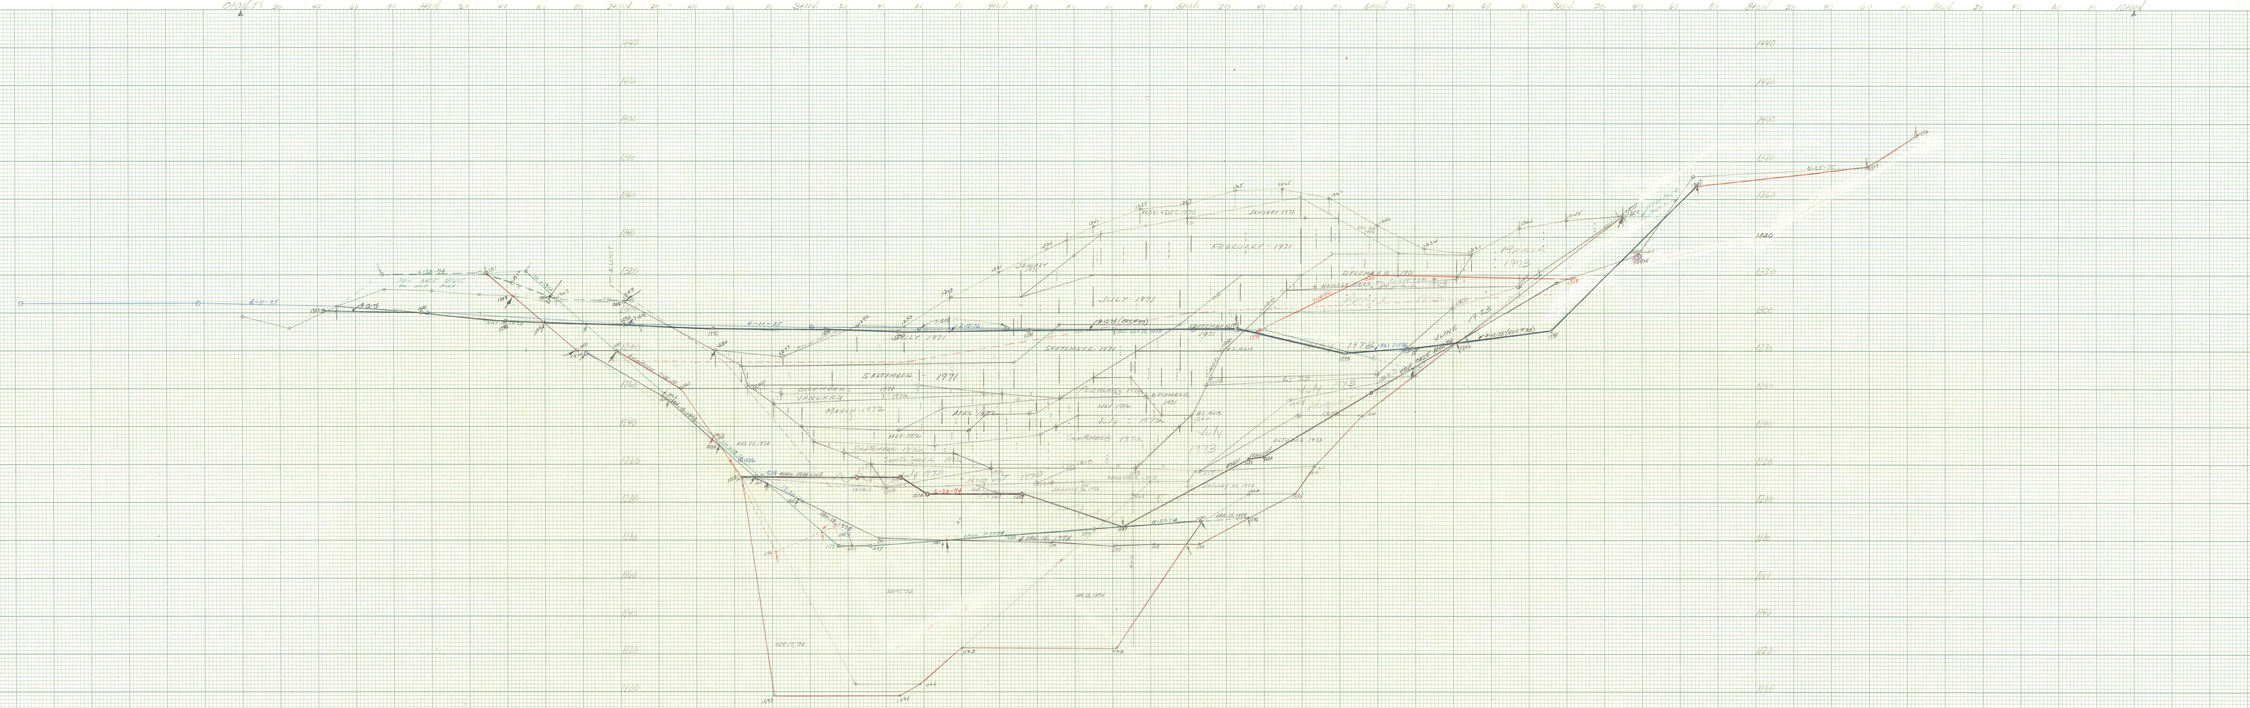

CHARLES BRUNING COMPANY
CROSS SECTION 10 x 10
PRINTED IN U.S.A.