SECTION 16+00 E.

SECTION 16+00 E.

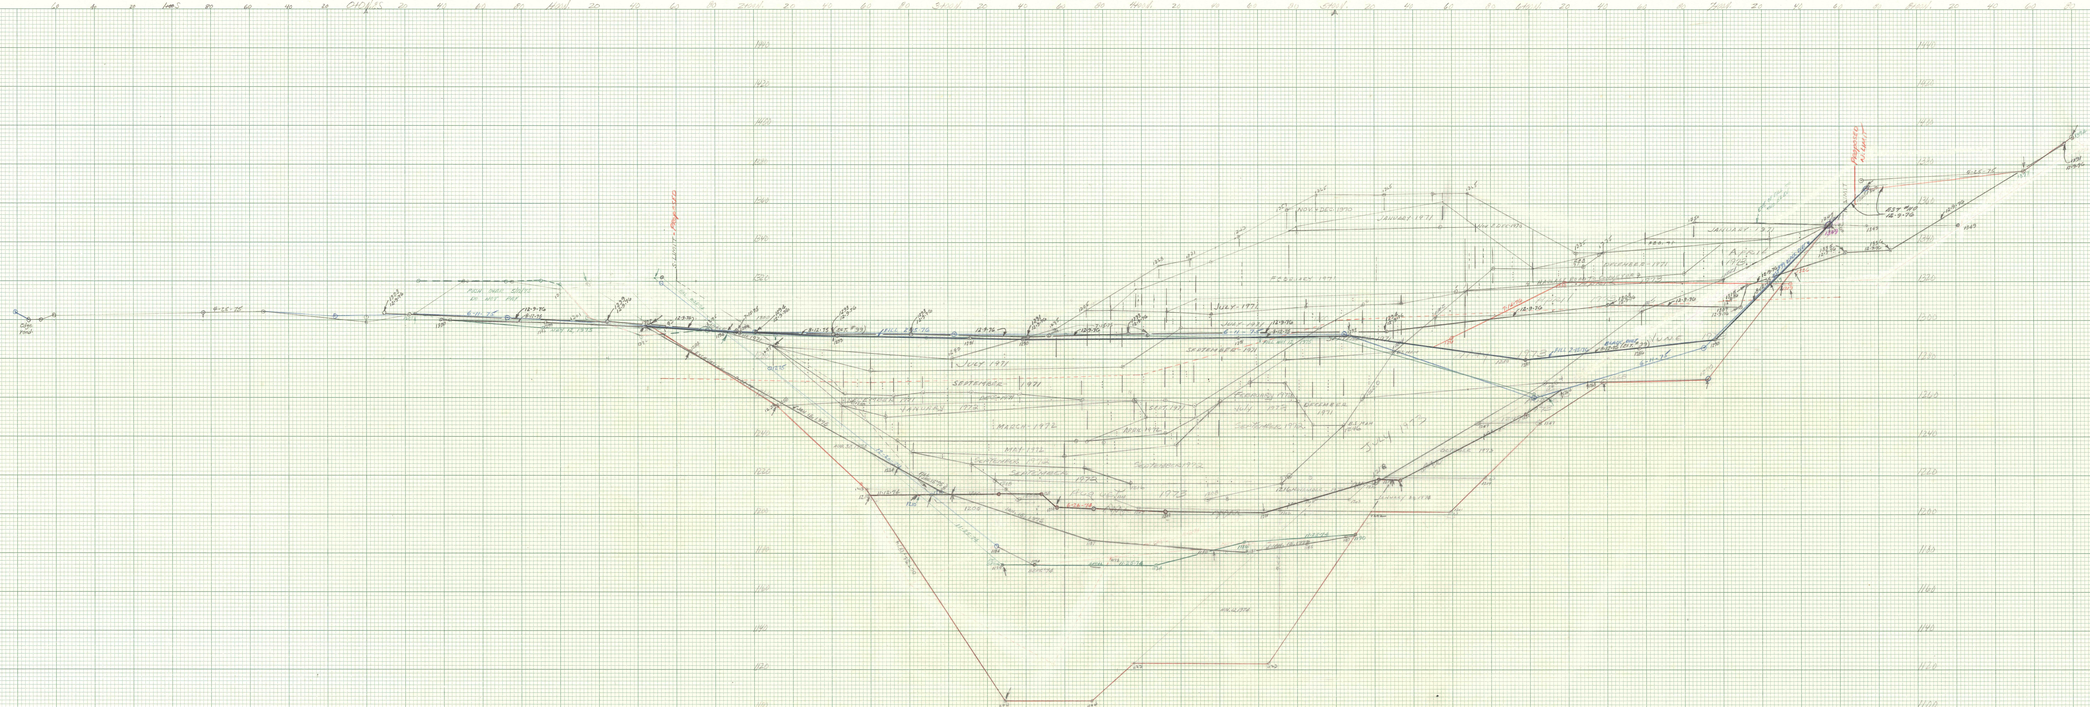

CHARLES BRUNING COMPANY
CROSS SECTION 10 x 10

CHARLES BRUNING COMPANY
CROSS SECTION 10 x 10

CHARLES BRUNING COMPANY
CROSS SECTION 10 x 10

CHARLES BRUNING COMP.
CROSS SECTION 10 x 10