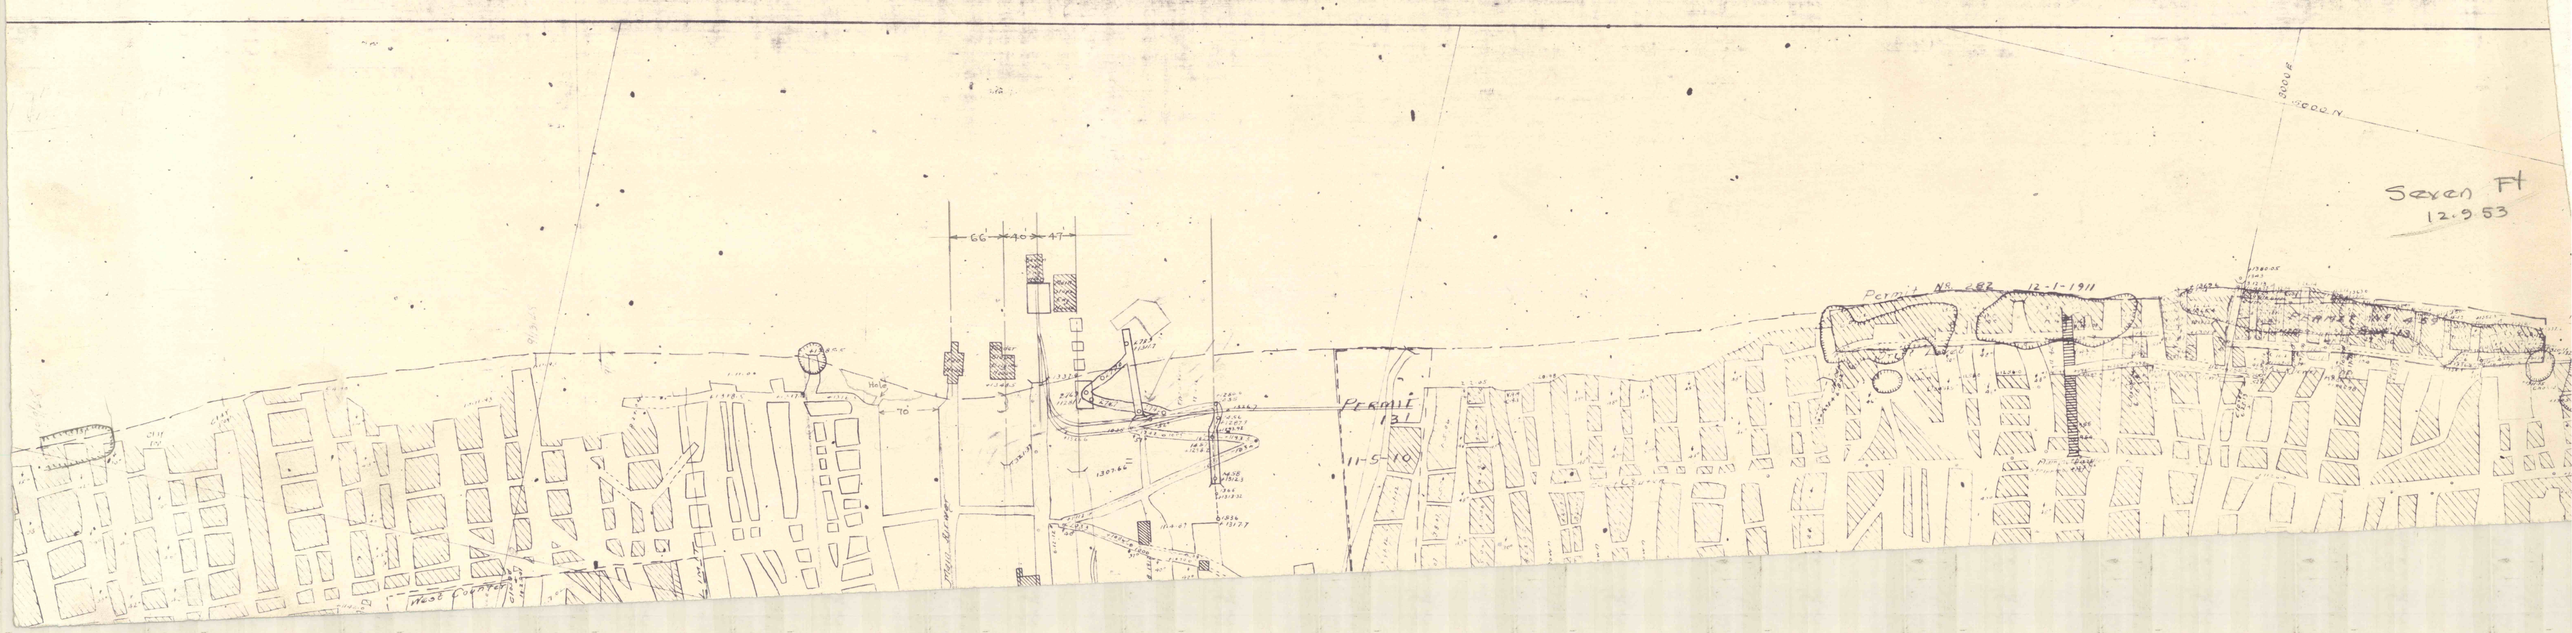
Seven Ft
12.9.53
Permit No. 282 12-1-1911
Permit 131
11-5-10
66'
40'
47'
70'
West Country
Mill Brewer
3000 E
3000 N