

SECTION LINE 6150 W. PACKER NO. 4 BRKR.


WEST SIDE

2200'

BASE LINE

PROPOSED LEASE MAMMOTH VEIN

WEST MAMMOTH STRIPPING

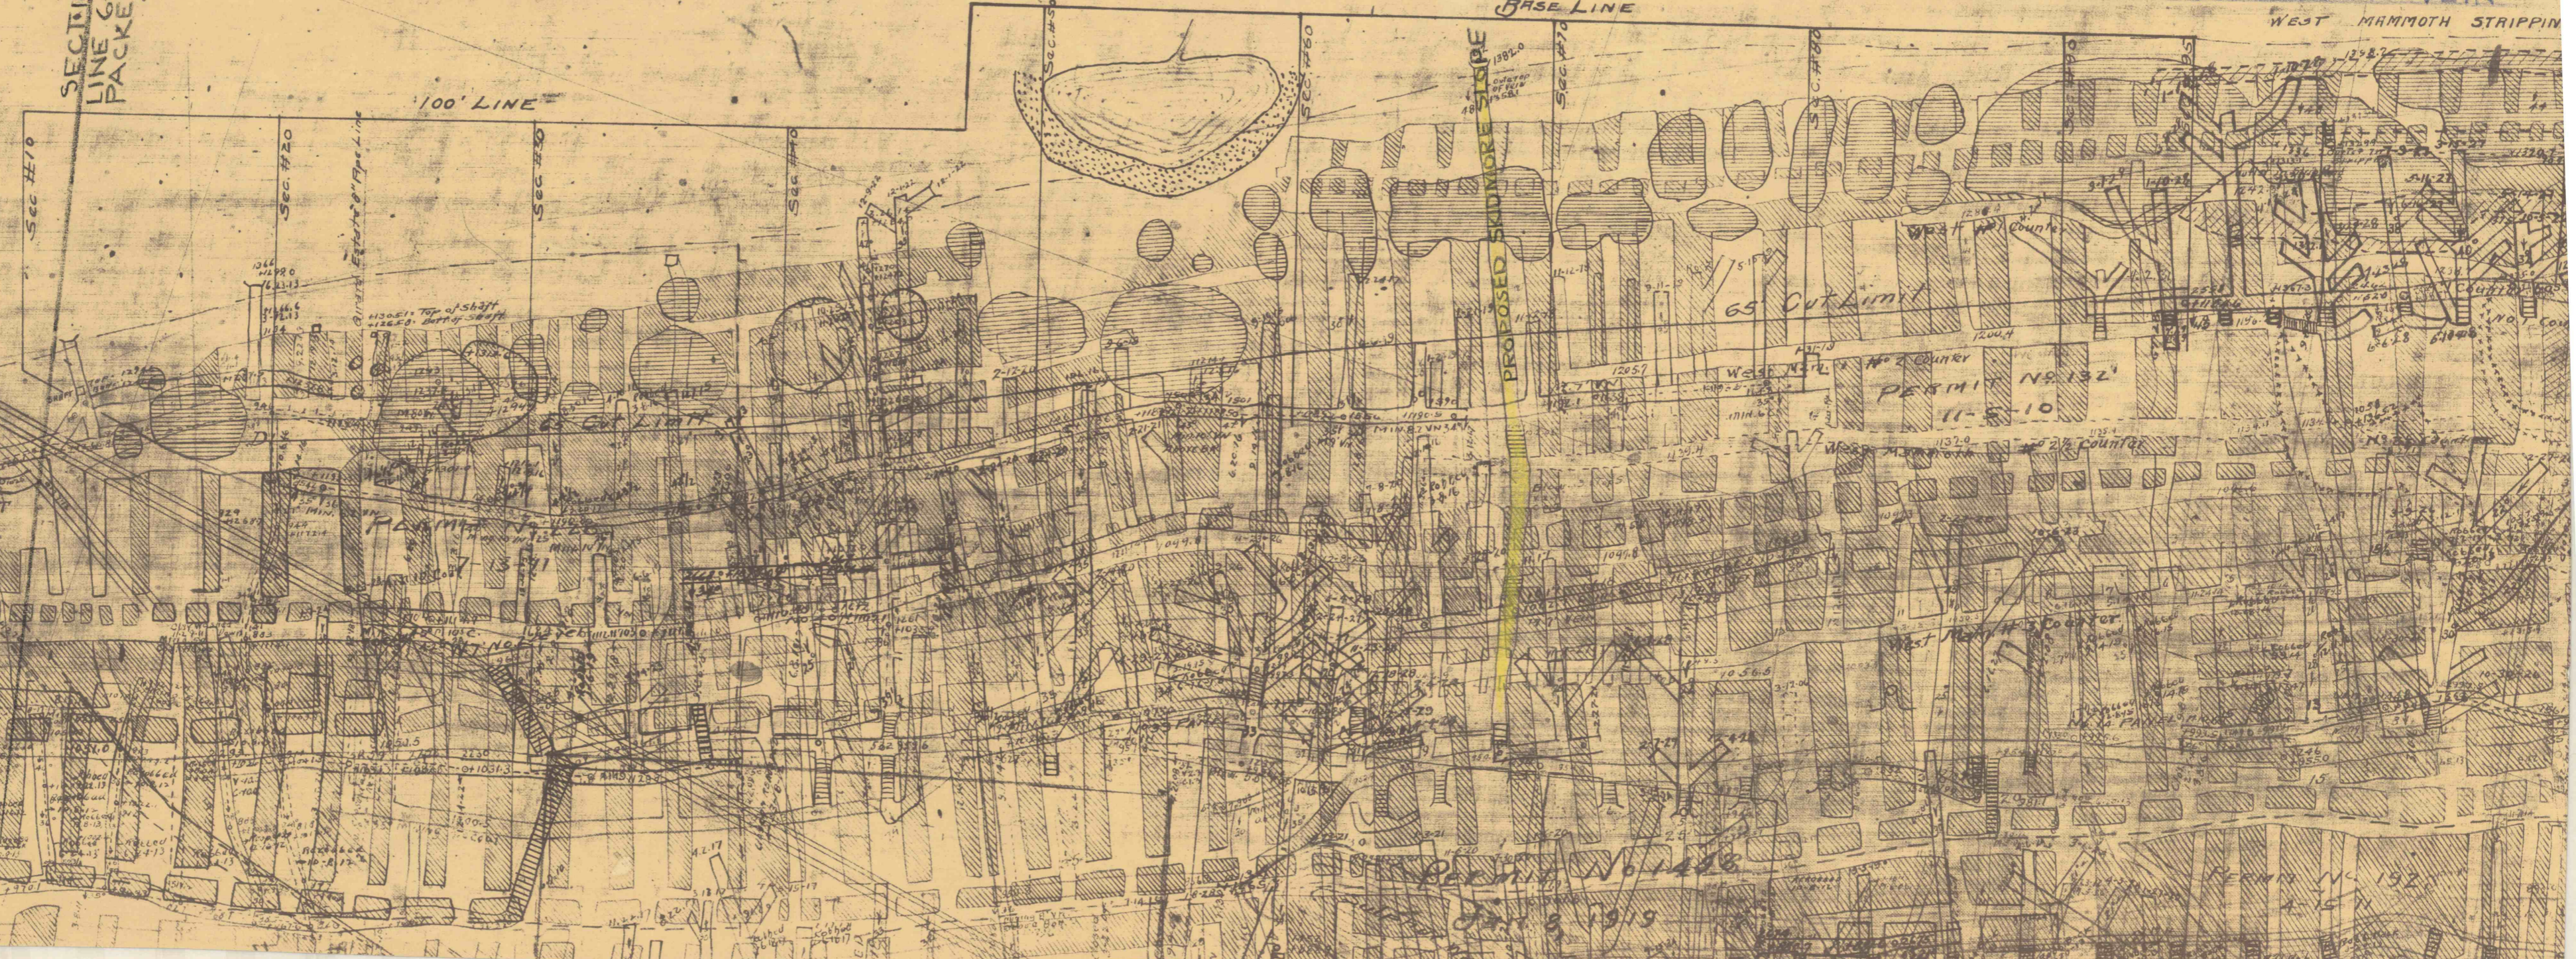

65' Cut Limit

PERMIT NO. 132
11-5-10

PERMIT NO. 148

JAN 9 1919

PERMIT NO. 192
4-15-11