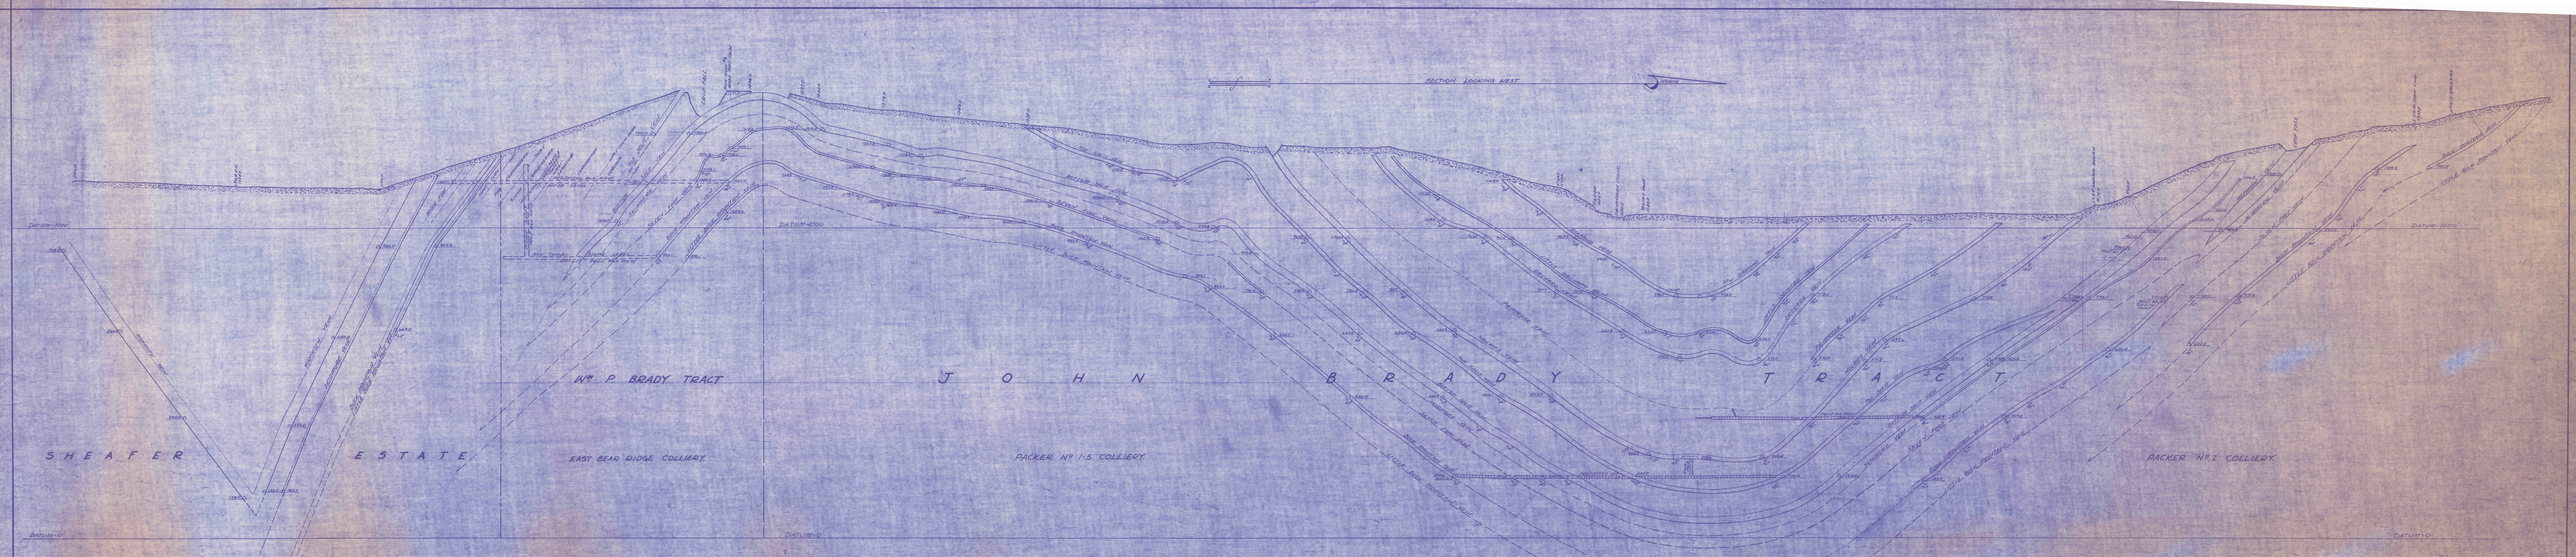

EAST BEAR RIDGE COLLIERY.

Section No. 2 – 470 feet west of Tunnel.

Also { 300 feet west of Tunnel to Primrose 3rd Level Packer No. 2 Colliery.
140 " west " Iron Man 58 on East line Packer 1-5 Colliery LEASE

Scale 1 inch = 100 feet Pottsville, Pa. W. PARKER BULLMASTER.
JANUARY 1/1/93 Mining Engineer & Expert Under Oath.

SECTION H MAP NO 100 B BOX 31