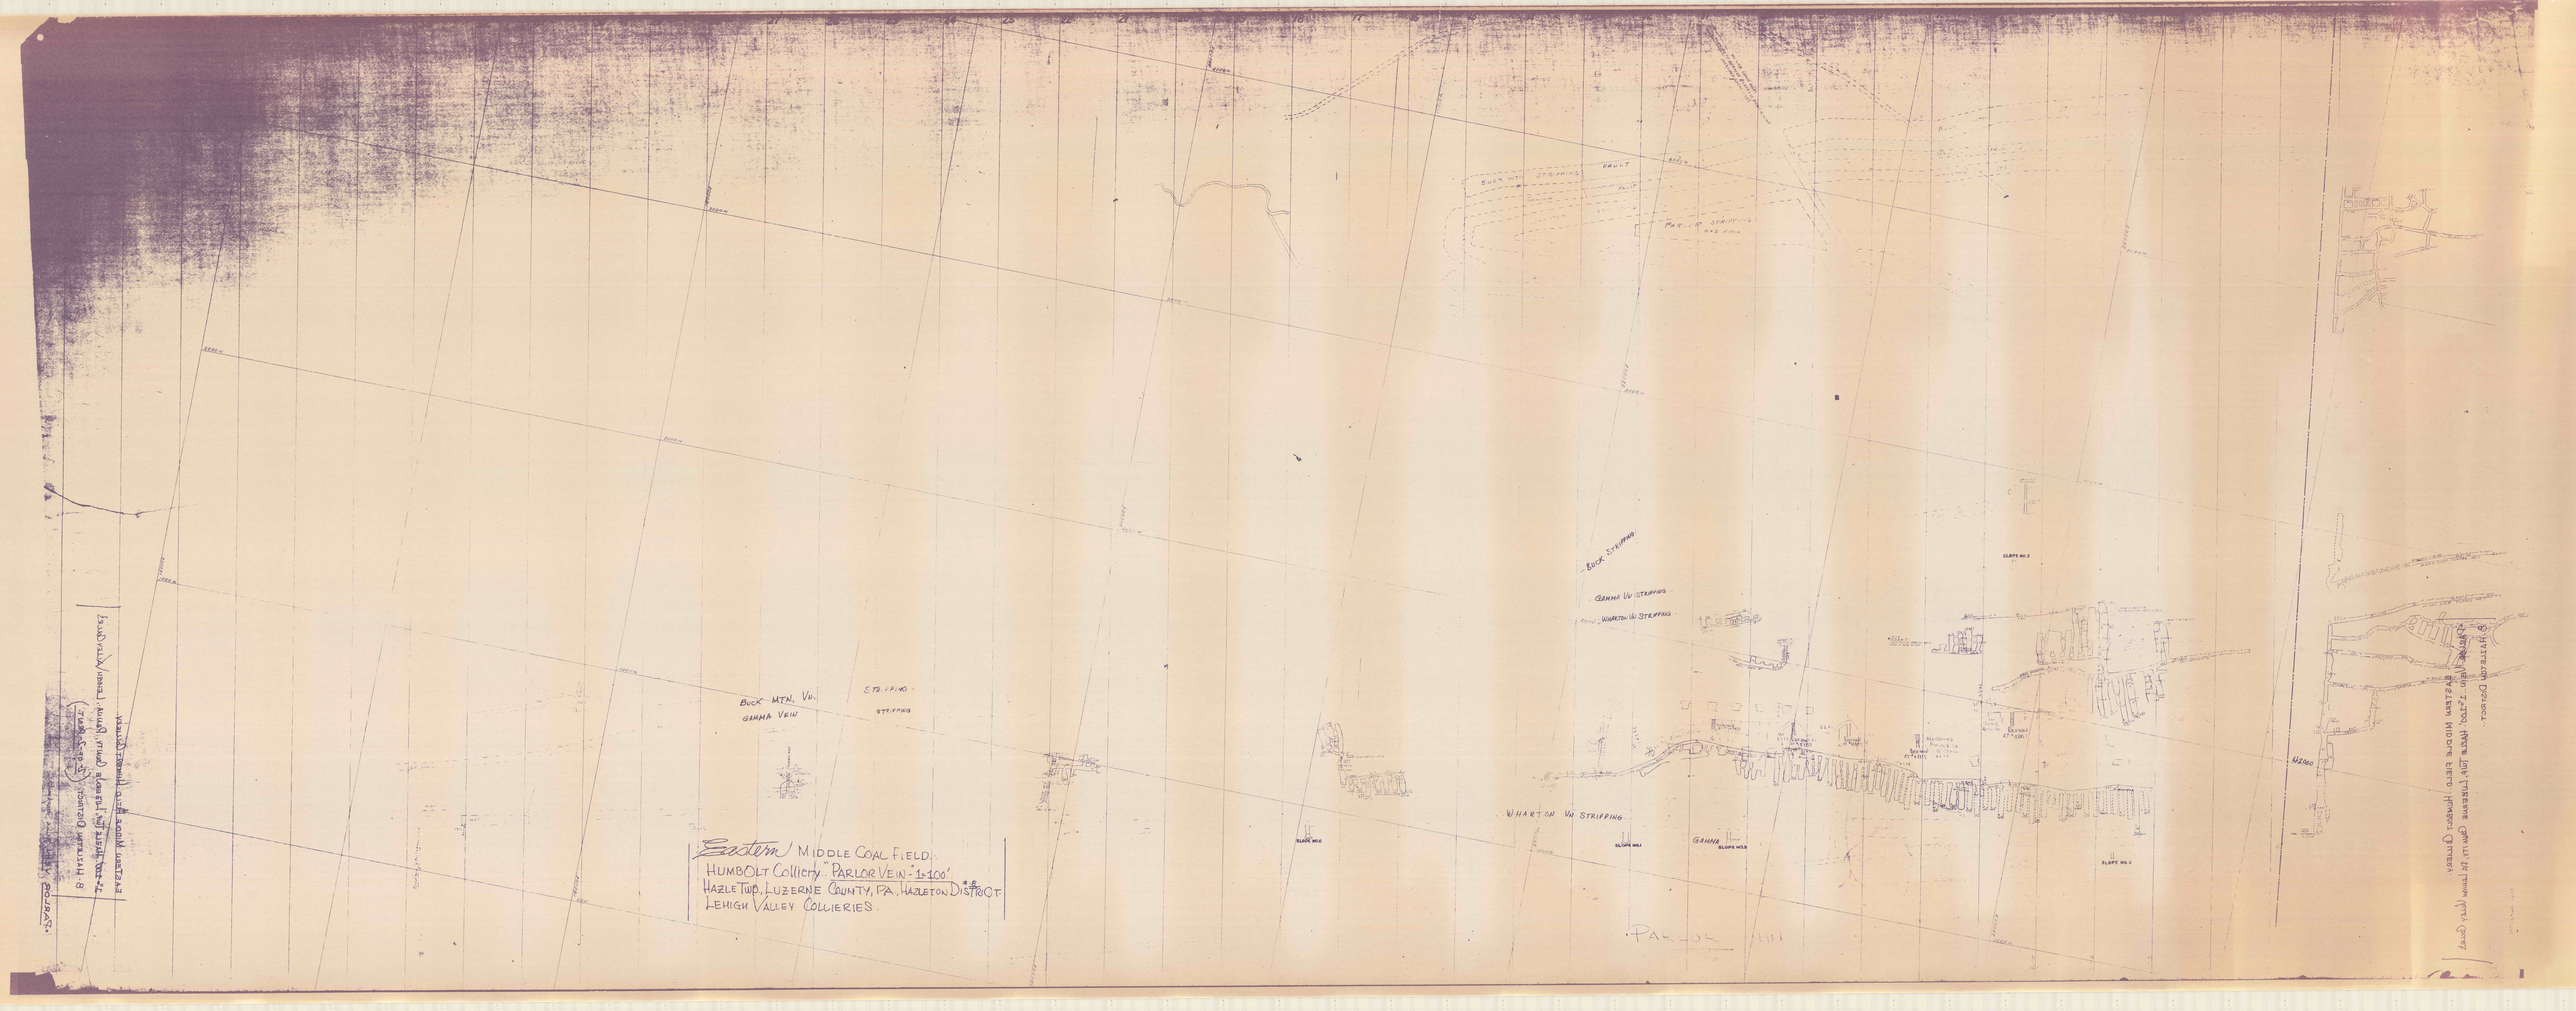
Eastern Middle Coal Field:
Humbolt Colliery. Parlor Vein - 1=100'
Hazle Twp., Luzerne County, Pa., Hazleton District
Lehigh Valley Collieries
Buck Mtn. Vn.
Gamma Vein
Stripping
Stripping
Buck Mtn. Stripping
Gamma Vn. Stripping
Wharton Vn. Stripping
Wharton Vn. Stripping
Gamma
Slope No. 1
Slope No. 2
Slope No. 3
Fault
Fault
Buck Mtn. Stripping
Parlor Stripping
Parlor
Eastern Middle Field (Main Basin)
Hazleton District
Luzerne County, Pa.