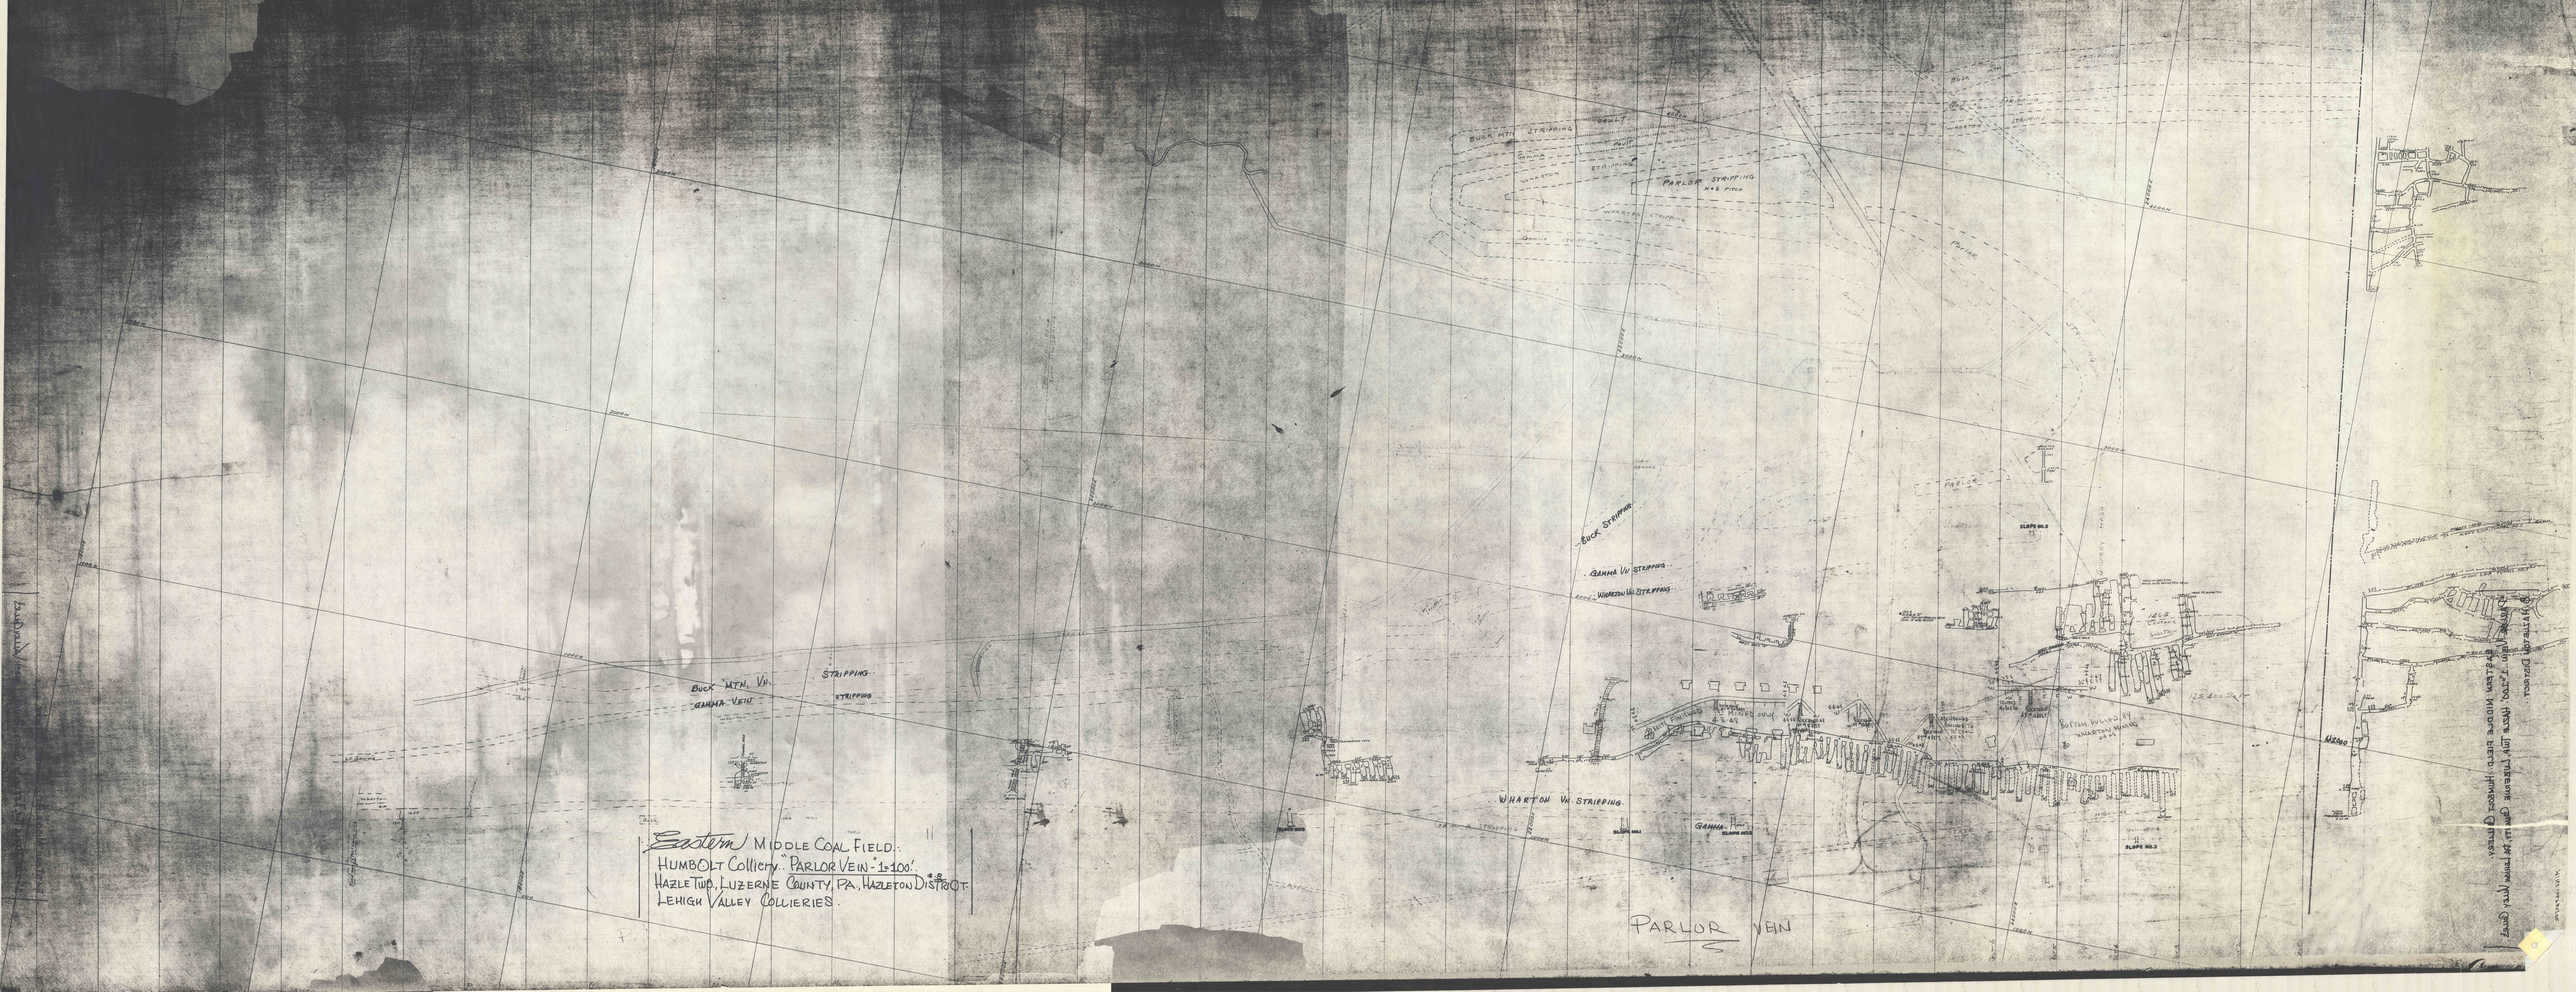
BUCK MTN. VN.
GAMMA VEIN
STRIPPING
STRIPPING
Eastern MIDDLE COAL FIELD.
HUMBOLT Colliery. "PARLOR VEIN" 1=100'
HAZLE TWP., LUZERNE COUNTY, PA., HAZLETON DISTRICT.
LEHIGH VALLEY COLLIERIES.
PARLOR STRIPPING
N & S PITCH
BUCK STRIPPING
GAMMA VN STRIPPING
WHARTON VN STRIPPING
WHARTON VN. STRIPPING.
PARLOR VEIN
SLOPE NO. 3
SLOPE NO. 1
SLOPE NO. 2
GAMMA
BOTTOM WORKS OF WHARTON MINE
PLANE OF PARLOR VEIN
PLANE OF GAMMA VEIN
PLANE OF BUCK MTN. VEIN
PLANE OF MIDDLE BED
PLANE OF WHARTON VEIN