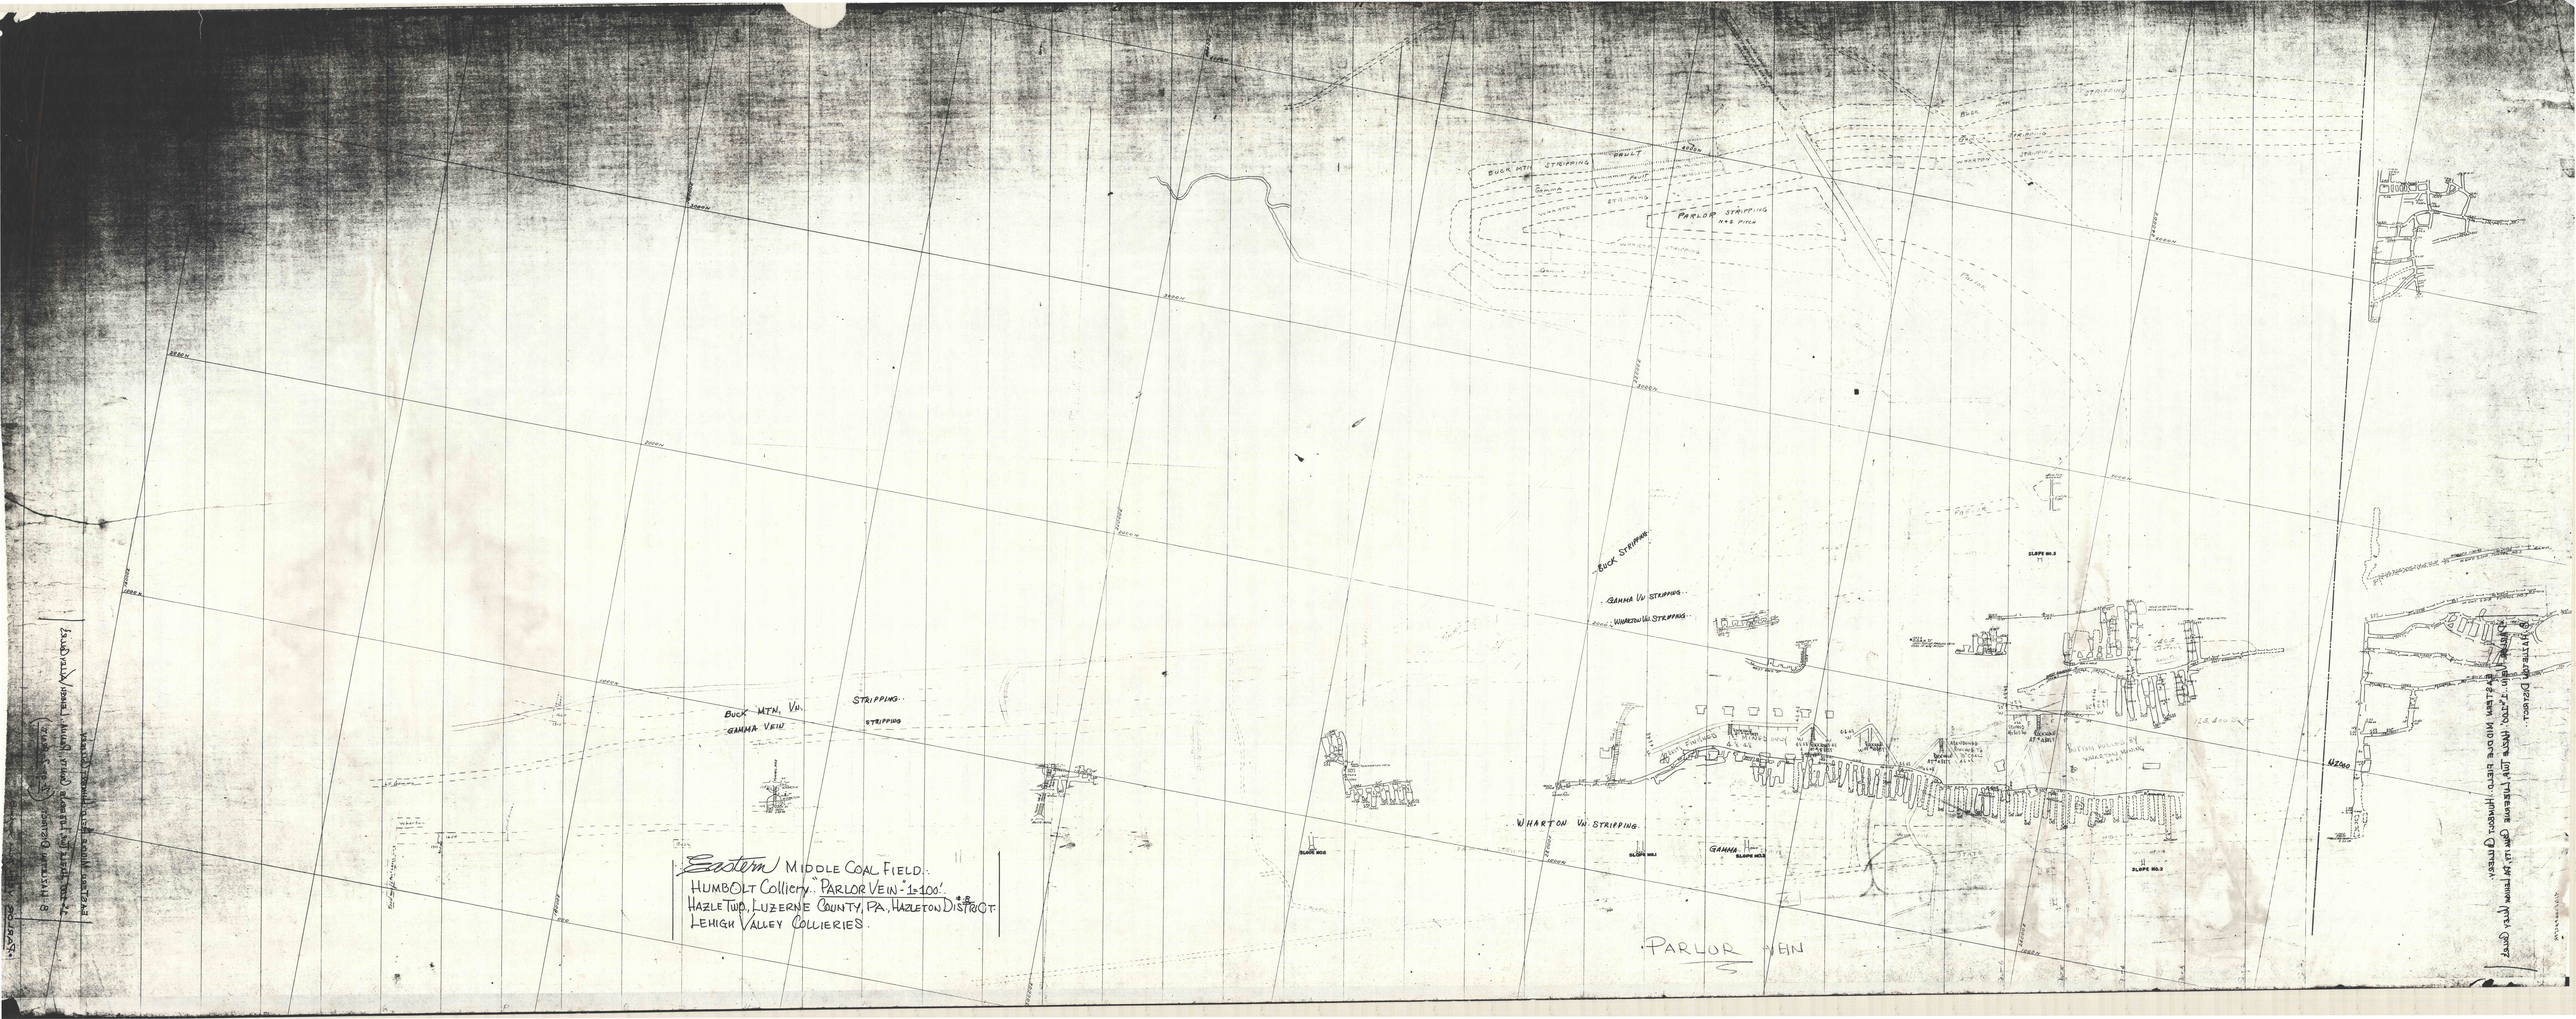

BUCK MTN. VN.
GAMMA VEIN
STRIPPING
STRIPPING
BUCK STRIPPING
GAMMA VN STRIPPING
WHARTON VN STRIPPING
PARLOR STRIPPING
WHARTON VN. STRIPPING
GAMMA
PARLOR VEIN
SLOPE NO.3
SLOPE NO.2
SLOPE NO.1
SLOPE NO.3
Eastern MIDDLE COAL FIELD.
HUMBOLT Colliery. PARLOR VEIN - 1=100'.
HAZLE TWP, LUZERNE COUNTY, PA., HAZLETON DISTRICT.
LEHIGH VALLEY COLLIERIES.