




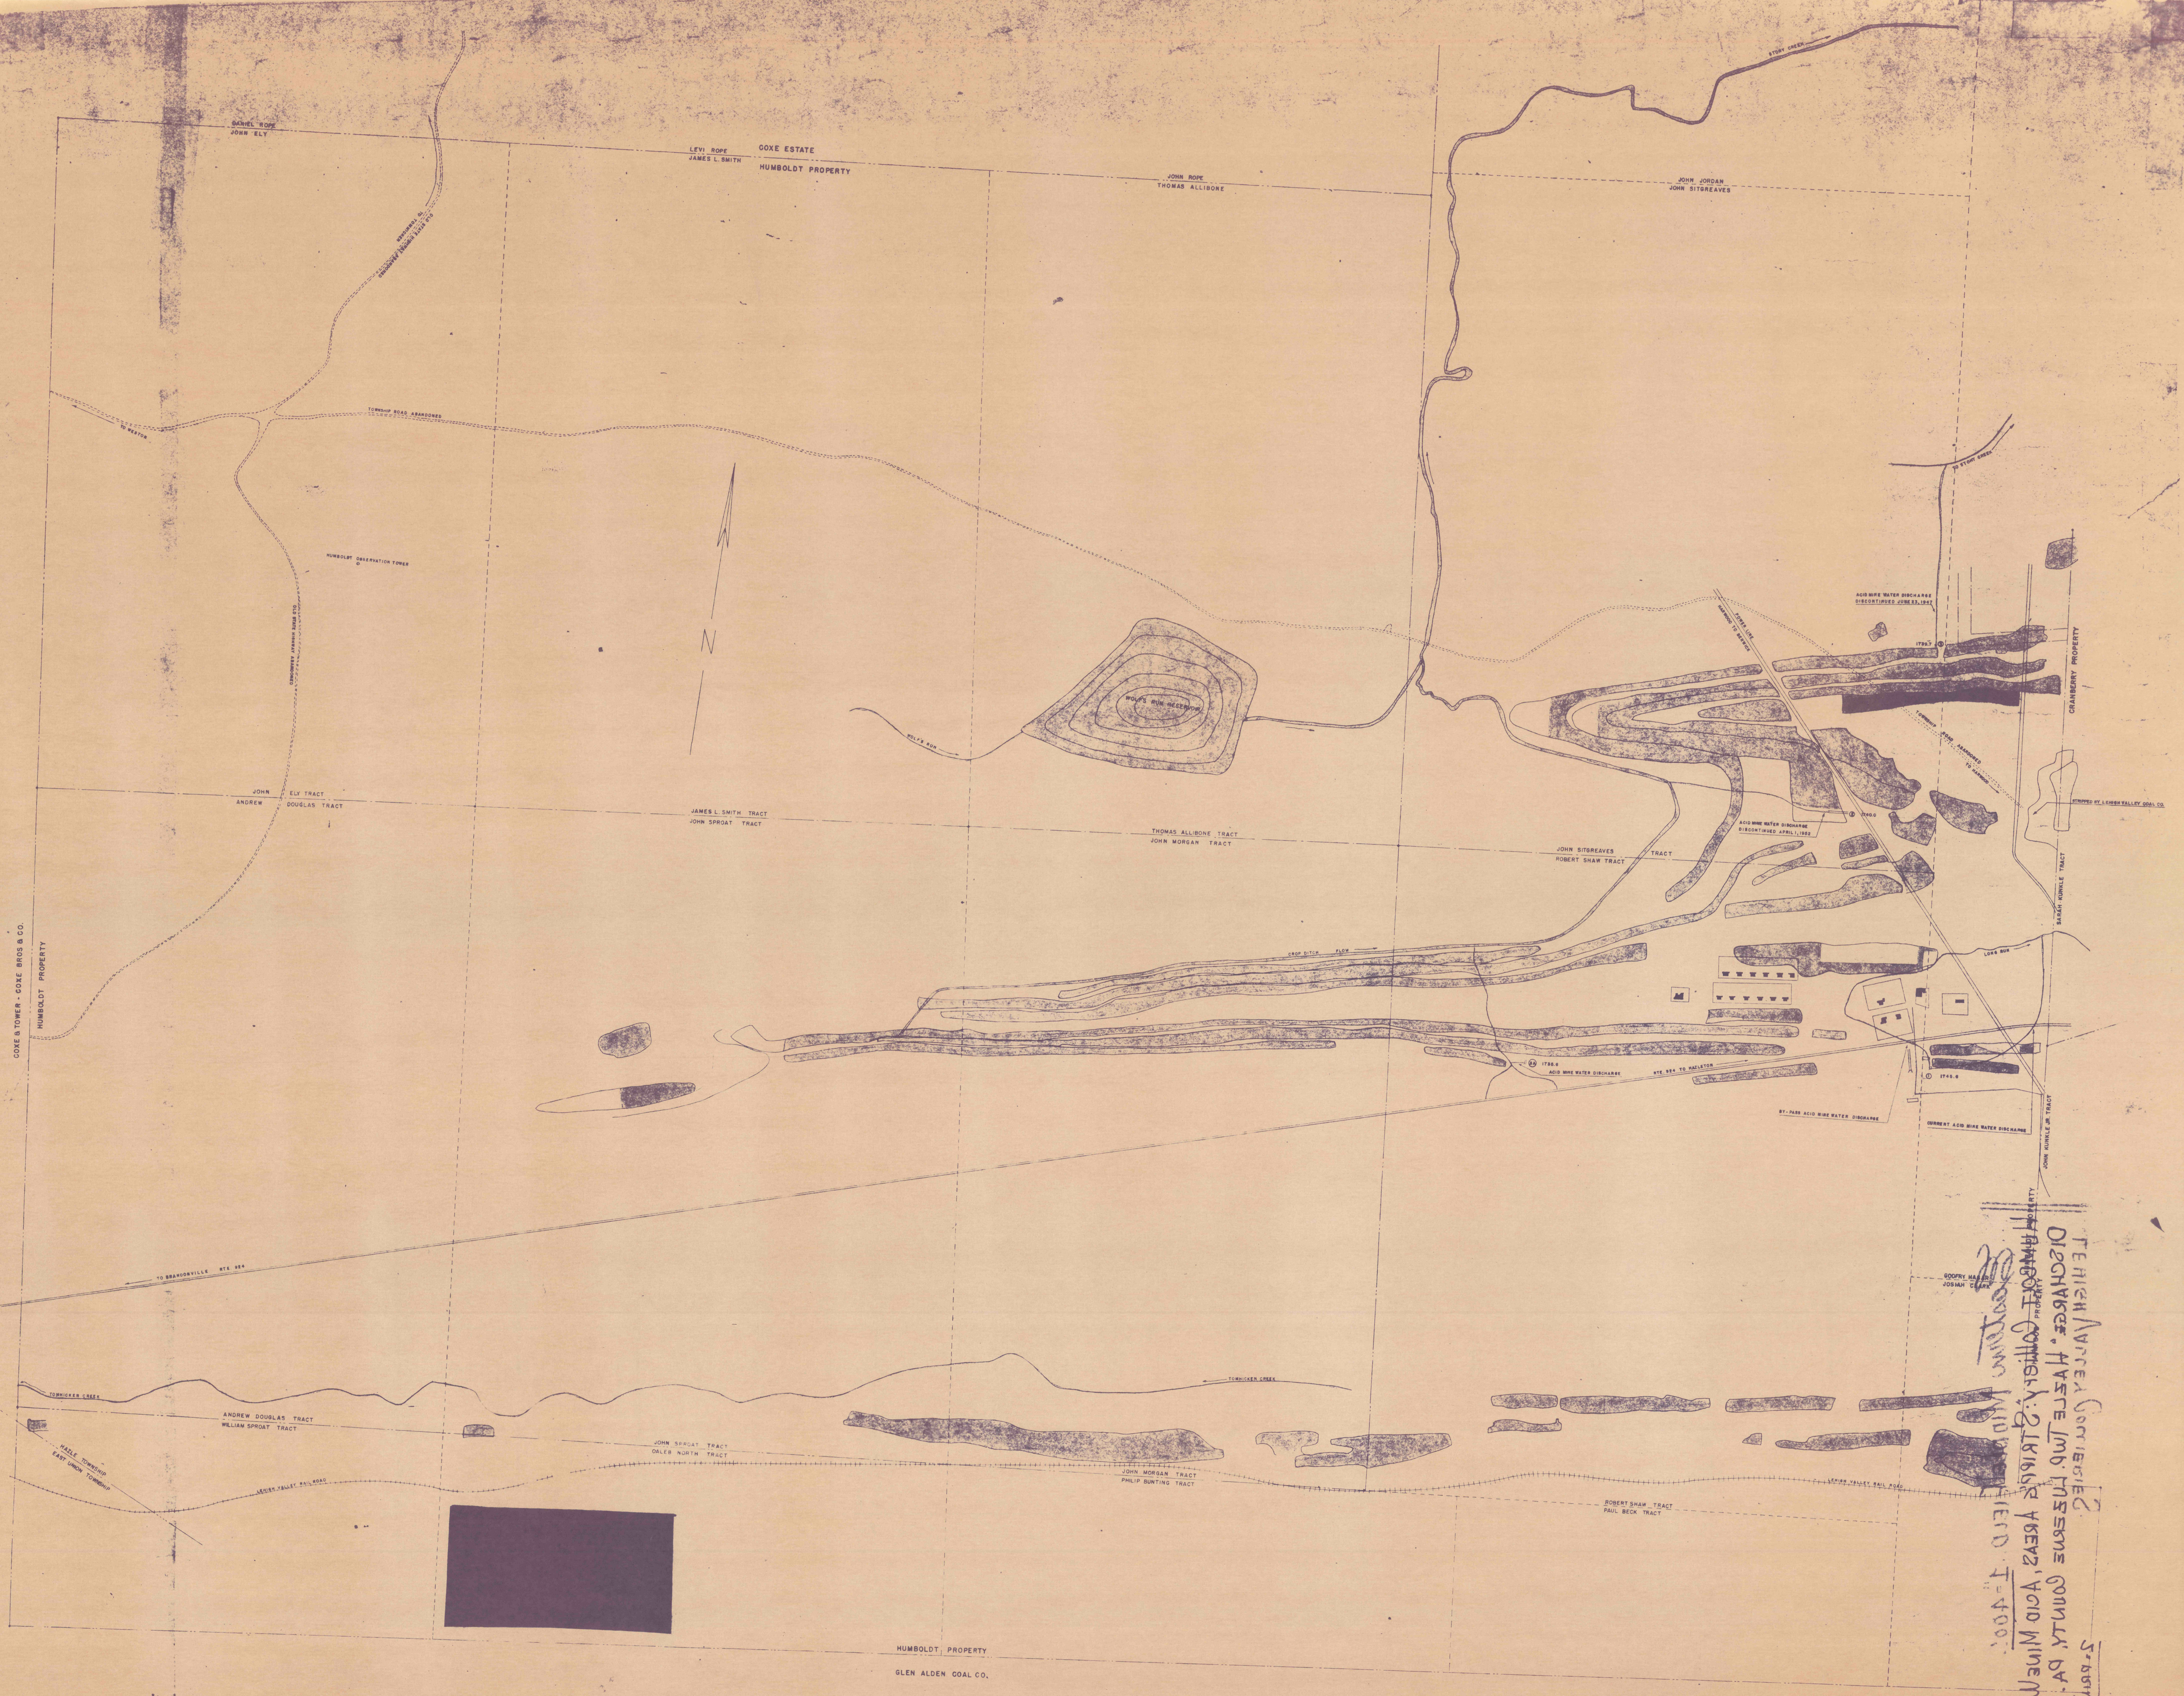



LEGEND

- AREAS STRIPPED PRIOR TO JUNE 21, 1947.
- AREAS STRIPPED TO OCT. 18, 1932.
- AREAS TO BE STRIPPED TO OCT. 18, 1932.
- AREAS BACK FILLED TO OCT. 18, 1932.