


D.2.1

LOST CREEK DRAINAGE DITCHES

D.2.1

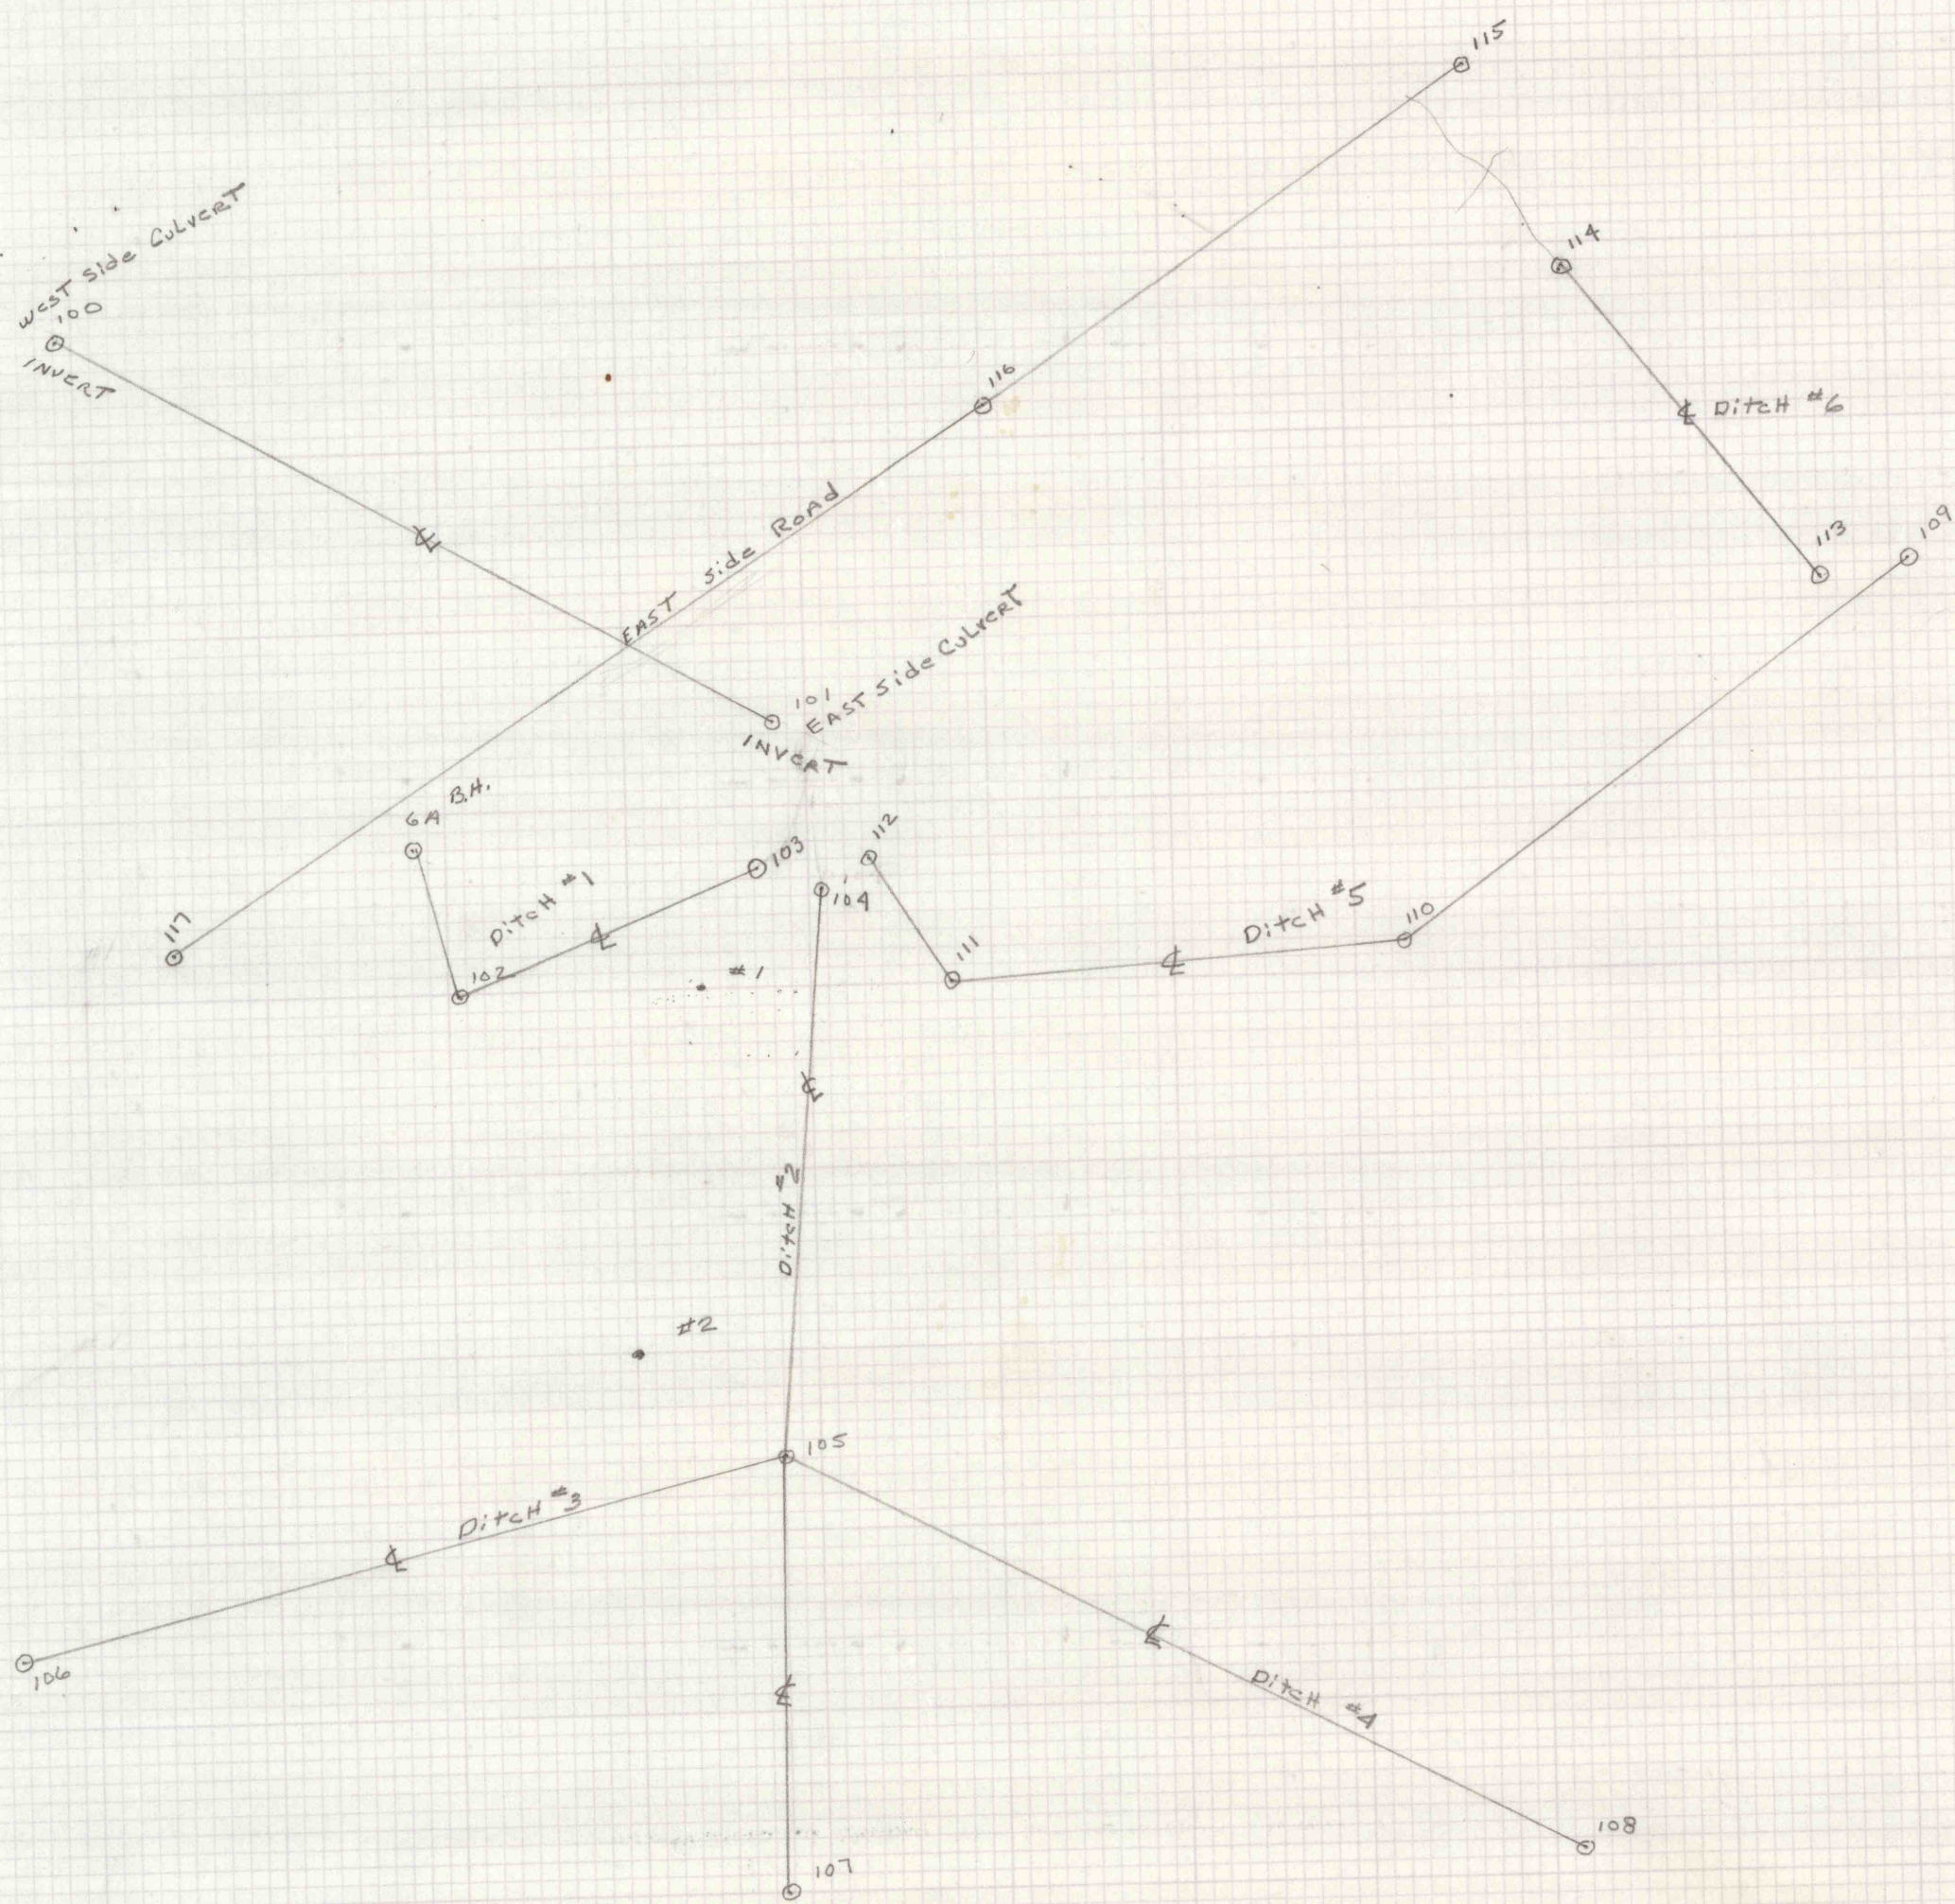

LOST CREEK WEST N MIDDLE FIELD  
 BLEEDER DITCHES  
 SCALE 1" = 20'  
 MAHANOT TWP. - SCHUYLKILL COUNTY

D.2.1

LOST CREEK DRAINAGE DITCHES

D.2.1