


D.S.S


D.S.S

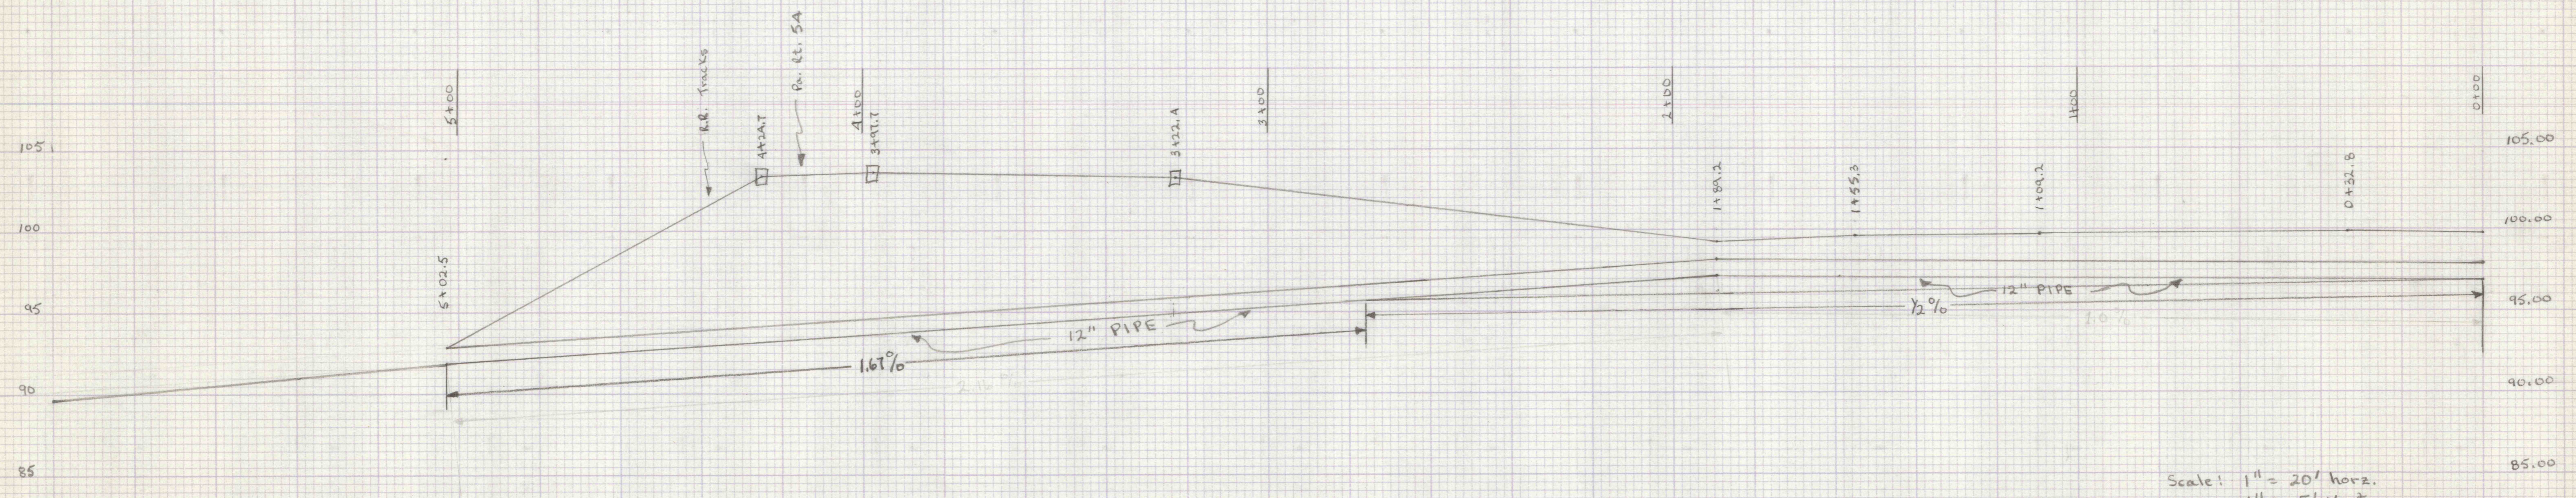

Scale: 1" = 20' horz.
 1" = 5' vert.
 Drawn - K. Laslow
 Survey - S. Boyer

LOST CREEK PIPELINE 0'2" GRADE

LOST CREEK PIPELINE 0'2" GRADE

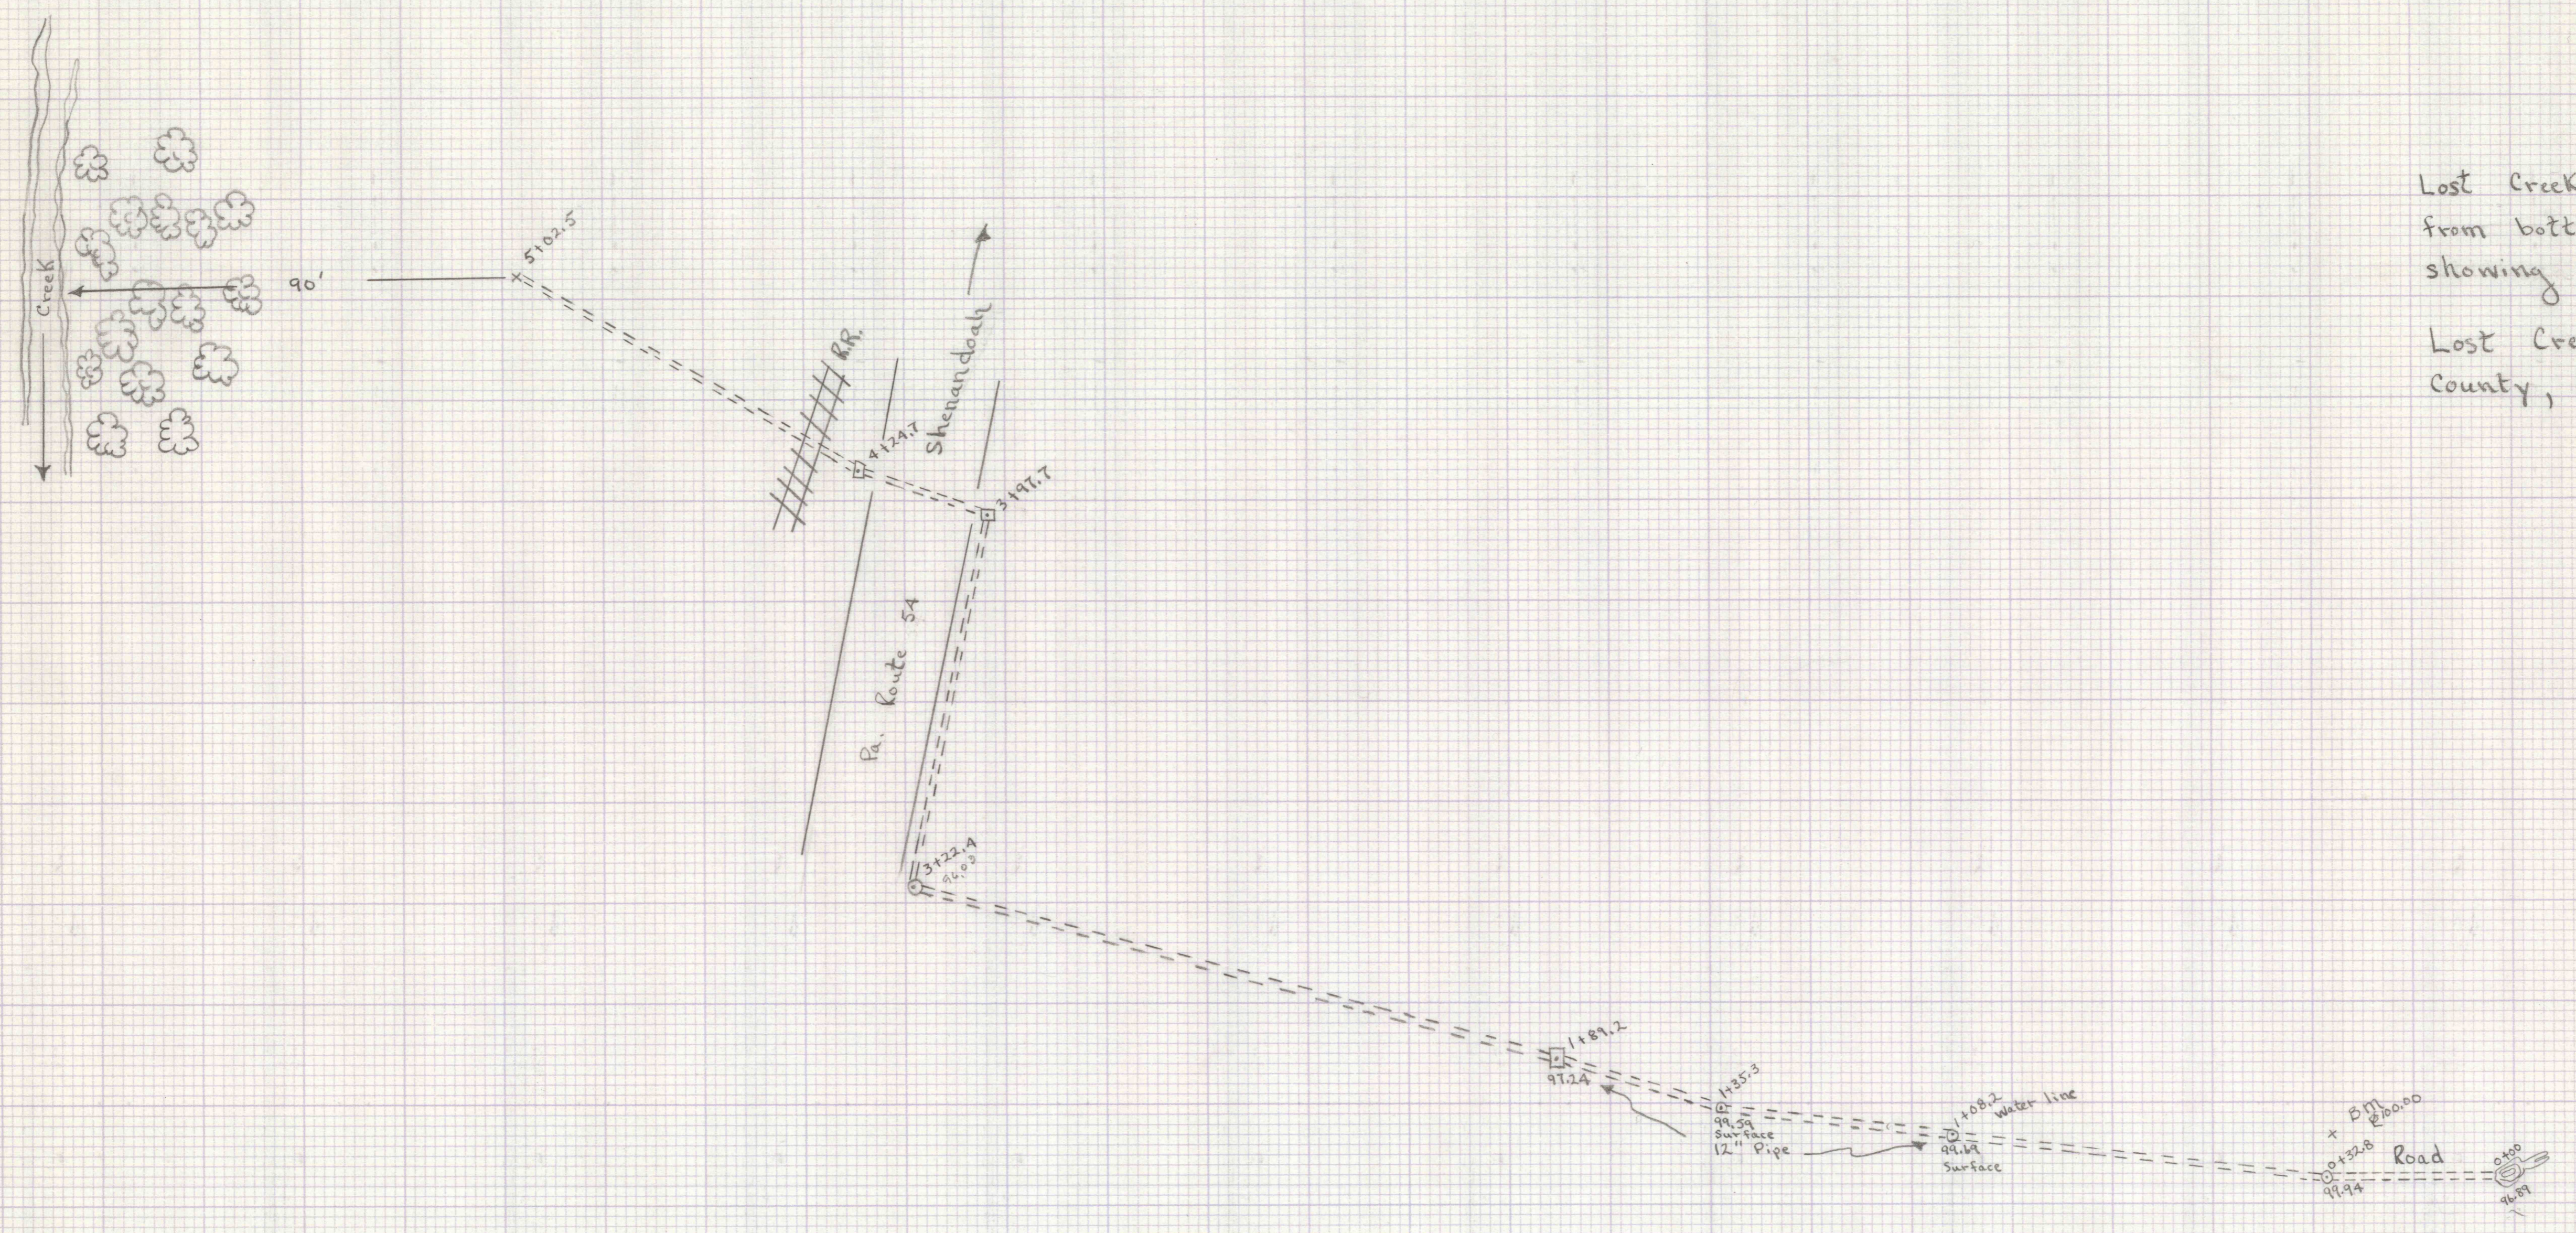

Lost Creek Pipe Line
 from bottom of mountain
 showing settlement
 Lost Creek, Schuylkill
 County, Pennsylvania

Scale 1" = 20'
 Survey - S. Boyer
 Drawn - K. Laslow

D.S.S

D.S.S