


NORTH BOUNDARY LINE GILBERTON BOROUGH

MAHANoy PLANE

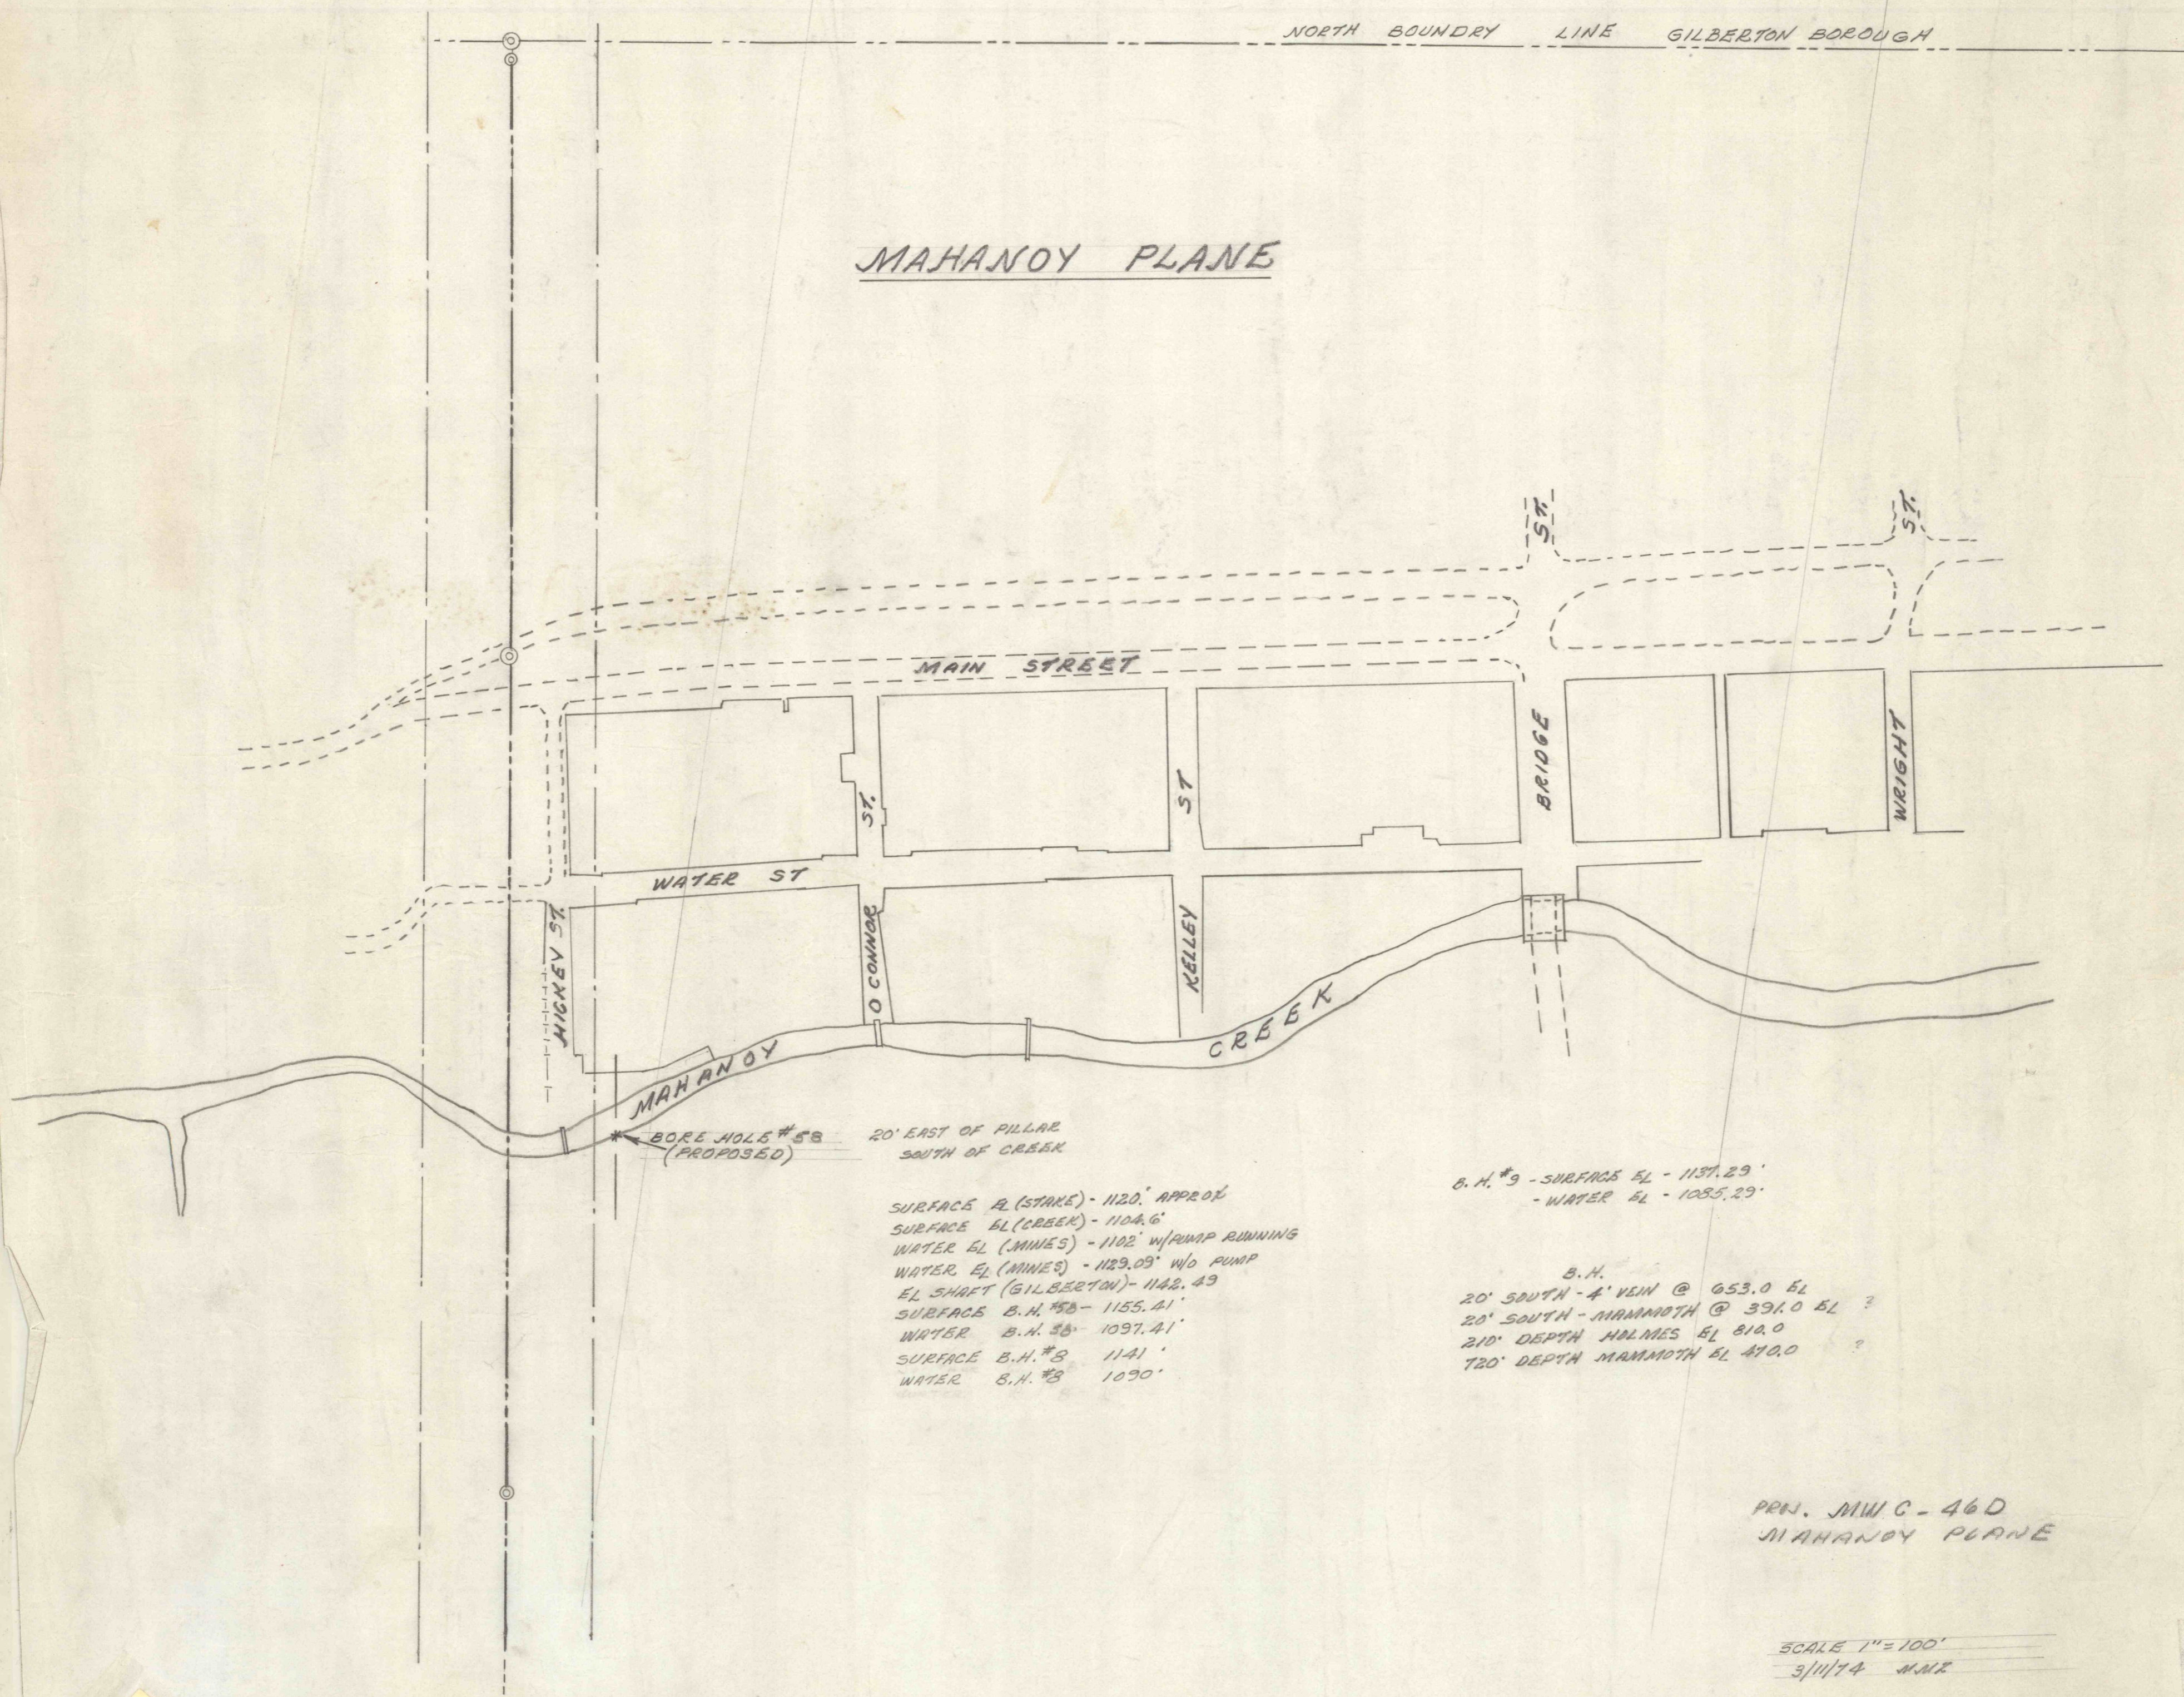

* BORE HOLE #58 (PROPOSED) 20' EAST OF PILLAR SOUTH OF CREEK

SURFACE A (STAKE) - 1120' APPROX
 SURFACE EL (CREEK) - 1104.6'
 WATER EL (MINES) - 1102' W/PUMP RUNNING
 WATER EL (MINES) - 1129.09' W/O PUMP
 EL SHAFT (GILBERTON) - 1142.43
 SURFACE B.H. #58 - 1155.41'
 WATER B.H. #58 - 1097.41'
 SURFACE B.H. #8 - 1141'
 WATER B.H. #8 - 1090'

B.H. #9 - SURFACE EL - 1137.29'
 - WATER EL - 1085.29'

B.H.
 20' SOUTH - A' VEIN @ 653.0 EL
 20' SOUTH - MAMMOTH @ 391.0 EL ?
 210' DEPTH HOLMES EL 810.0
 720' DEPTH MAMMOTH EL 410.0 ?

PROJ. M.W.C. - 46D
 MAHANoy PLANE

SCALE 1" = 100'
 3/11/14 AMZ

E-5.