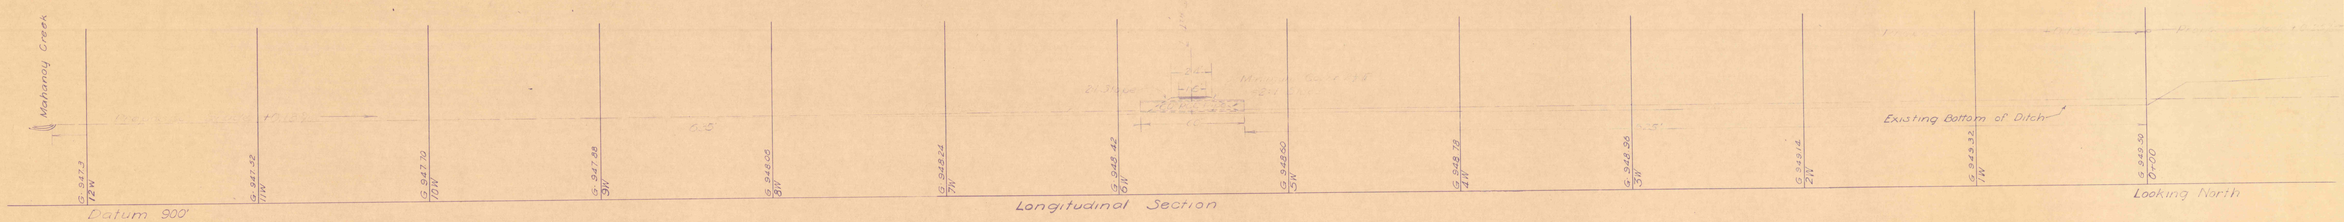
Mahanoy Creek
Existing Bottom of Ditch
Datum 900'
Longitudinal Section
Looking North

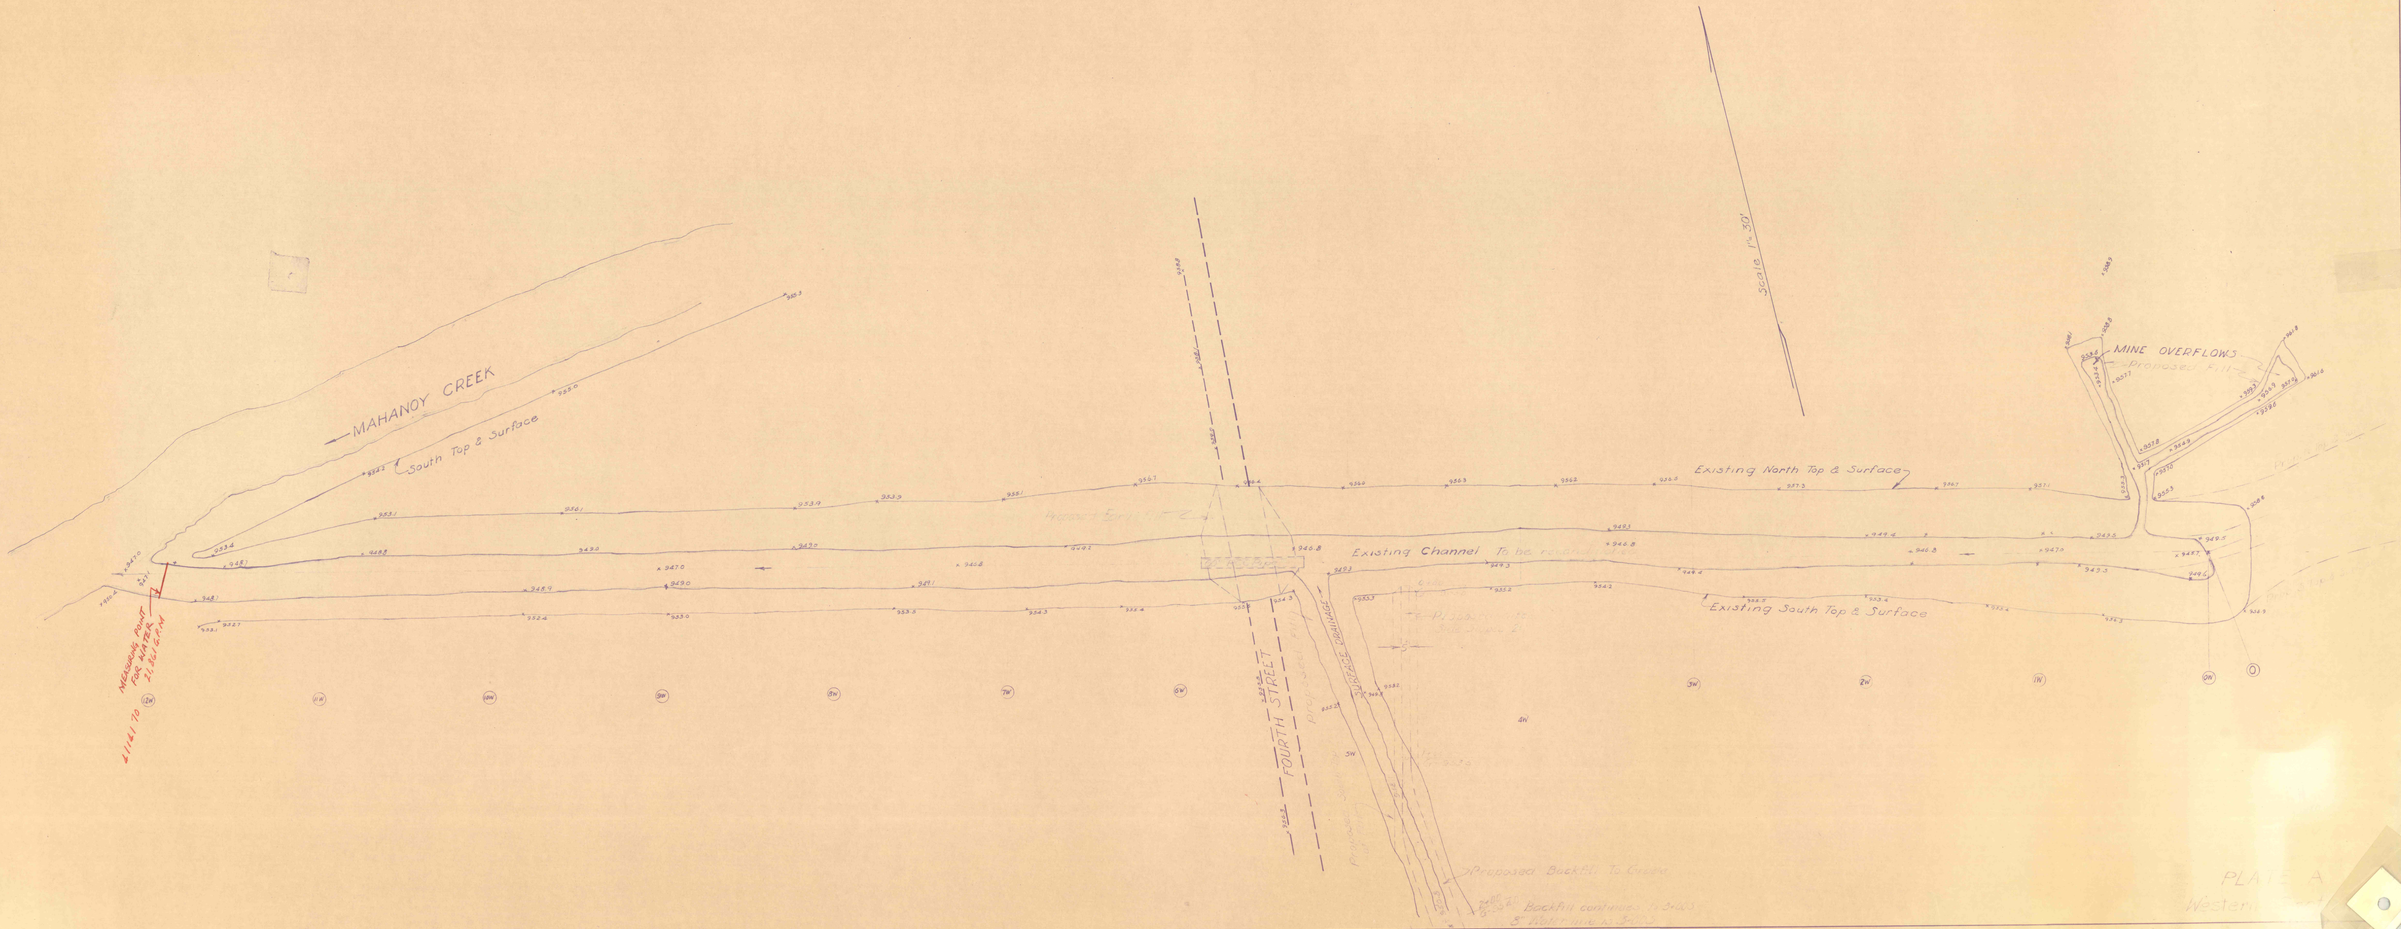
MAHANOY CREEK
South Top & Surface
Existing North Top & Surface
Existing Channel To be
Existing South Top & Surface
MINE OVERFLOWS
Proposed Pipe
FOURTH STREET
Proposed Backfill To Grade
Scale 1"= 50'