


Elmwood Colliery

Tunnel Ridge Colliery

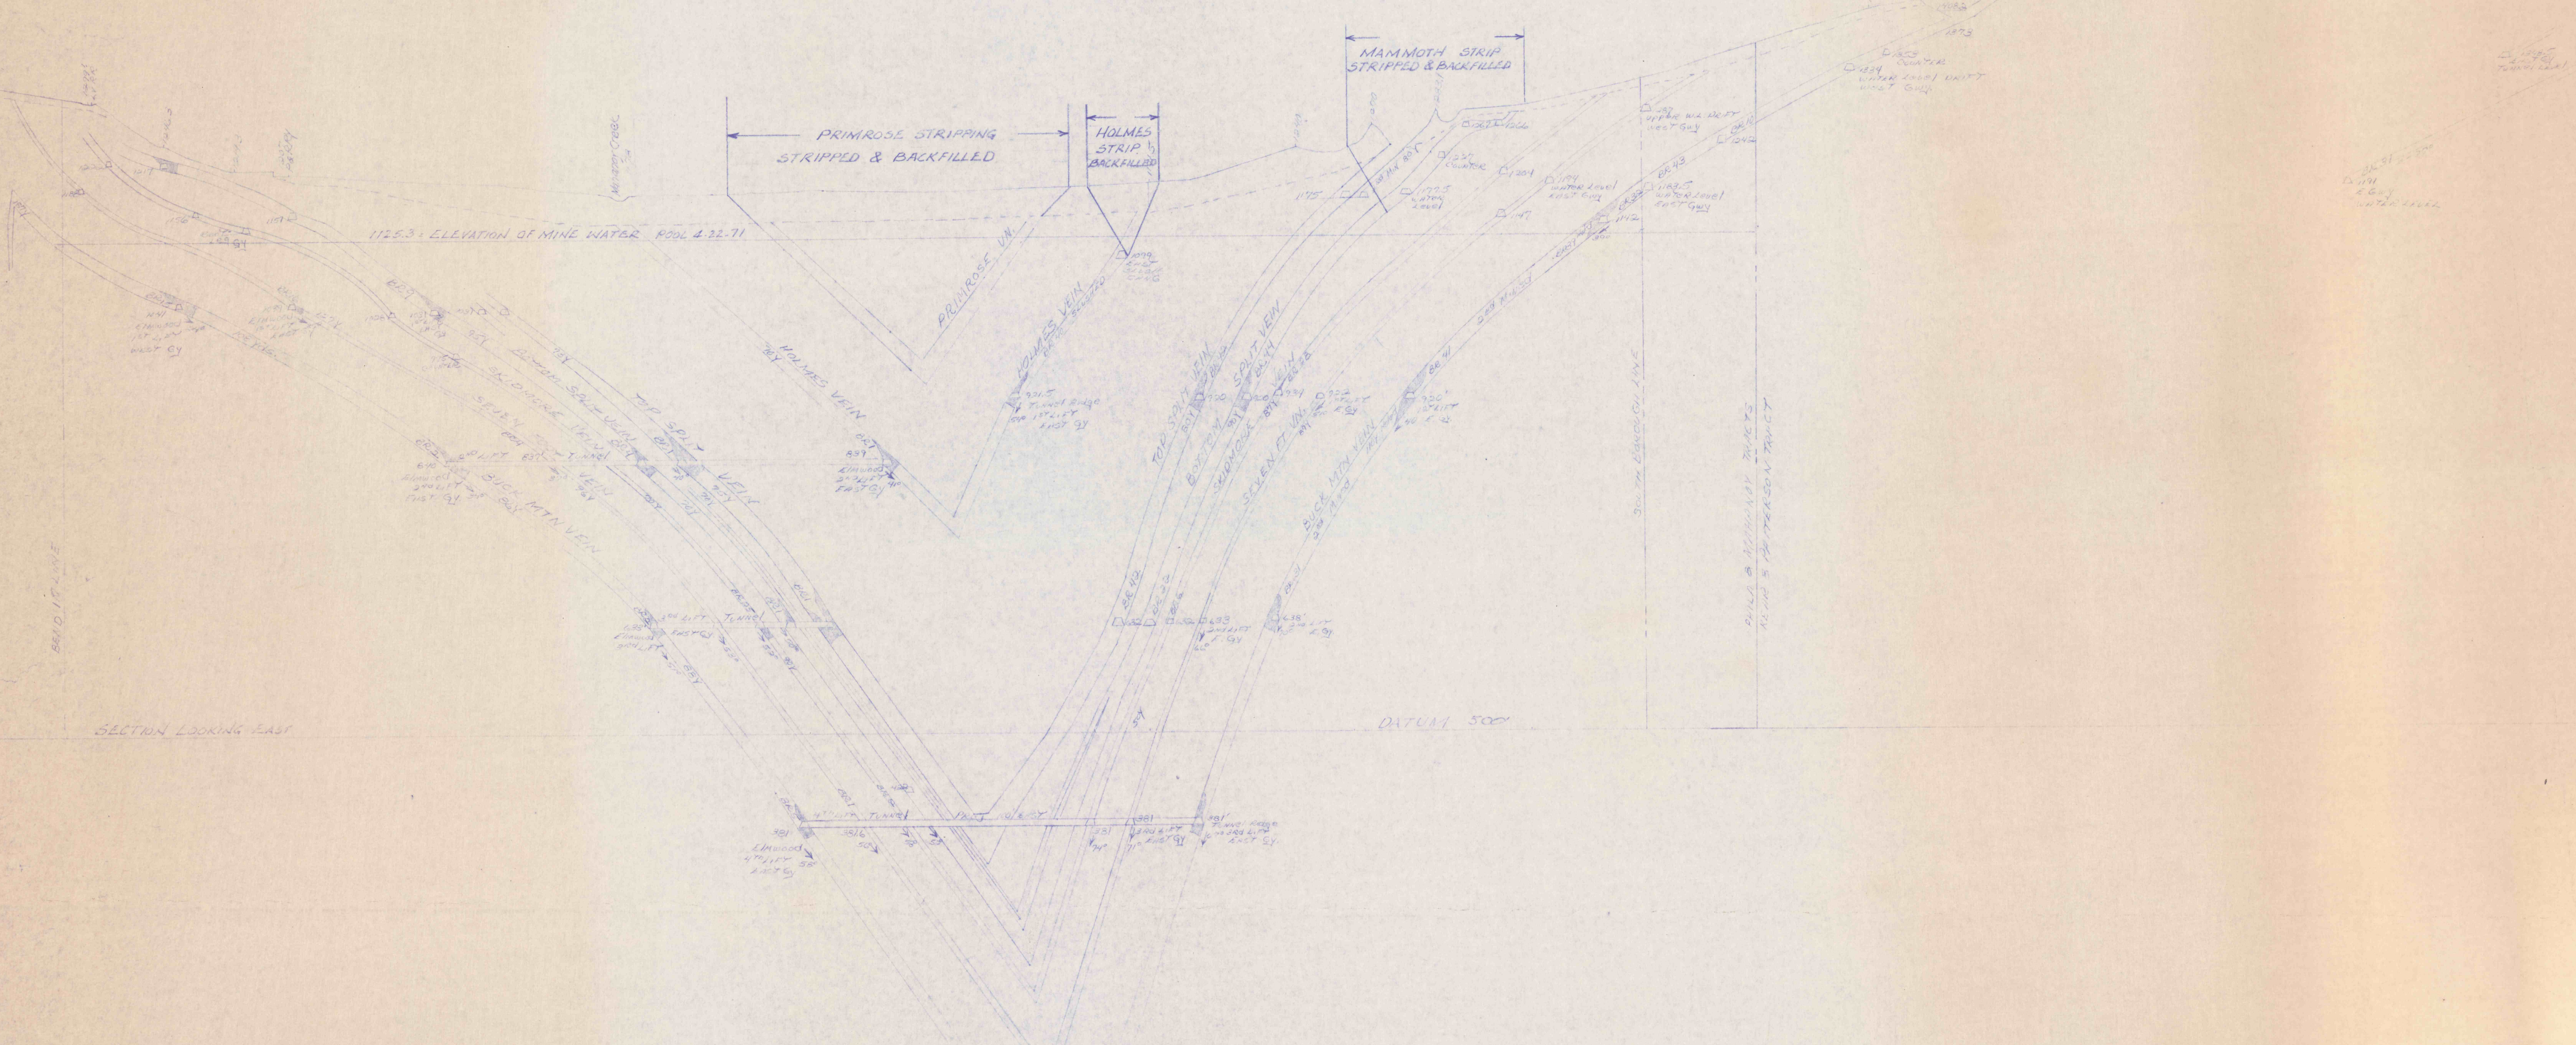

CROSS SECTION 1116

3200' East of Knickerbocker No. 4 Main Hoisting Slope
 2200' West of Mahanoy City Main Hoisting Slope
 Mahanoy City - November 1911
 On Line of Schoykill No. 3 Buck Mtn Slope
 400' East of Elmwood Tenner Slope
 T. Bryan Buren, Division Engineer

Scale 1"=100'

11/16