


22-1

22-3

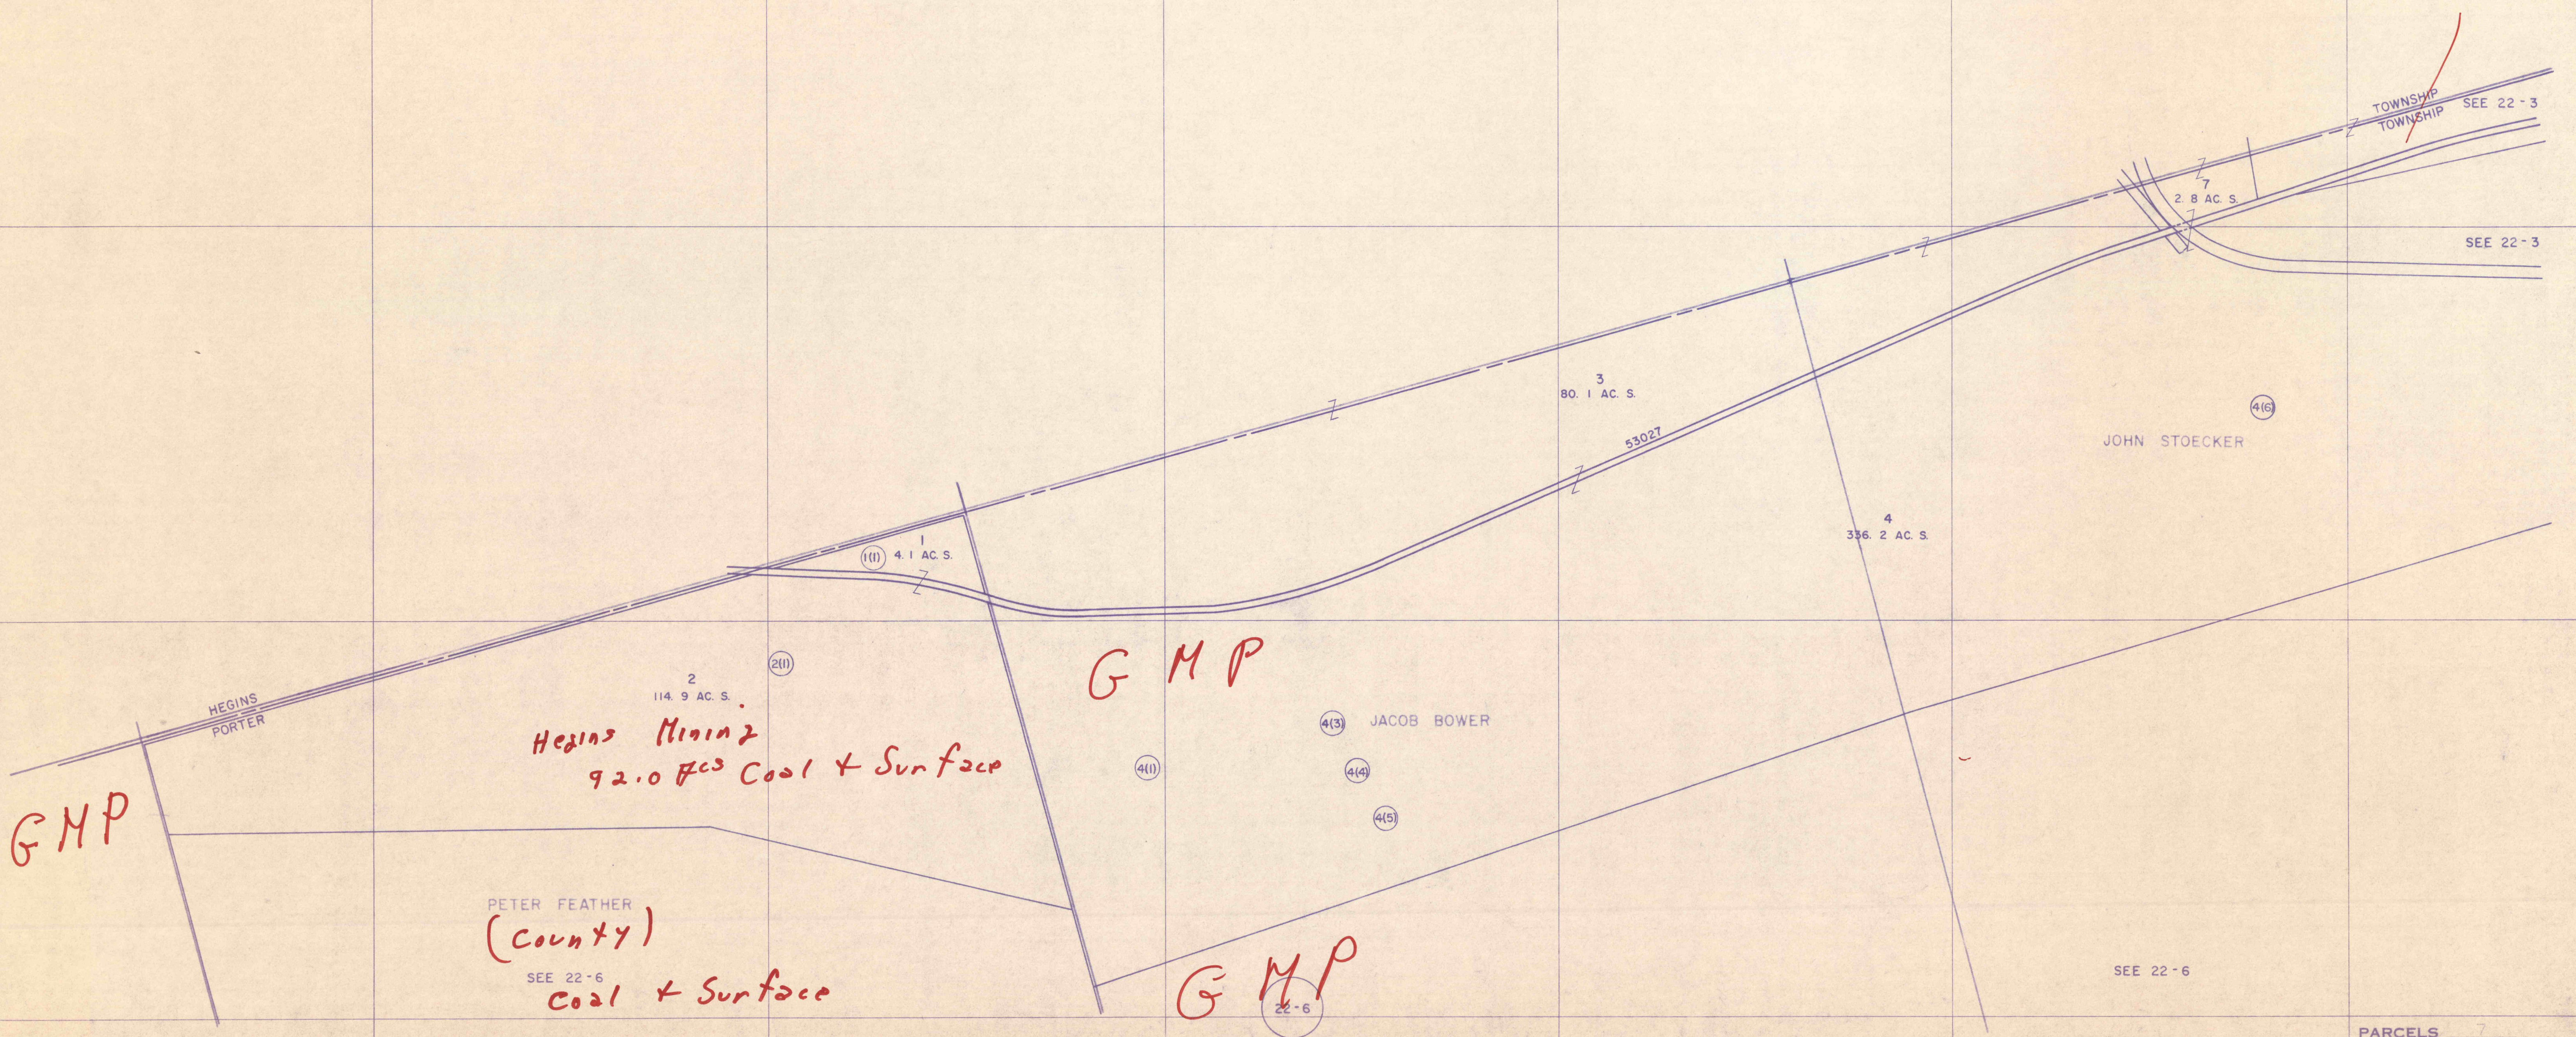

GMP

Hegins Mine
92.0 AC. Coal + Surface

PETER FEATHER
(COUNTY)
SEE 22-6
Coal + Surface

GMP

GMP
22-6

JACOB BOWER

JOHN STOECKER

TOWNSHIP
TOWNSHIP

SEE 22-3

SEE 22-3

SEE 22-6