



SECTION 19 - LOOKING WEST - SCALE 1" = 50'

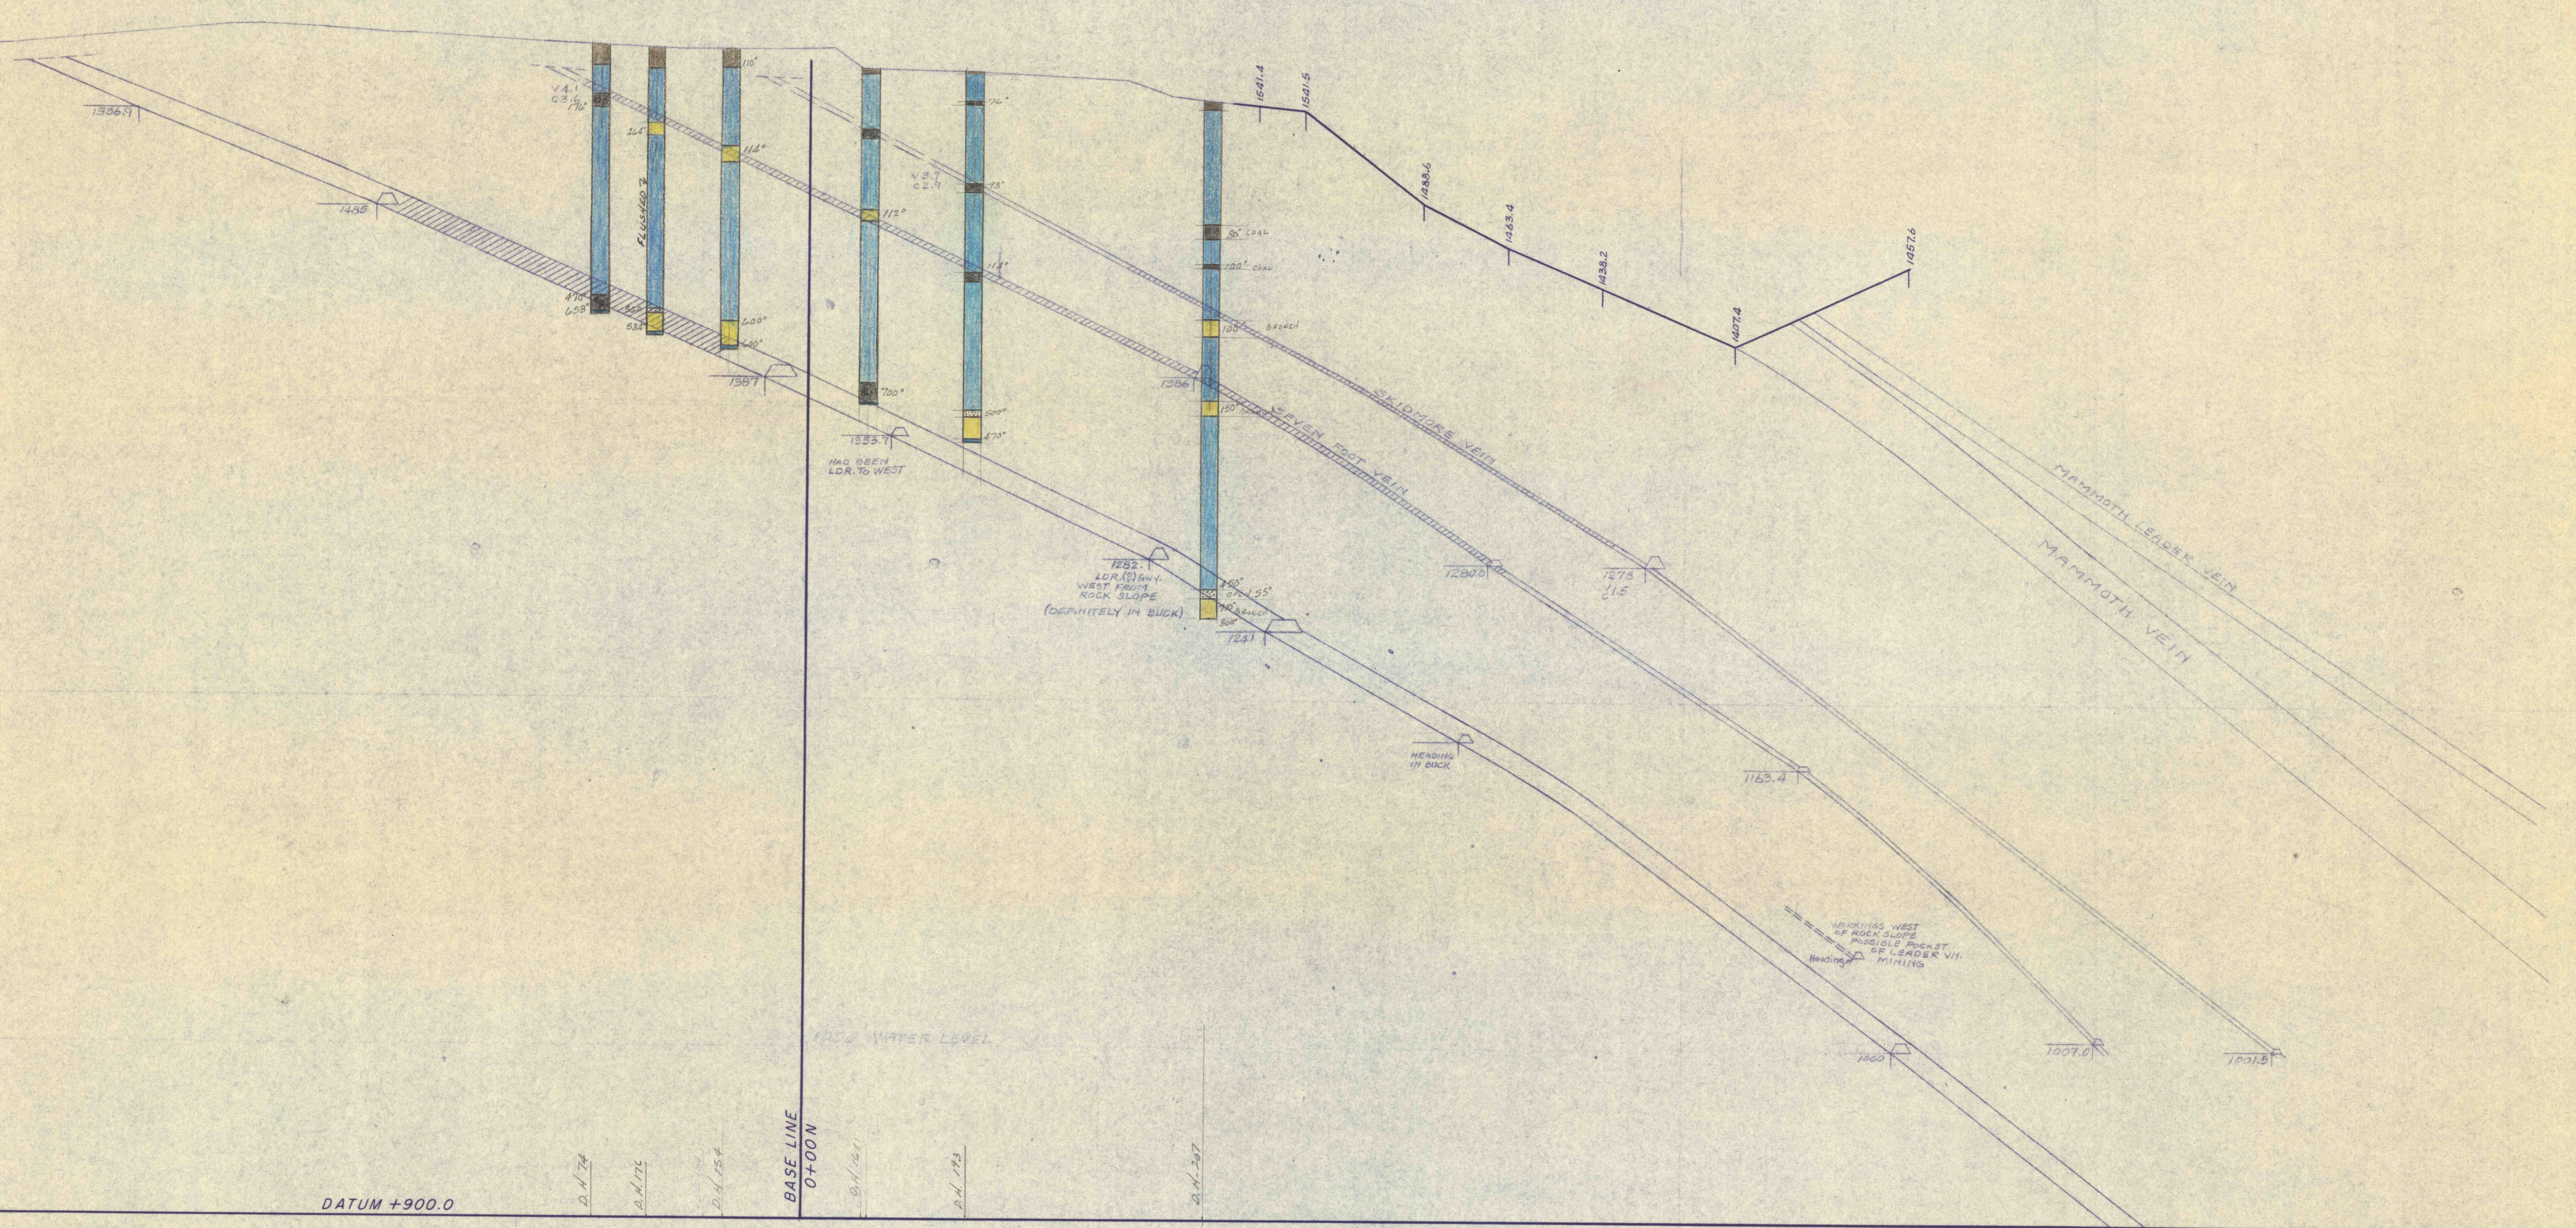

SECTION 17 - LOOKING WEST - SCALE 1" = 50'

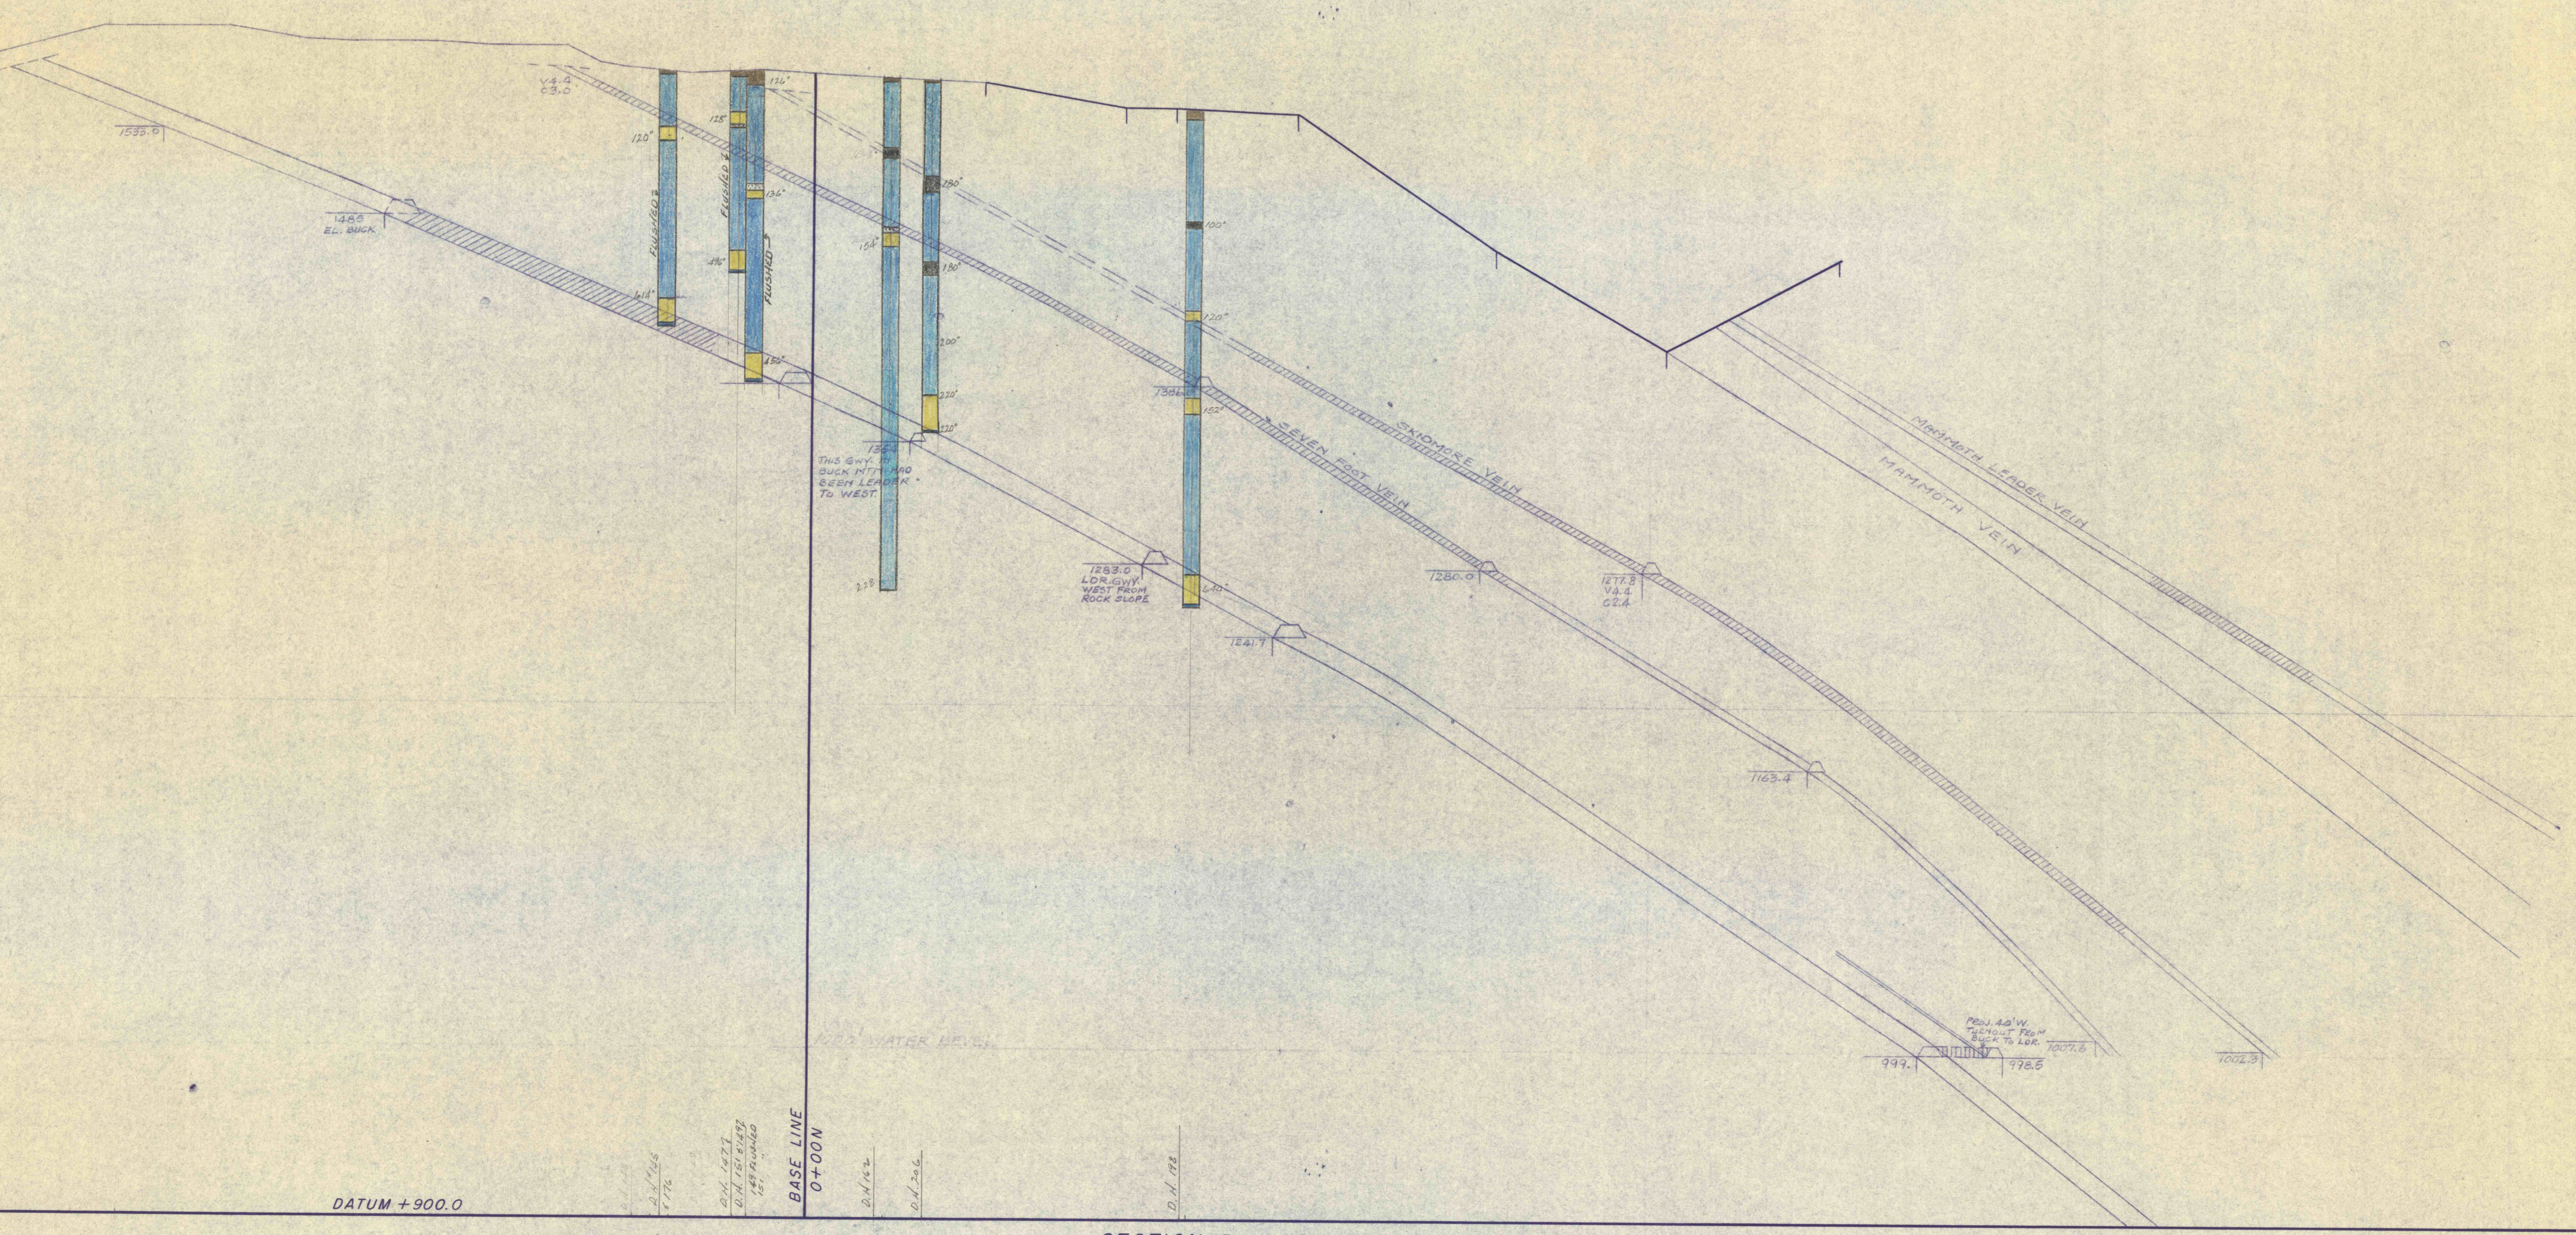

SECTION 15 - LOOKING WEST - SCALE 1" = 50'