


MAHANOY PLANE

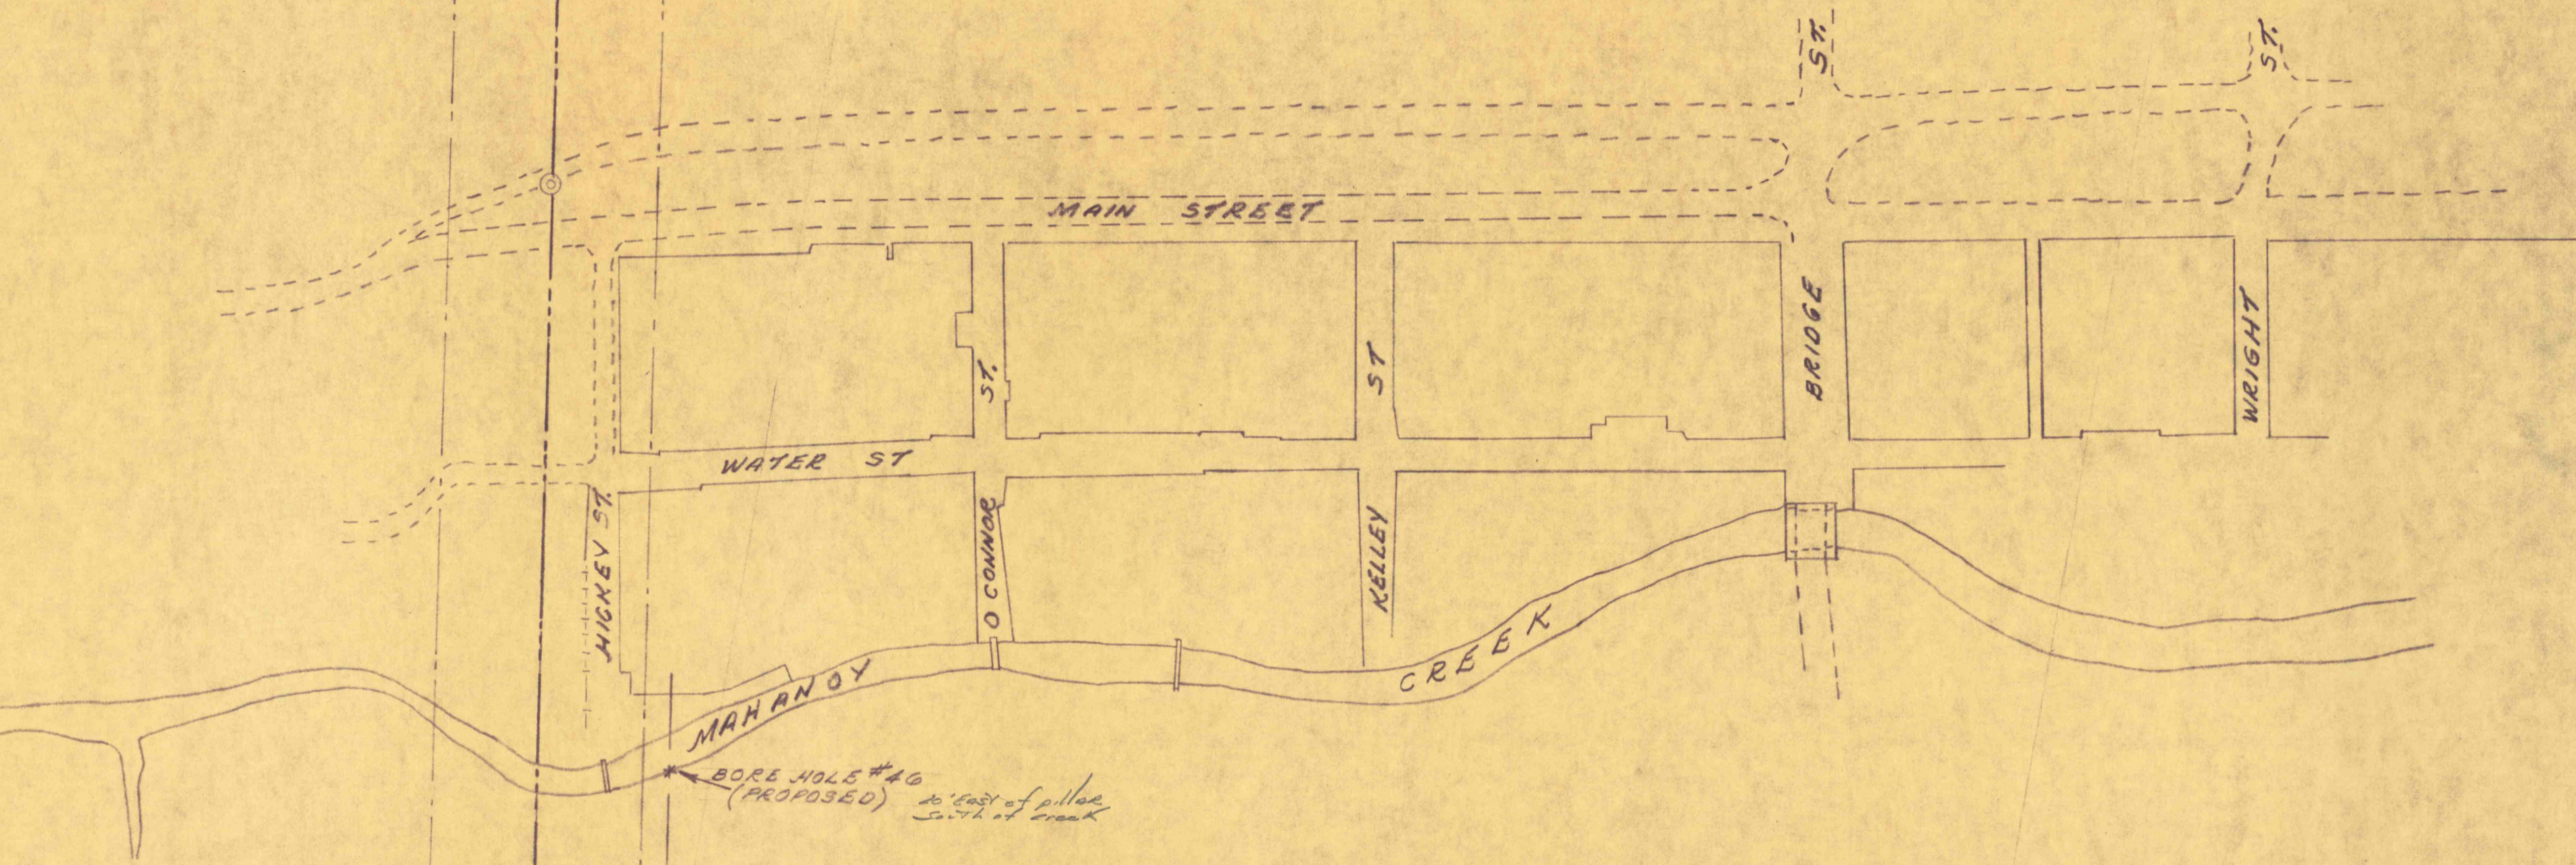

Surface  $\xi$  (stake) - 1120. approx  
 Surface  $\xi$  (Creek) - 1109.6'  
 Water  $\xi$  (Mines) - 1102' w/ pump running  
 Water  $\xi$  (Mines) - 1129.09 (with out pump)  
 $\xi$  Shaft (Gilberton) - 1142.49  
 Surface B.H. #6 -  
 Water B.H. #8 - 1102.5'

B.H. #9 - Surface  $\xi$  - 1137.29  
 - water  $\xi$  -

B.H. #46  
 20' south - given @ 653.0  $\xi$   
 20' south - mammoth @ 391.0  $\xi$  ?  
 210' depth Holmes  $\xi$  810.0  
 220' depth mammoth  $\xi$  470.0 ?