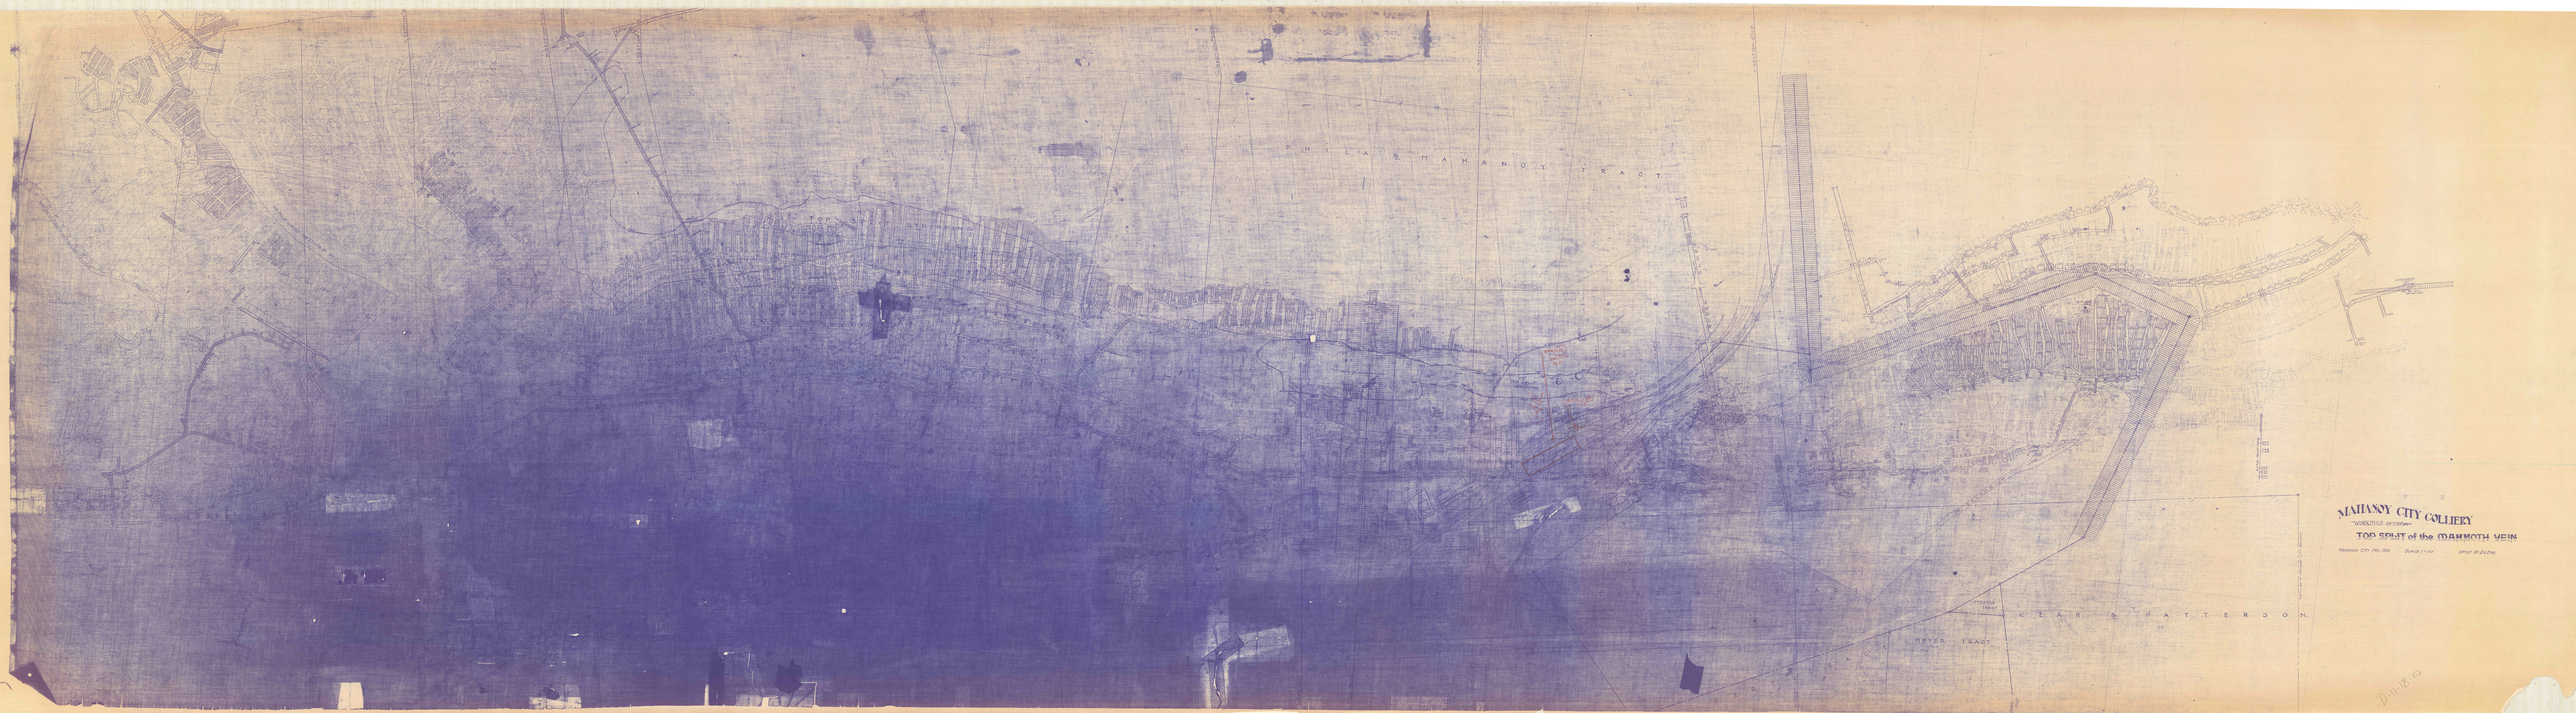

MAHANOY CITY COLLIERY
TOP SPLIT of the MAMMOTH VEIN
KEAR & PATTERSON.