


BORE HOLE NO.	SURFACE ELEVATION	BORE HOLE NO.	SURFACE ELEVATION
5-MF	1159.87	15-MF	1164.10
12-MF	1174.66	16-MF	1178.24
9-MF	1179.36	17-MF	1169.78
8-MF	1167.02		
10-MF	1181.00		
13-MF	1187.37		
11-MF	1162.07		
14-MF	1150.40		
2-BF	1183.67	11-BF	1164.92
6-BF	1176.70	12-BF	1167.71
3-BF	1186.42	13-BF	1168.52
1-BF	1176.35	14-BF	1172.59
4-BF	1163.77	15-BF	1179.86
8-BF	1170.92		
9-BF	1147.62		
10-BF	1181.84		
15-MM	1157.47		
27-MM	1149.95		
16-MM	1163.89		
7-BM	1156.21		
20-MB	1164.28		
21-MB	1166.94		
26-MB	1184.98		
22-MB	1188.81		
23-MB	1191.19		
24-MB	1193.60		
28-MB	1166.41		
29-MB	1193.55		
3-BB	1155.98		
5-BB	1160.46		
7-BB	1165.62		
9-BB	1182.95		
11-BB	1190.55		
13-BB	1193.98		
15-BB	1166.03		
H2O	1156.08		

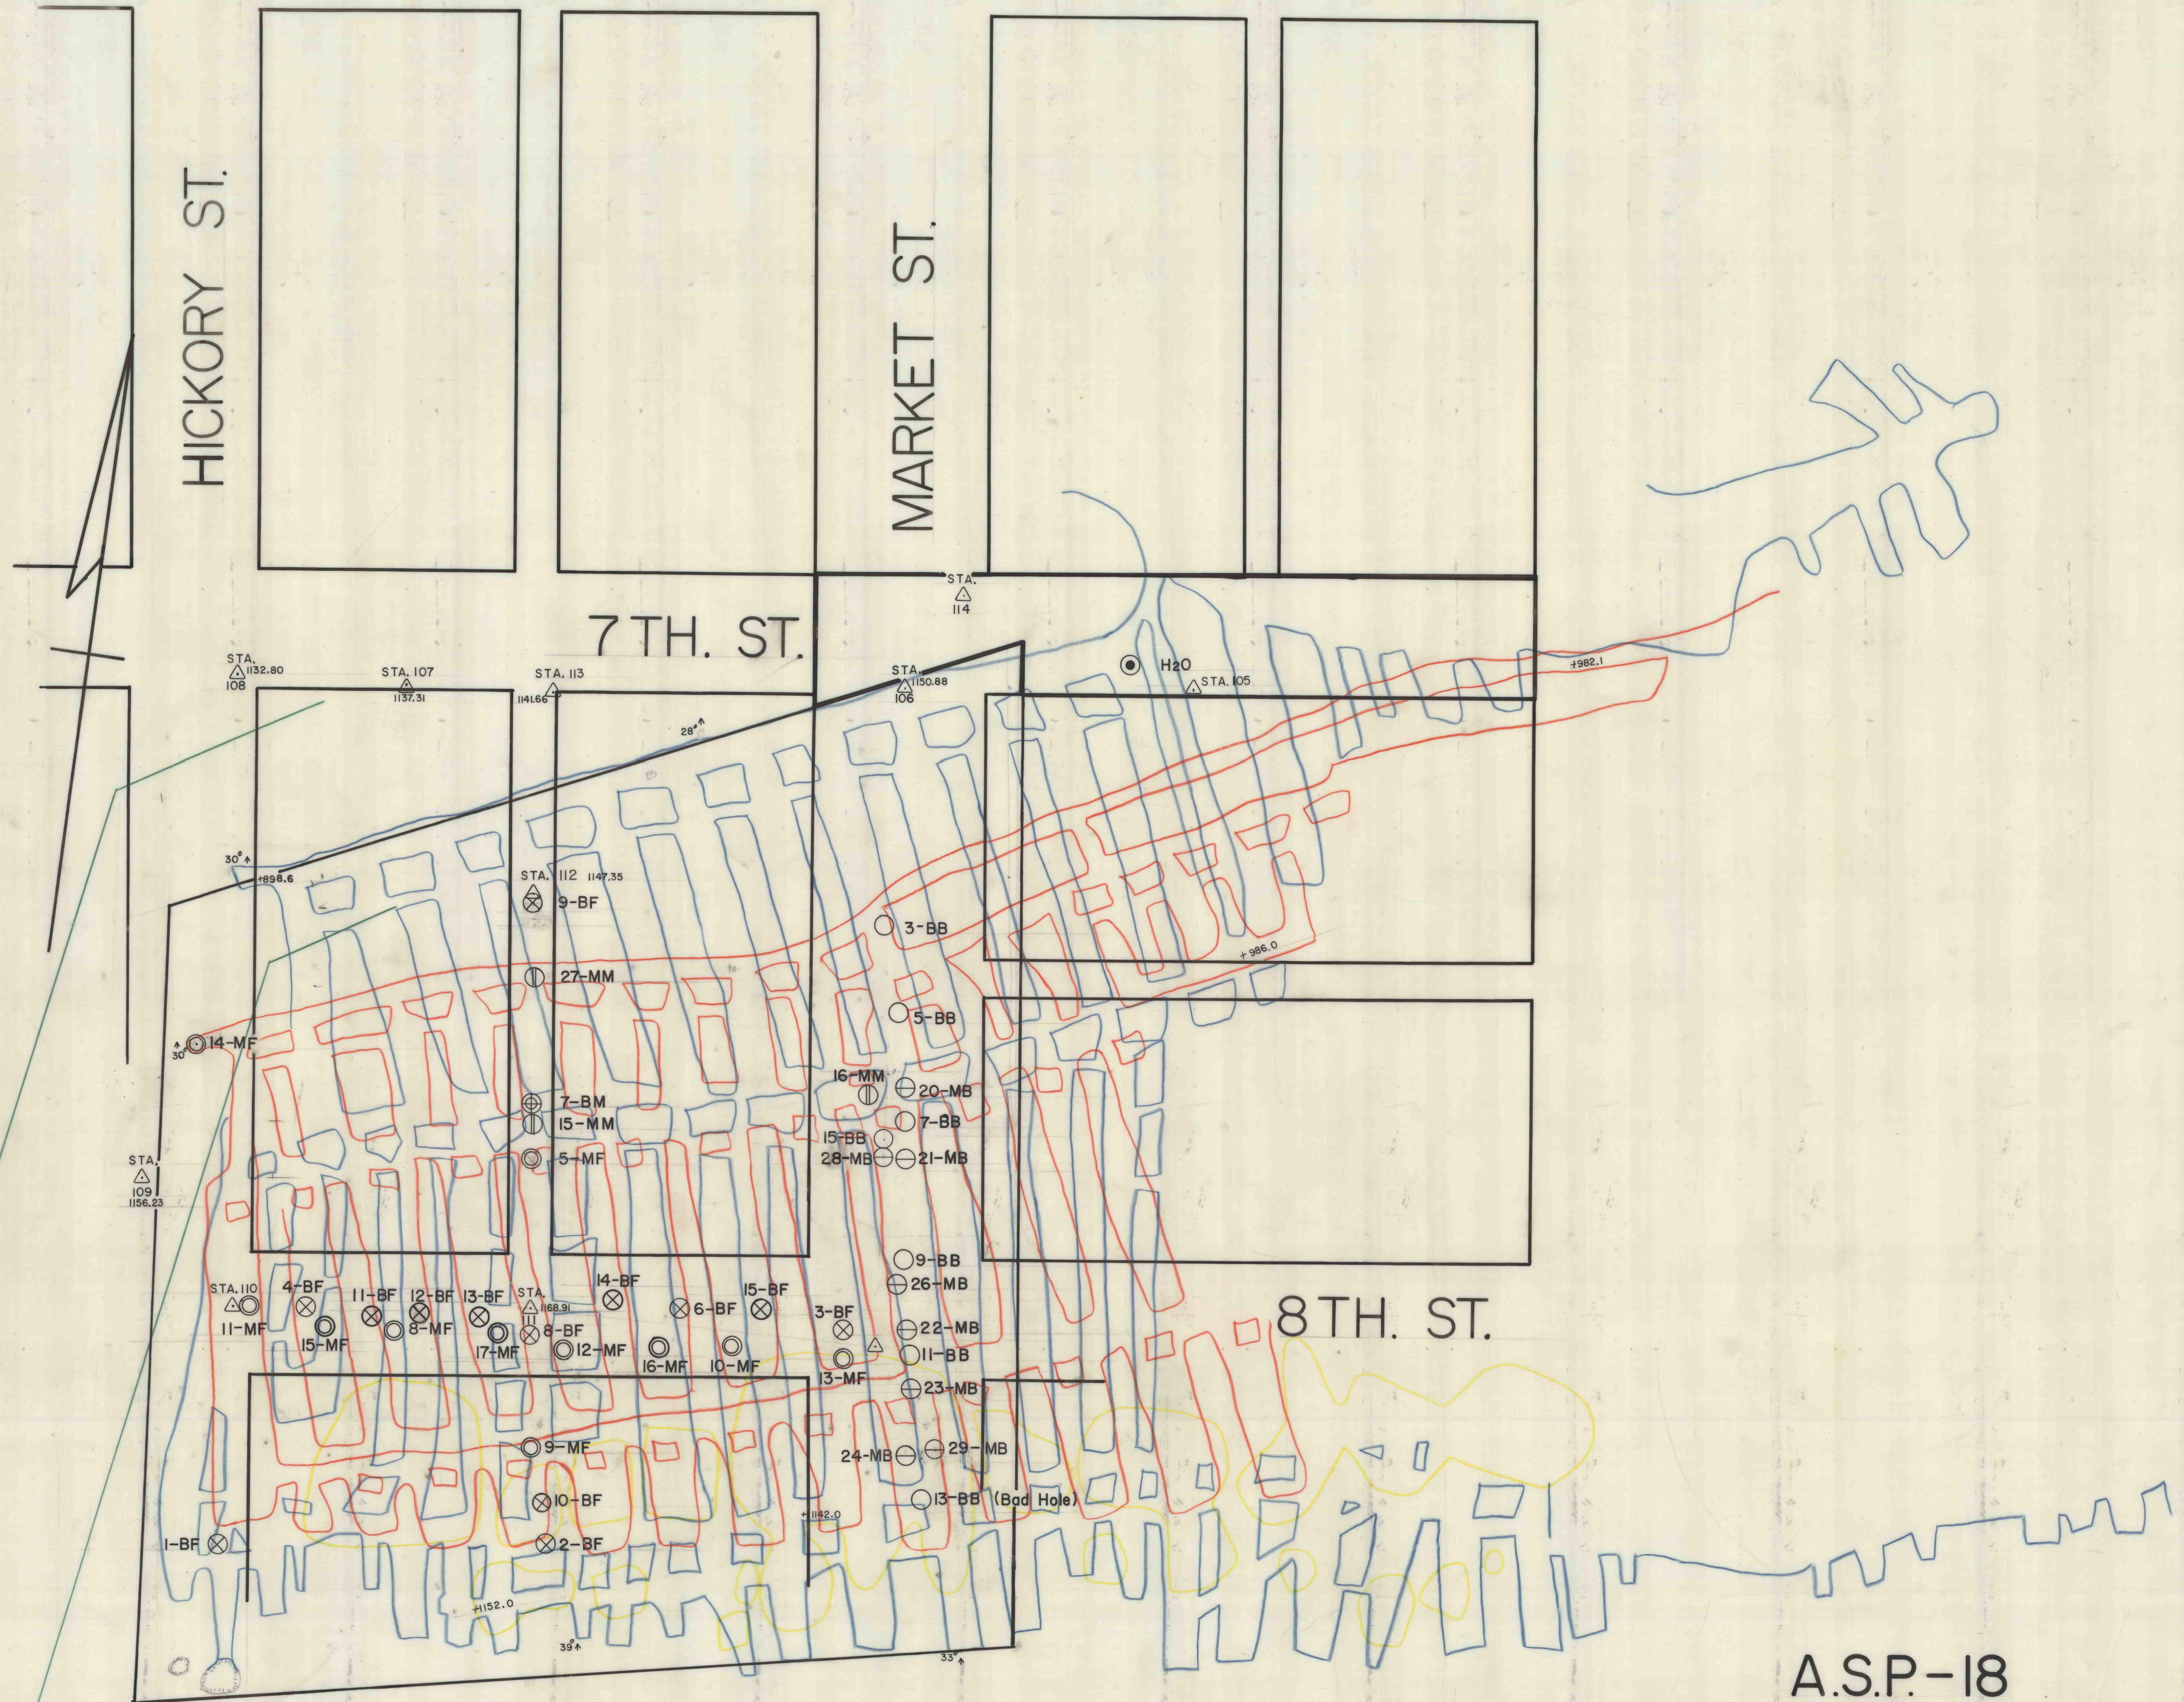

- Bottom Barrier
- ⊕ Middle Flushing
- ⊖ Middle Barrier
- ⊓ Middle Monitoring
- ⊗ Bottom Monitoring
- ⊗ Bottom Flushing
- H2O

**A.S.P-18**  
 MT. CARMEL, PA.  
 DRAWN BY: MARK D. LASKOSKI  
 SCALE: 1" = 50' DATE: 11-24-76