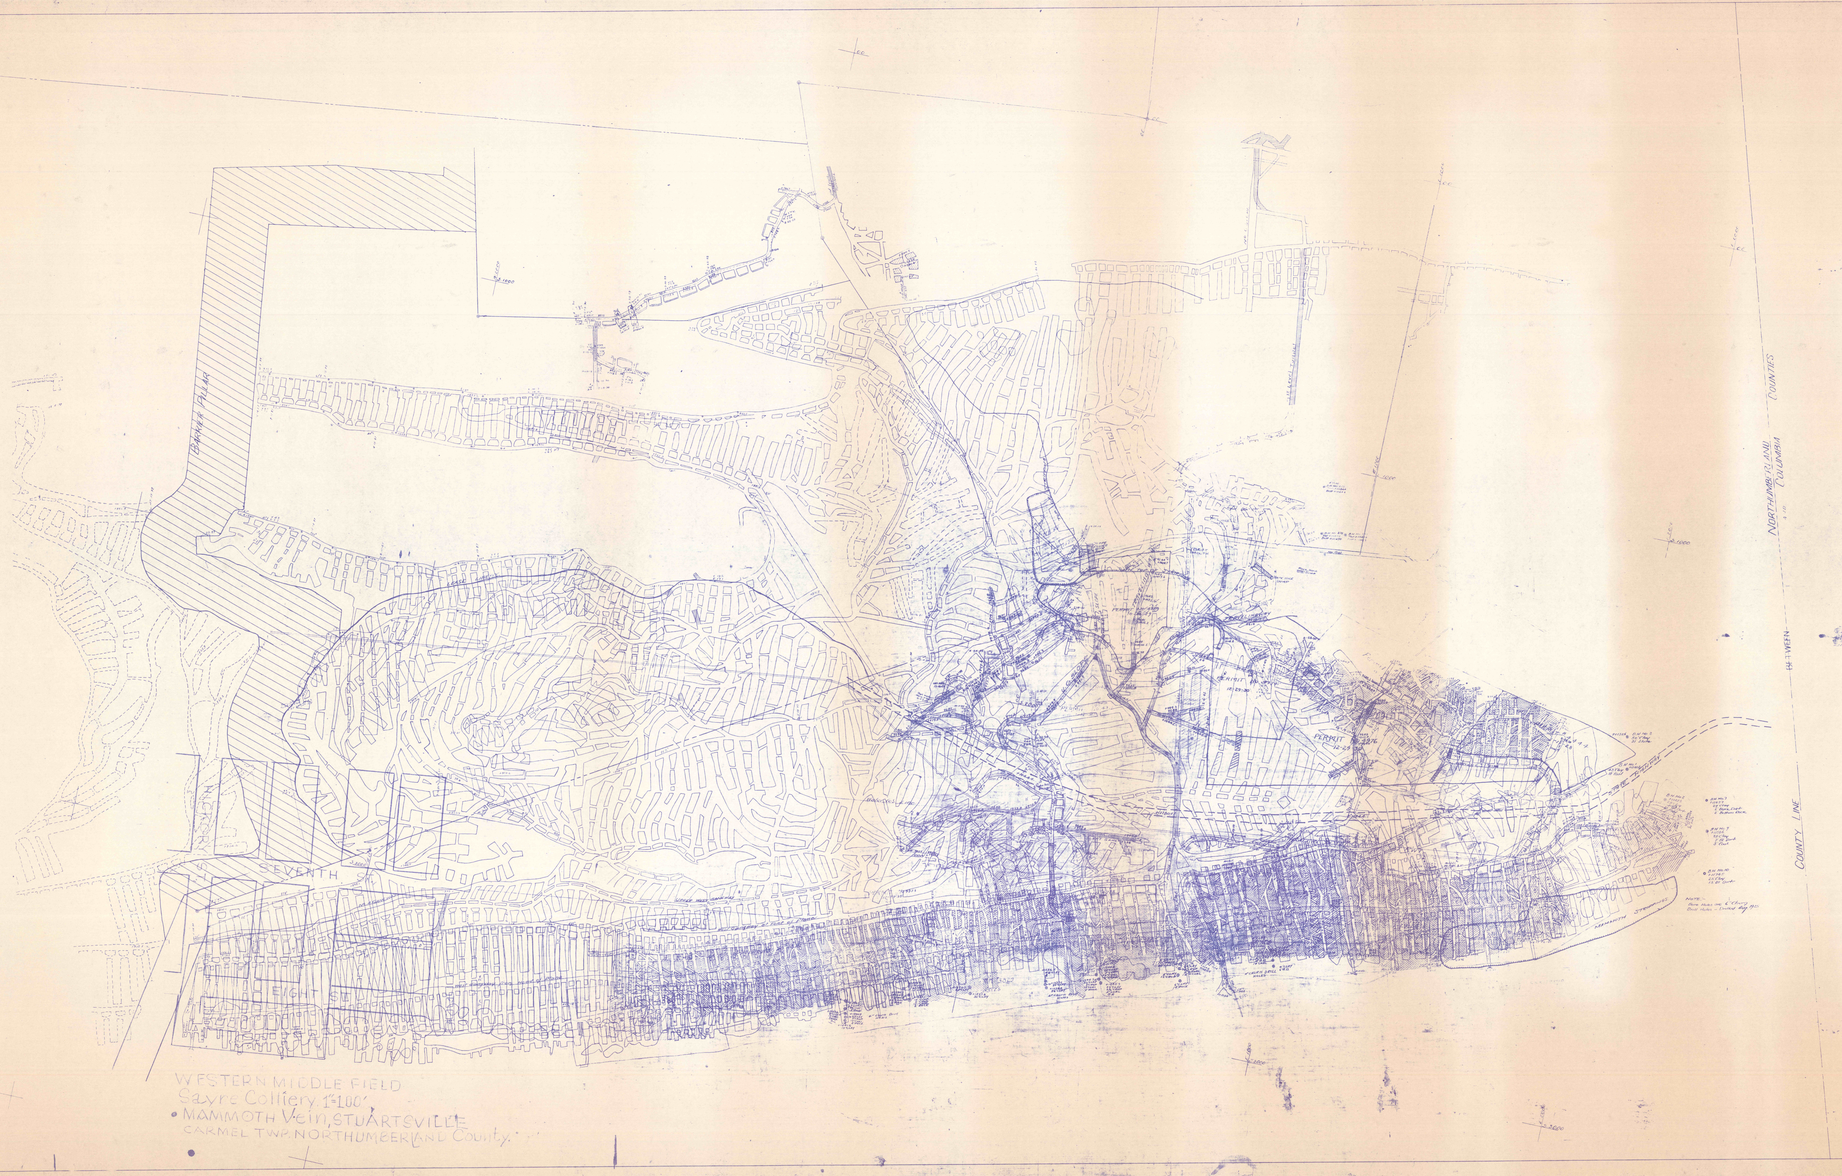

MAMMOTH VEIN
of
SAYRE COLLIERY
STUARTSVILLE


100' = 1"

MF