

1373 1998 BK North D Co
0100 100 Columbia Co

1373 1998 BK North D Co
0100 100 Columbia Co

1335	1127.00
1336	1127.24
1337	1127.65
1338	1128.07
1339	1128.71
1340	1129.84
1341	1130.06
1342	1130.23
1343	1130.45
1344	1130.54
1345	1130.75
1346	1130.88
1347	1131.03
1348	1131.14
1349	1131.24
1350	1131.34
1500	1146.34

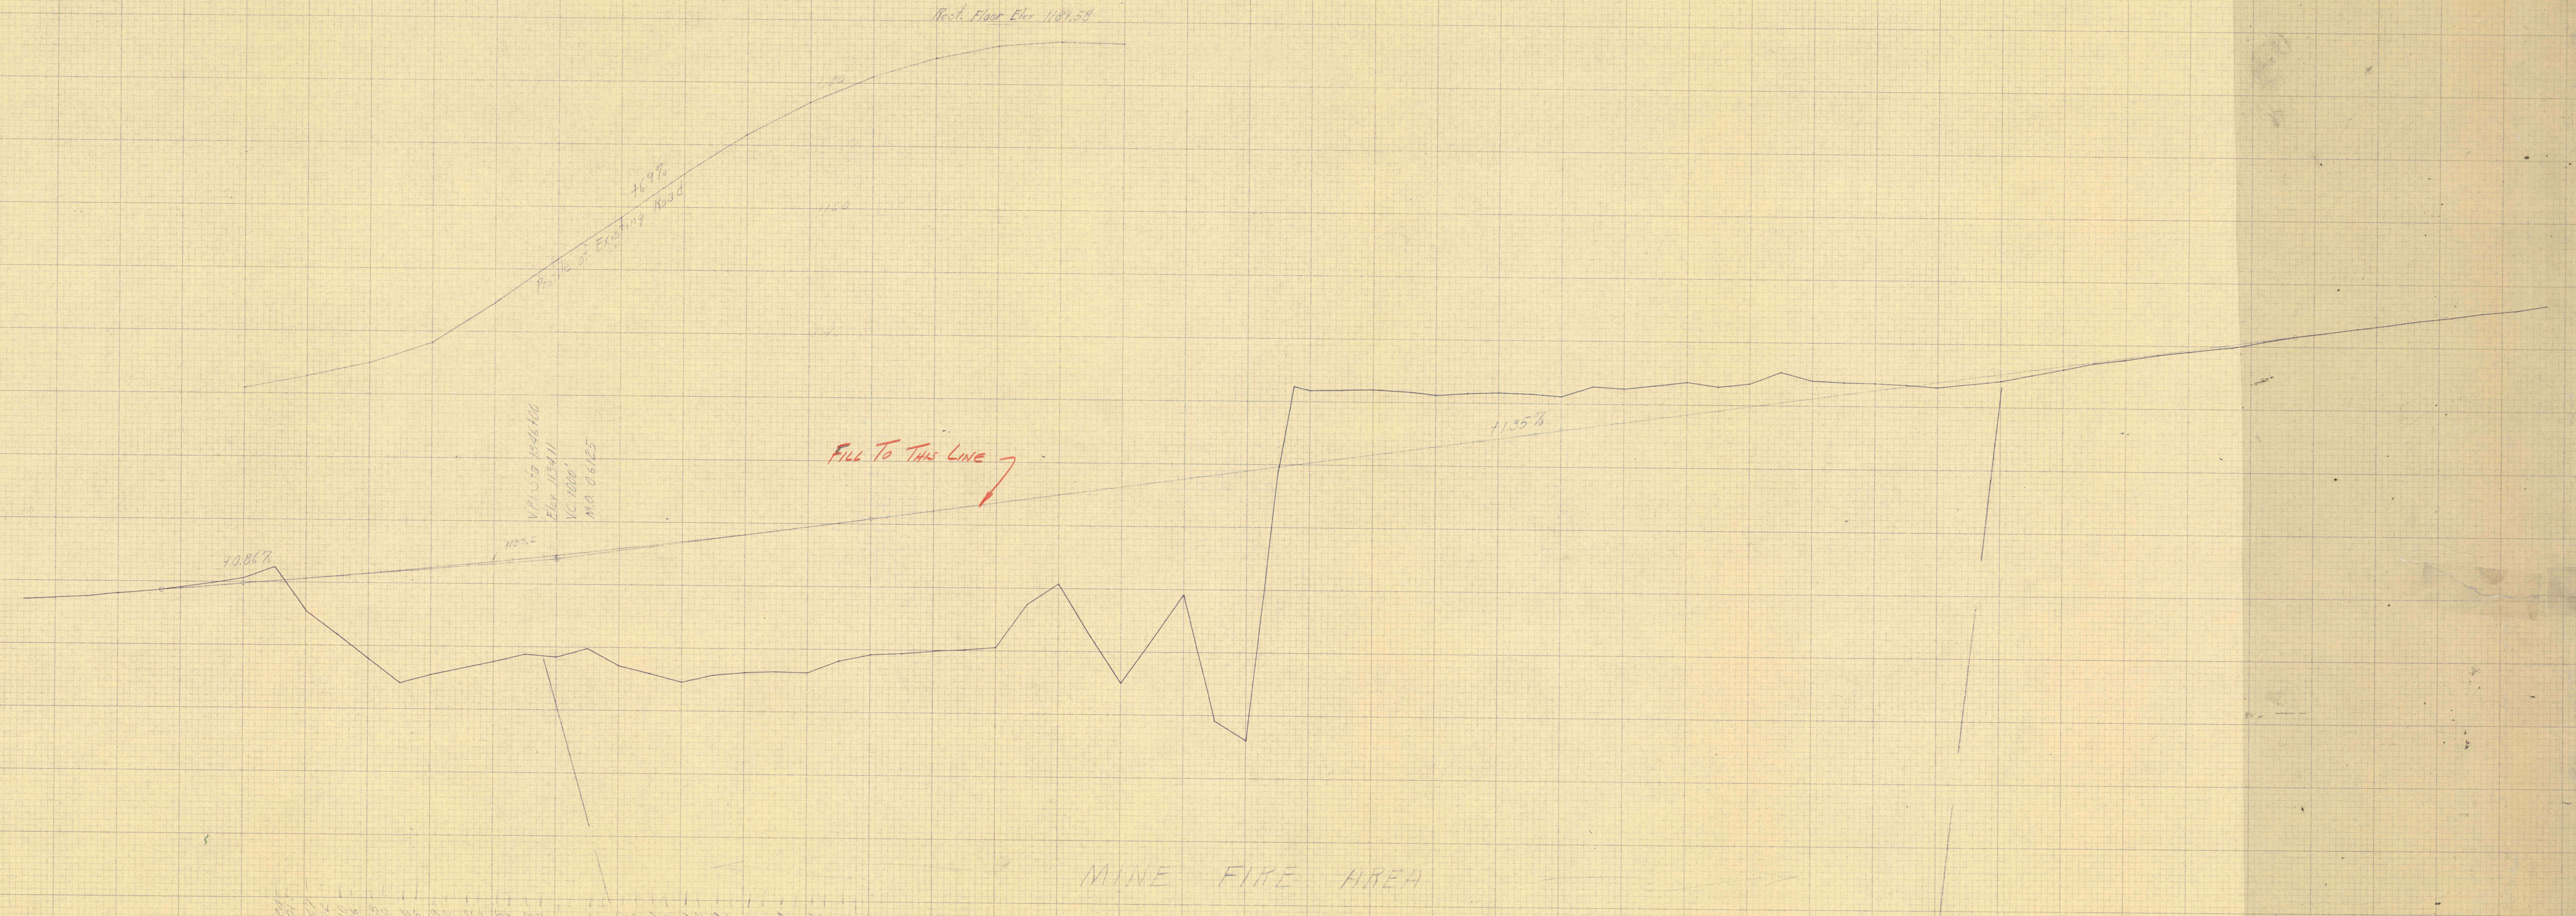

Fill To This Line

MINE FIRE AREA


16.9%
Prop. Existing Road

10.86%
MA 0.6125

1.35%

PT EOT 1370179.67 BK
1370171.93 Rhd.

1373 1998 BK North D Co
0100 100 Columbia Co